


BOUNDARY LINE SURVEY - LOCATED ALONG THE EAST LINE OF SECTION 4, T.22S., R.7W., W.M., DOUGLAS COUNTY, OREGON

FILED
 Date: 1-11-2011 By: TLW
 This survey consists of:
 Map: M 161-71
 Narrative: _____
 Corner Rpt: _____

FD. D.C.S.O. BRASS CAP & BT'S
 PER C.S. 57/17

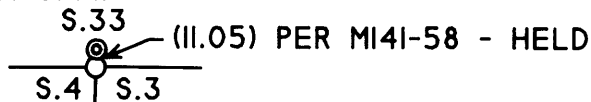

SET AMMENDED CORNER FROM WHICH:
 FD. A 12" GF (HEMLOCK) WITH A HEALED FACE - BEARS S52°E. 36.5 FT.
 FD. A 35" CEDAR WITH A HEALED FACE - BEARS S24°W. 30.7 FT.
 FD. A STEEL POST - BEARS WEST. 1.2 FT.
 NOTE: THE ABOVE BEARING TREES ALSO REFERENCE THE CLOSING CORNER


BASIS OF BEARING
 (S1°30'00"W - 2819.8) - 2818.93



BASIS OF BEARING
 ASSUMED PER M27 - 16

LEGEND

- ⊙ FD. CORNER AS SHOWN
- SET A 5/8" X 36" REBAR WITH A 2 1/2" ALUM. CAP
- LINE FLAGGED, BLAZED AND POSTED WITH 5 1/2" STEEL POSTS

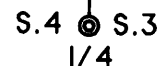

FD. A "T" IRON AND BT'S
 PER M27 - 16 AND M145 - 72
 SCRIBED "1/4 S4 BT" ON A 14" DF - BEARS S26°W. 18.2 FT.
 SCRIBED "1/4 S3 BT" ON A 13" DF - BEARS S60°E. 13.8 FT.

SURVEY FOR: **DOUGLAS COUNTY SURVEYOR**

SENECA JONES TIMBER CO.
 P.O. BOX 10265
 EUGENE, OR 97440

ROSEBURG RESOURCES CO.
 P.O. BOX 1088
 ROSEBURG, OR 97470

SURVEY BY:

MULKINS & RAMBO, LLC
 P.O. BOX 809
 NORTH BEND, OR 97459

REGISTERED
 PROFESSIONAL
 LAND SURVEYOR

Troy Rambo
 OREGON
 JULY 14, 1998
 TROY J. RAMBO
 2865

RENEWAL 12-31-12

JANUARY 6, 2011
 SCALE 1" = 400'

NARRATIVE

THE PURPOSE OF THIS SURVEY WAS TO MARK THE LINE BETWEEN THE EXISTING CORNERS, AS SHOWN, FOR FUTURE FOREST OPERATIONS. CONTROL FOR THIS SURVEY WAS BASED ON M27 - 16 AND M141 - 58.
 THE RECORD OFFSET DISTANCE PER M141 - 58 WAS HELD TO SET THE AMMENDED SECTION CORNER AS SHOWN.
 THE NEW BEARING TREE WAS MEASURED TO A 40D SPIKE AT SIDE CENTER BASE. THE BEARING WAS MEASURED WITH A HAND COMPASS WITH A DECLINATION OF 17°E.
 THE FIELD WORK WAS PERFORMED BETWEEN DECEMBER 23, 2010 AND JANUARY 5, 2011 WITH THE ASSISTANCE OF CLYDE MULKINS AND FORREST RAMBO.

MAP FILE M 161-71

MAP FILE M 161-71