

# MAP OF SURVEY

LOCATED in the NE 1/4 of Section 19, T. 27 S., R. 5 W., W.M.  
in Douglas County, Oregon.


July 23, 2011

FILED  
Date: 8/2/2011 By: DEW  
This survey consists of:  
Map: M 162-55  
Narrative: \_\_\_\_\_  
Corner Rpt: \_\_\_\_\_

DOUGLAS COUNTY  
SURVEYOR

SURVEYED FOR: *SENECA JONES TIMBER CO.*  
P.O. BOX 2129  
ROSEBURG, OREGON 97470

SURVEYED BY: *DAVID EDWARDS LAND SURVEYING*  
P.O. BOX 361  
OAKLAND, OREGON 97462  
PHONE: (541) 459-0512

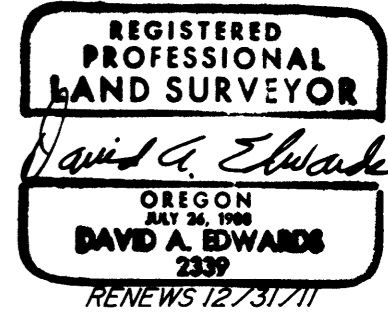

### LEGEND

- INDICATES 1/2" DIAM. IRON ROD FOUND PER M 65-17 OR M 69-70.
  - INDICATES 5/8" DIAM. IRON ROD FOUND PER M 69-59.
  - ▲ INDICATES 3/4" DIAM. IRON ROD FOUND PER M 12-38.
  - INDICATES 5/8" X 30" STEEL REBAR W/RED PLASTIC CAP MKD. "D.A. EDWARDS-LS 2339" SET.
  - ( ) RECORD DATA AS NOTED. W.M. = WITNESS MONUMENT.
  - X—X—X FENCE LINE. SCALE: 1" = 50'
- BASIS OF BEARINGS: M 69-70 AS SHOWN.

### NARRATIVE

THE PURPOSE OF THIS SURVEY IS TO RETRACE AND REMONUMENT THE BOUNDARY BETWEEN DOC. NO. 2003-8391 AND DOC. NO. 1992-17583. I UTILIZE THE FOUND MONUMENTS, FENCE EVIDENCE AND RECORD DATA TO COMPUTE THE SOUTH LINE OF THORNTON'S ADDITION. I THEN HOLD TO THE FOUND 3/4" DIAM. IRON ROD AND USE DEED RECORD ANGLES AND DISTANCES TO COMPUTE THE SUBJECT BOUNDARY. THE OLD 1 1/2" DIAM. IRON PIPE WHICH PREVIOUSLY MONUMENTED THE SW CORNER OF THORNTON'S ADDITION APPEARS TO HAVE BEEN DESTROYED BY SEWER LINE CONSTRUCTION.

FIELD CREW: DAVID EDWARDS AND BRANT MILLER.

EQUIPMENT: NIKON TOTAL STATION.

COMPUTATIONS AND DRAFTING: DAVID EDWARDS.

