

MAP FILE M163-56

FILED
 Date: 5/22/2012 By: JC
 This survey consists of:
 Map: M163-56
 Narrative:
 Corner Rpt:
 DOUGLAS COUNTY SURVEYOR

N89°48'55"E 2596.96' (N89°49'55"E 2597.62')

C 1/4 COR.
 FD. OREGON STATE BOARD
 OF FORESTRY BRONZE CAP
 AND B.T.'s PER M54-60

FD. OREGON STATE BOARD OF FORESTRY
 1.5" DIA. GALV. IRON PIPE WITH 3" DIA. BRONZE CAP.

E 1/4 COR.
 FD. OREGON STATE BOARD
 OF FORESTRY BRONZE CAP
 AND B.T.'s PER M54-60

N00°00'48"E 1291.99'
 (N00°00'48"E 1292.28')
 BASIS OF BEARINGS

CS 1/16 COR.
 FD. OREGON STATE BOARD
 OF FORESTRY BRONZE CAP
 AND B.T.'s PER M54-60

SE1/4 SEC. 8
 154.94 Acres

N00°03'51"E 1292.20'
 (N00°00'48"E 1292.27')

C 1/4 COR.
 FD. DOUGLAS COUNTY
 BRASS CAP & B.T. STUMPS

(ORIG.) 33" D. FIR STUMP, S40°W, 6.6'
 (MEASURED FROM ORIG. FACE)

(1967) 20" D. FIR STUMP, N44°W, 42.0'
 (SLOPE DIST. FROM CENTER OF STUMP)

SCRIBED:
 (NEW) 9" D. FIR BEARS N82°15'W, 32.2'(B.T. TAG)
 (NEW) 8" D. FIR BEARS N19°E, 16.6'(B.T. TAG)
 (MEASURED HORIZONTAL FROM SIDE-CENTER)

SEC. COR.
 FD. DOUGLAS COUNTY
 BRASS CAP & B.T.'S

N00°24'03"W 2602.53'
 (N00°24'18"W 2602.33')

17

S89°47'16"E 2617.10' (S89°46'27"E 2616.44')

17 16

MAP OF SURVEY
 (PLUM CREEK - WOODS CREEK 8 SURVEY)
 SHOWING RETRACEMENT SITUATED
 IN THE SE1/4 OF SEC. 8, T.32S.,
 R.6W., W.M., DOUGLAS COUNTY,
 OREGON.

LEGEND

- FOUND OREGON STATE BOARD OF FORESTRY BRONZE CAP.
- ⊙ FOUND DOUGLAS COUNTY SURVEYOR BRASS CAP.
- () RECORD PER MAP FILE M54-60. (1974 SURVEY)
- LINE POSTED WITH METAL POST AND MARKED WITH BLAZES PAINTED FLO-RED AND FLAGGED WITH FLO-RED RIBBON.

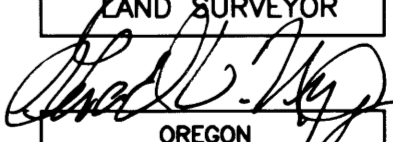
BEARINGS BASED ON M54-60 (1974 SURVEY)

SURVEY NARRATIVE

THE PURPOSE IS TO SURVEY AND MARK FOR LOGGING THE BOUNDARY LINES AROUND THE SOUTHEAST QUARTER OF SAID SECTION 8, WHICH WERE PREVIOUSLY ESTABLISHED IN 1974 BY ARNOLD GIBSON AND RECORDED ON MAP FILE M54-60 IN THE DOUGLAS COUNTY SURVEYOR'S OFFICE.

I RECOVERED AND HELD TO MONUMENTS FOUND OR SET PER ARNOLD GIBSON'S 1974 SURVEY, WHICH WERE FOUND AS SHOWN ON ANNEXED MAP. THENCE I MARKED LINES AS SHOWN ON ANNEXED MAP.

A NIKON DTM-A20LG TOTAL STATION WAS USED TO EXECUTE THIS SURVEY.

REGISTERED
 PROFESSIONAL
 LAND SURVEYOR

 OREGON
 GERALD V. NYGREN
 AUGUST 22, 1975
 1035
 RENEW: 12-31-12

SURVEYED FOR: PLUM CREEK TIMBER LANDS, L.P. P.O. BOX 1528 COOS BAY, OREGON 97420	GERALD V. NYGREN 522 BARKER DRIVE MERLIN, OREGON 97532	DATE: MAY 10, 2012 SCALE: 1" = 200' JOB NO. 12-03A
---	---	--

THIS PLAT WAS PREPARED WITH A HEWLETT-PACKARD DESIGNJET 500 USING HP NO. C4844A INKJET INK ON MILANO NO. JPC4M2 POLYESTER FILM

MAP FILE M163-56