

MAP OF SURVEY

LOCATED in Sections 4 and 5, T. 23 S., R. 5 W., W.M. in Douglas County, Oregon.



July 8, 2013

FILED
Date: 7-12-2013 By: JC
The survey consists of:
Map: M165-45A & B
Name: _____
Corner Rpt: _____

DOUGLAS COUNTY
SURVEYOR

SURVEYED FOR: SCOTT HERNANDEZ
1100 MATHIS HILL ROAD
YONCALLA, OREGON 97499

SURVEYED BY: DAVID EDWARDS LAND SURVEYING
P.O. BOX 361
OAKLAND, OREGON 97462
PHONE: (541) 459-0512

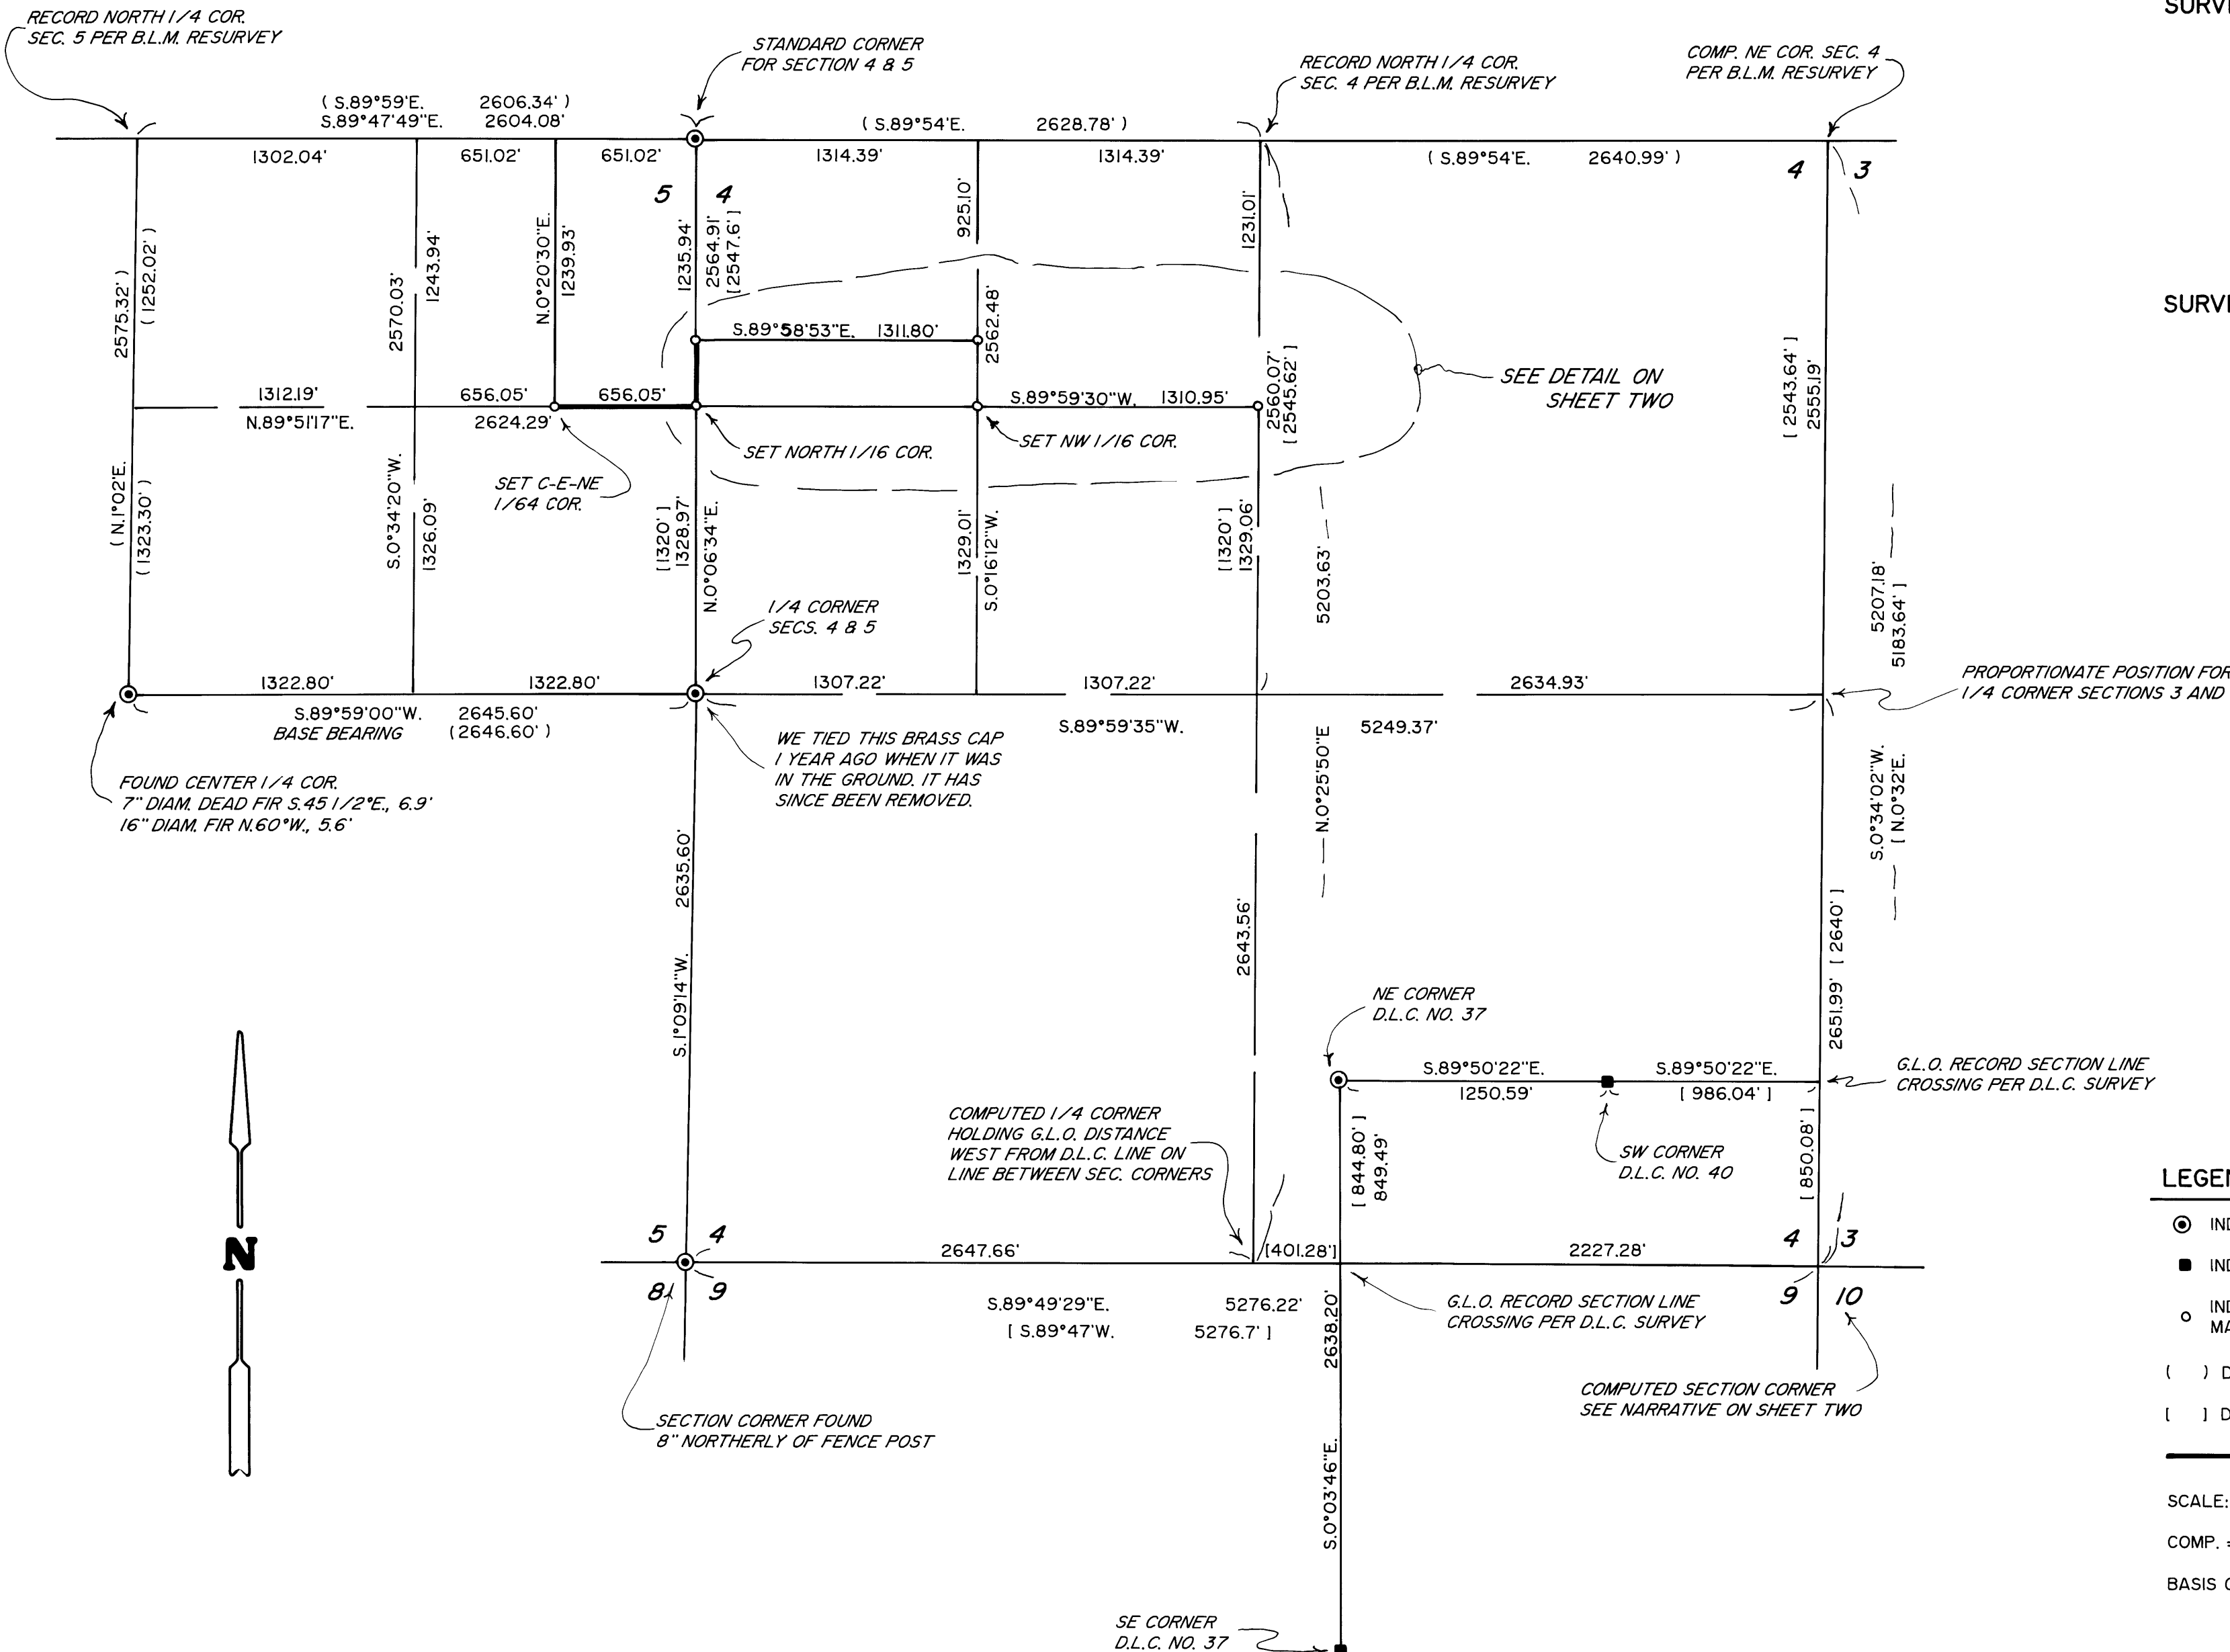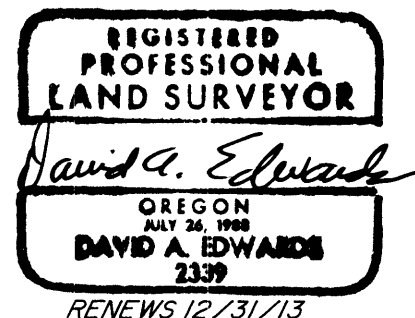

LEGEND

- ⊙ INDICATES B.L.M. OR COUNTY SURVEYOR BRASS CAP FOUND
- INDICATES STONE MONUMENT FOUND.
- INDICATES 5/8" X 30" STEEL REBAR WITH RED PLASTIC CAP MARKED "D.A. EDWARDS-LS 2339" SET.
- () DENOTES B.L.M. RESURVEY RECORD DATA UNLESS NOTED OTHERWISE.
- [] DENOTES ORIGINAL G.L.O. DATA.
- INDICATES BOUNDARY MARKED THIS SURVEY.

SCALE: 1" = 600'

COMP. = COMPUTED.

BASIS OF BEARINGS: B.L.M. SURVEY IN SECTION 5 AS SHOWN.

MAP FILE M165-45A

MAP FILE M165-45A

