



RECORD OF SURVEY

REVISED SEE M166-35 A-H

LOCATED IN
THE NW 1/4, THE NE 1/4 AND THE SE 1/4 OF SECTION 8
TOWNSHIP 32 SOUTH, RANGE 2 WEST, W.M.
DOUGLAS COUNTY, OREGON

FILED
Date: 12-4-2014 By: J.C.
This survey consists of:
Map: M166-25 A-H
Narrative:
Corner 1 sp:

**DOUGLAS COUNTY
SURVEYOR**

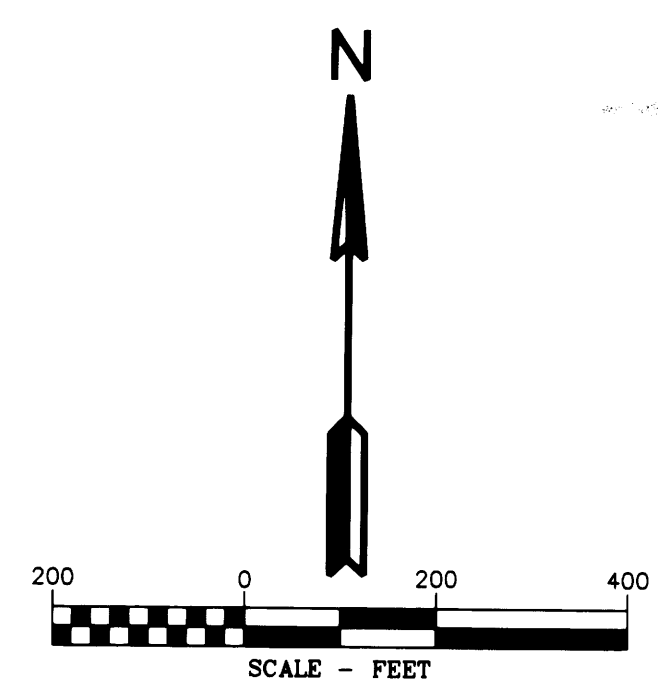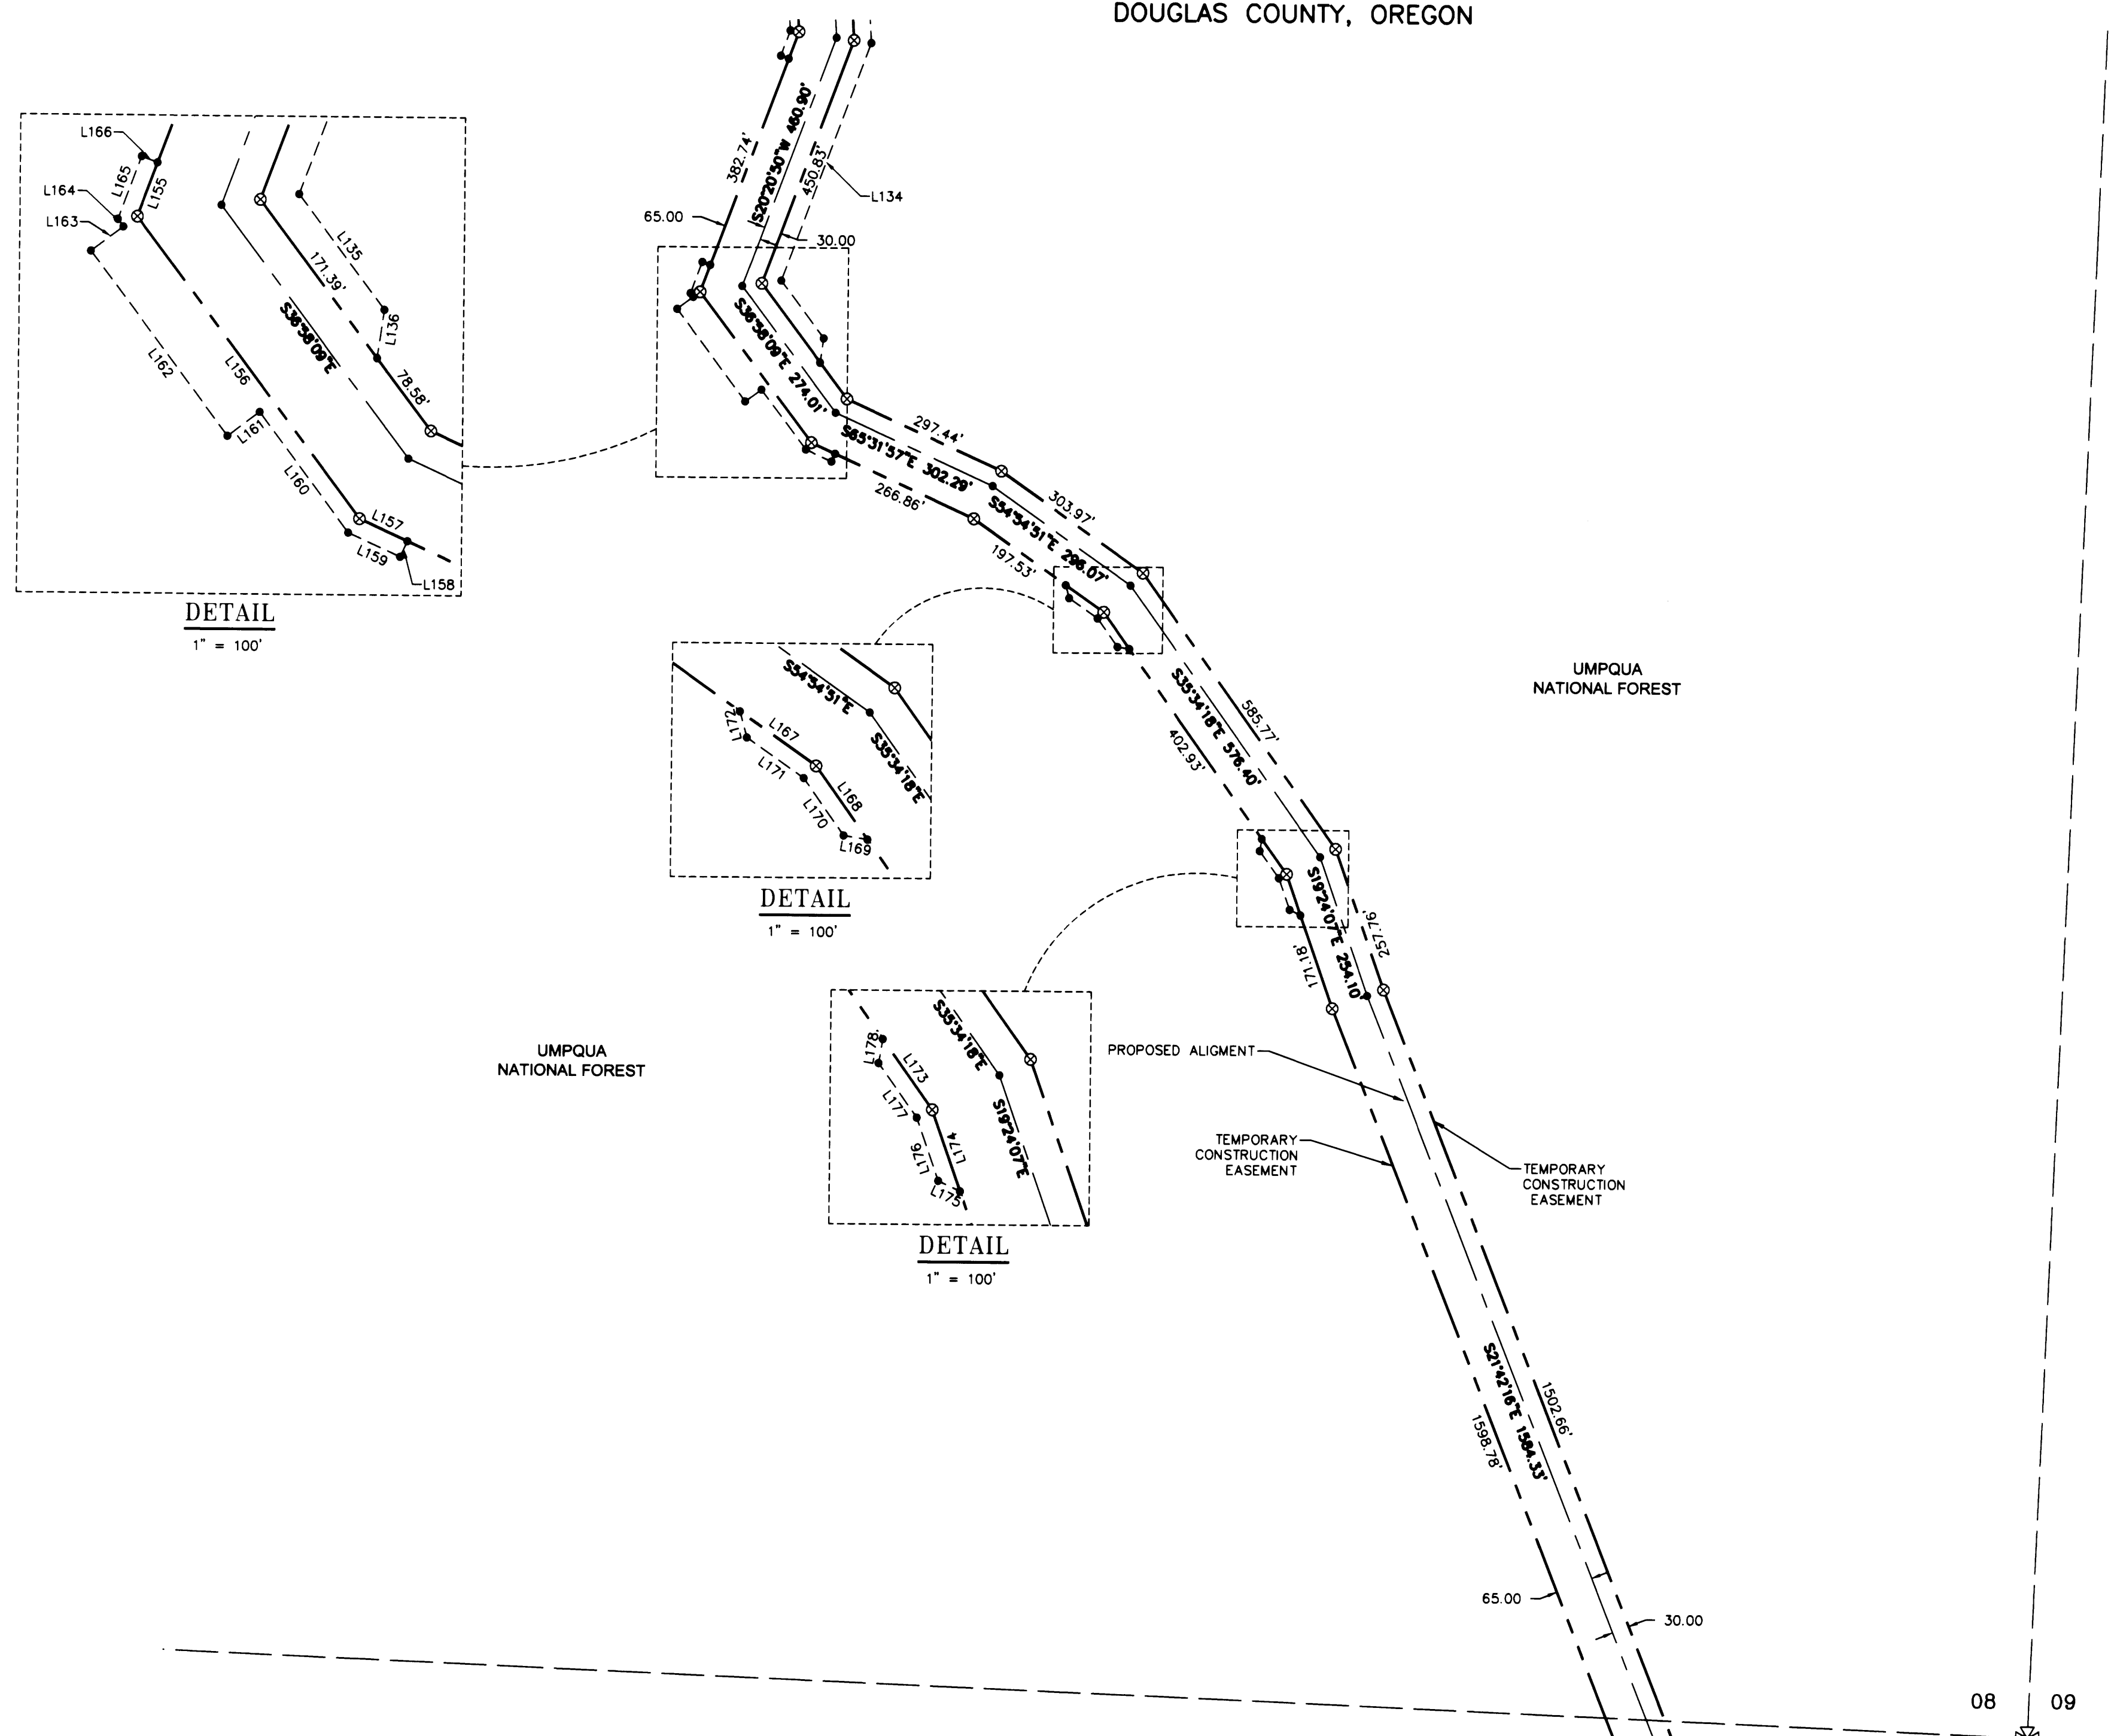

LINE TABLE

Line #	Direction	Length
L155	S20°20'50"W	50.00
L156	N36°58'09"W	326.08
L157	S65°31'57"E	45.93
L158	S24°27'10"W	14.99
L159	N65°32'50"W	49.75
L160	N36°58'09"W	129.91
L161	S53°01'51"W	35.00
L162	N36°58'09"W	200.00
L163	N53°01'51"E	35.00
L164	N36°58'09"W	8.20
L165	N20°20'50"E	58.20
L166	S69°39'10"E	15.00
L167	S54°54'51"E	81.42
L168	S35°34'18"E	78.16
L169	S80°34'17"E	21.21
L170	S35°34'18"E	60.62
L171	S54°53'48"E	60.77
L172	S15°16'43"E	23.48
L173	S35°34'18"E	75.00
L174	S19°24'07"E	75.00
L175	S64°24'08"E	21.21
L176	S19°24'07"E	57.87
L177	S35°34'18"E	57.87
L178	S9°25'43"W	21.21

LEGEND

- SET 5/8" X 24" REBAR WITH 1 1/4" YELLOW PLASTIC CAP (KLEIN & ASSOC. PLS 59002)
- ⊗ SET 5/8" X 24" REBAR WITH 1 1/4" YELLOW PLASTIC CAP (DYER PARTNER LS 2340)
- ⊙ FOUND MONUMENT OF RECORD, SEE CORNER NOTES
- COMPUTED POINT, NOT MONUMENTED
- ⊠ FOUND QUARTER CORNER SEE CORNER NOTES
- ⊞ FOUND SECTION CORNER SEE CORNER NOTES
- ⊠ COMPUTED QUARTER CORNER
- ⊞ COMPUTED SECTION CORNER
- ① POINT NUMBER
- PROPOSED ALIGNMENT
- TEMPORARY CONSTRUCTION EASEMENT
- TEMPORARY WORK AREA

REGISTERED PROFESSIONAL LAND SURVEYOR
Michael W. Erickson
OREGON
JULY 28, 1988
MICHAEL W. ERICKSON
2340
Expires 12-31-2015

REGISTERED PROFESSIONAL LAND SURVEYOR
James M. Klein
OREGON
JULY 12, 2009
JAMES M. KLEIN
59002
Expires 6-30-2015

D THE DYER PARTNERSHIP ENGINEERS & PLANNERS, INC.
1330 Teakwood Avenue / Coos Bay, Oregon 97420
(541) 269-0732 / WWW.DYERPART.COM

KA Klein & Associates, Inc.
ENGINEERING • SURVEYING • PLANNING
1411 13th Street • Hood River, OR 97031
TEL: 541-386-3322 • FAX: 541-386-2515

PACIFIC CONNECTOR GAS PIPELINE PROJECT
PACIFIC CONNECTOR GAS PIPELINE, LP
RECORD OF SURVEY
SECTION 08
TOWNSHIP 32 SOUTH, RANGE 2 WEST, W.M.
DOUGLAS COUNTY OREGON

Pacific Connector
GAS PIPELINE

DRAWN BY: LJS	DATE: 09-10-2014	ISSUED FOR BID:	SCALE: 1" = 200'
CHECKED BY:	DATE:	ISSUED FOR CONSTRUCTION:	
APPROVED BY:	DATE:	DRAWING NUMBER:	SHEET 5 OF 8