

MAP FILE M167-22

FILED  
Date: 2/7/2014 By: JC  
This survey consists of:  
Map: M167-22  
Narrative:  
Corner Rpt:

DOUGLAS COUNTY  
SURVEYOR

**NARRATIVE**

THE PURPOSE OF THIS SURVEY IS TO MONUMENT THE NORTH AND SOUTH QUARTER CORNERS OF SECTION 26, TOWNSHIP 32 SOUTH, RANGE 8 WEST AND MARK THE LINES AS SHOWN. THE PROCEDURE WAS AS FOLLOWS:


MONUMENTS OF RECORD WERE TIED AND HELD AS SHOWN. THE NORTH AND SOUTH QUARTER CORNERS WERE SET AT MIDPOINT BETWEEN THE FOUND SECTIONS CORNERS BASED ON THE ORIGINAL GLO PLAT DATED NOVEMBER 8, 1883. BOUNDARIES WERE BLAZED, FLAGGED, AND POSTED AS SHOWN HEREON.

**NOTES**

- ① FOUND BRASS CAP & ACCESSORIES PER DOUGLAS COUNTY SURVEYOR'S OFFICE PLSS CORNER RENEWAL NOTES (500300)
- ② FOUND BRASS CAP & ACCESSORIES PER DOUGLAS COUNTY SURVEYOR'S OFFICE PLSS CORNER RENEWAL NOTES (600300)
- ③ FOUND BRASS CAP & ACCESSORIES PER DOUGLAS COUNTY SURVEYOR'S OFFICE PLSS CORNER RENEWAL NOTES (600200)
- ④ FOUND BRASS CAP & ACCESSORIES PER DOUGLAS COUNTY SURVEYOR'S OFFICE PLSS CORNER RENEWAL NOTES (500200)
- ⑤ FOUND BRASS CAP & ACCESSORIES PER DOUGLAS COUNTY SURVEYOR'S OFFICE PLSS CORNER RENEWAL NOTES (500240)
- ⑥ SET 5/8-INCH BY 30 INCH IRON ROD WITH 2" ALUMINUM CAP MARKED "ROSEBURG RESOURCES COMPANY" FROM WHICH:  
18" CHINQUAPIN BLAZED & SCRIBED "BT 1/4 S26" BEARS N38°E, 10.8 FEET  
  
10" FIR BLAZED & SCRIBED "BT 1/4 S26" BEARS N53°W, 47.9 FEET  
  
10" CHINQUAPIN BLAZED & SCRIBED "BT 1/4 S35" BEARS S51°W, 38.4 FEET  
  
11" CHINQUAPIN BLAZED & SCRIBED "BT 1/4 S35" BEARS S21°W, 10.1 FEET
- ⑦ SET 5/8-INCH BY 30 INCH IRON ROD WITH 2" ALUMINUM CAP MARKED "ROSEBURG RESOURCES COMPANY" FROM WHICH:  
21" FIR BLAZED & SCRIBED "BT 1/4 S26" BEARS S40°E, 36.6 FEET  
  
8" FIR BLAZED & SCRIBED "BT 1/4 S26" BEARS S6°W, 8.8 FEET  
  
7" FIR BLAZED & SCRIBED "BT 1/4 S23" BEARS N22°E, 31.5 FEET  
  
36" FIR BLAZED & SCRIBED "BT 1/4 S23" BEARS N75°W, 44.0 FEET

**LEGEND**

- FOUND BRASS CAP AS NOTED
- SET 5/8" IRON ROD w/YELLOW PLASTIC CAP STAMPED "i.e. ENG"
- ++++ LINE BLAZED, FLAGGED, AND POSTED WITH ALUMINUM POSTS
- ( )R1 RECORD PER GLO PLAT DATED NOVEMBER 8, 1883
- ( )R2 RECORD PER BLM DEPENDENT RESURVEY DATED DECEMBER 18, 2008

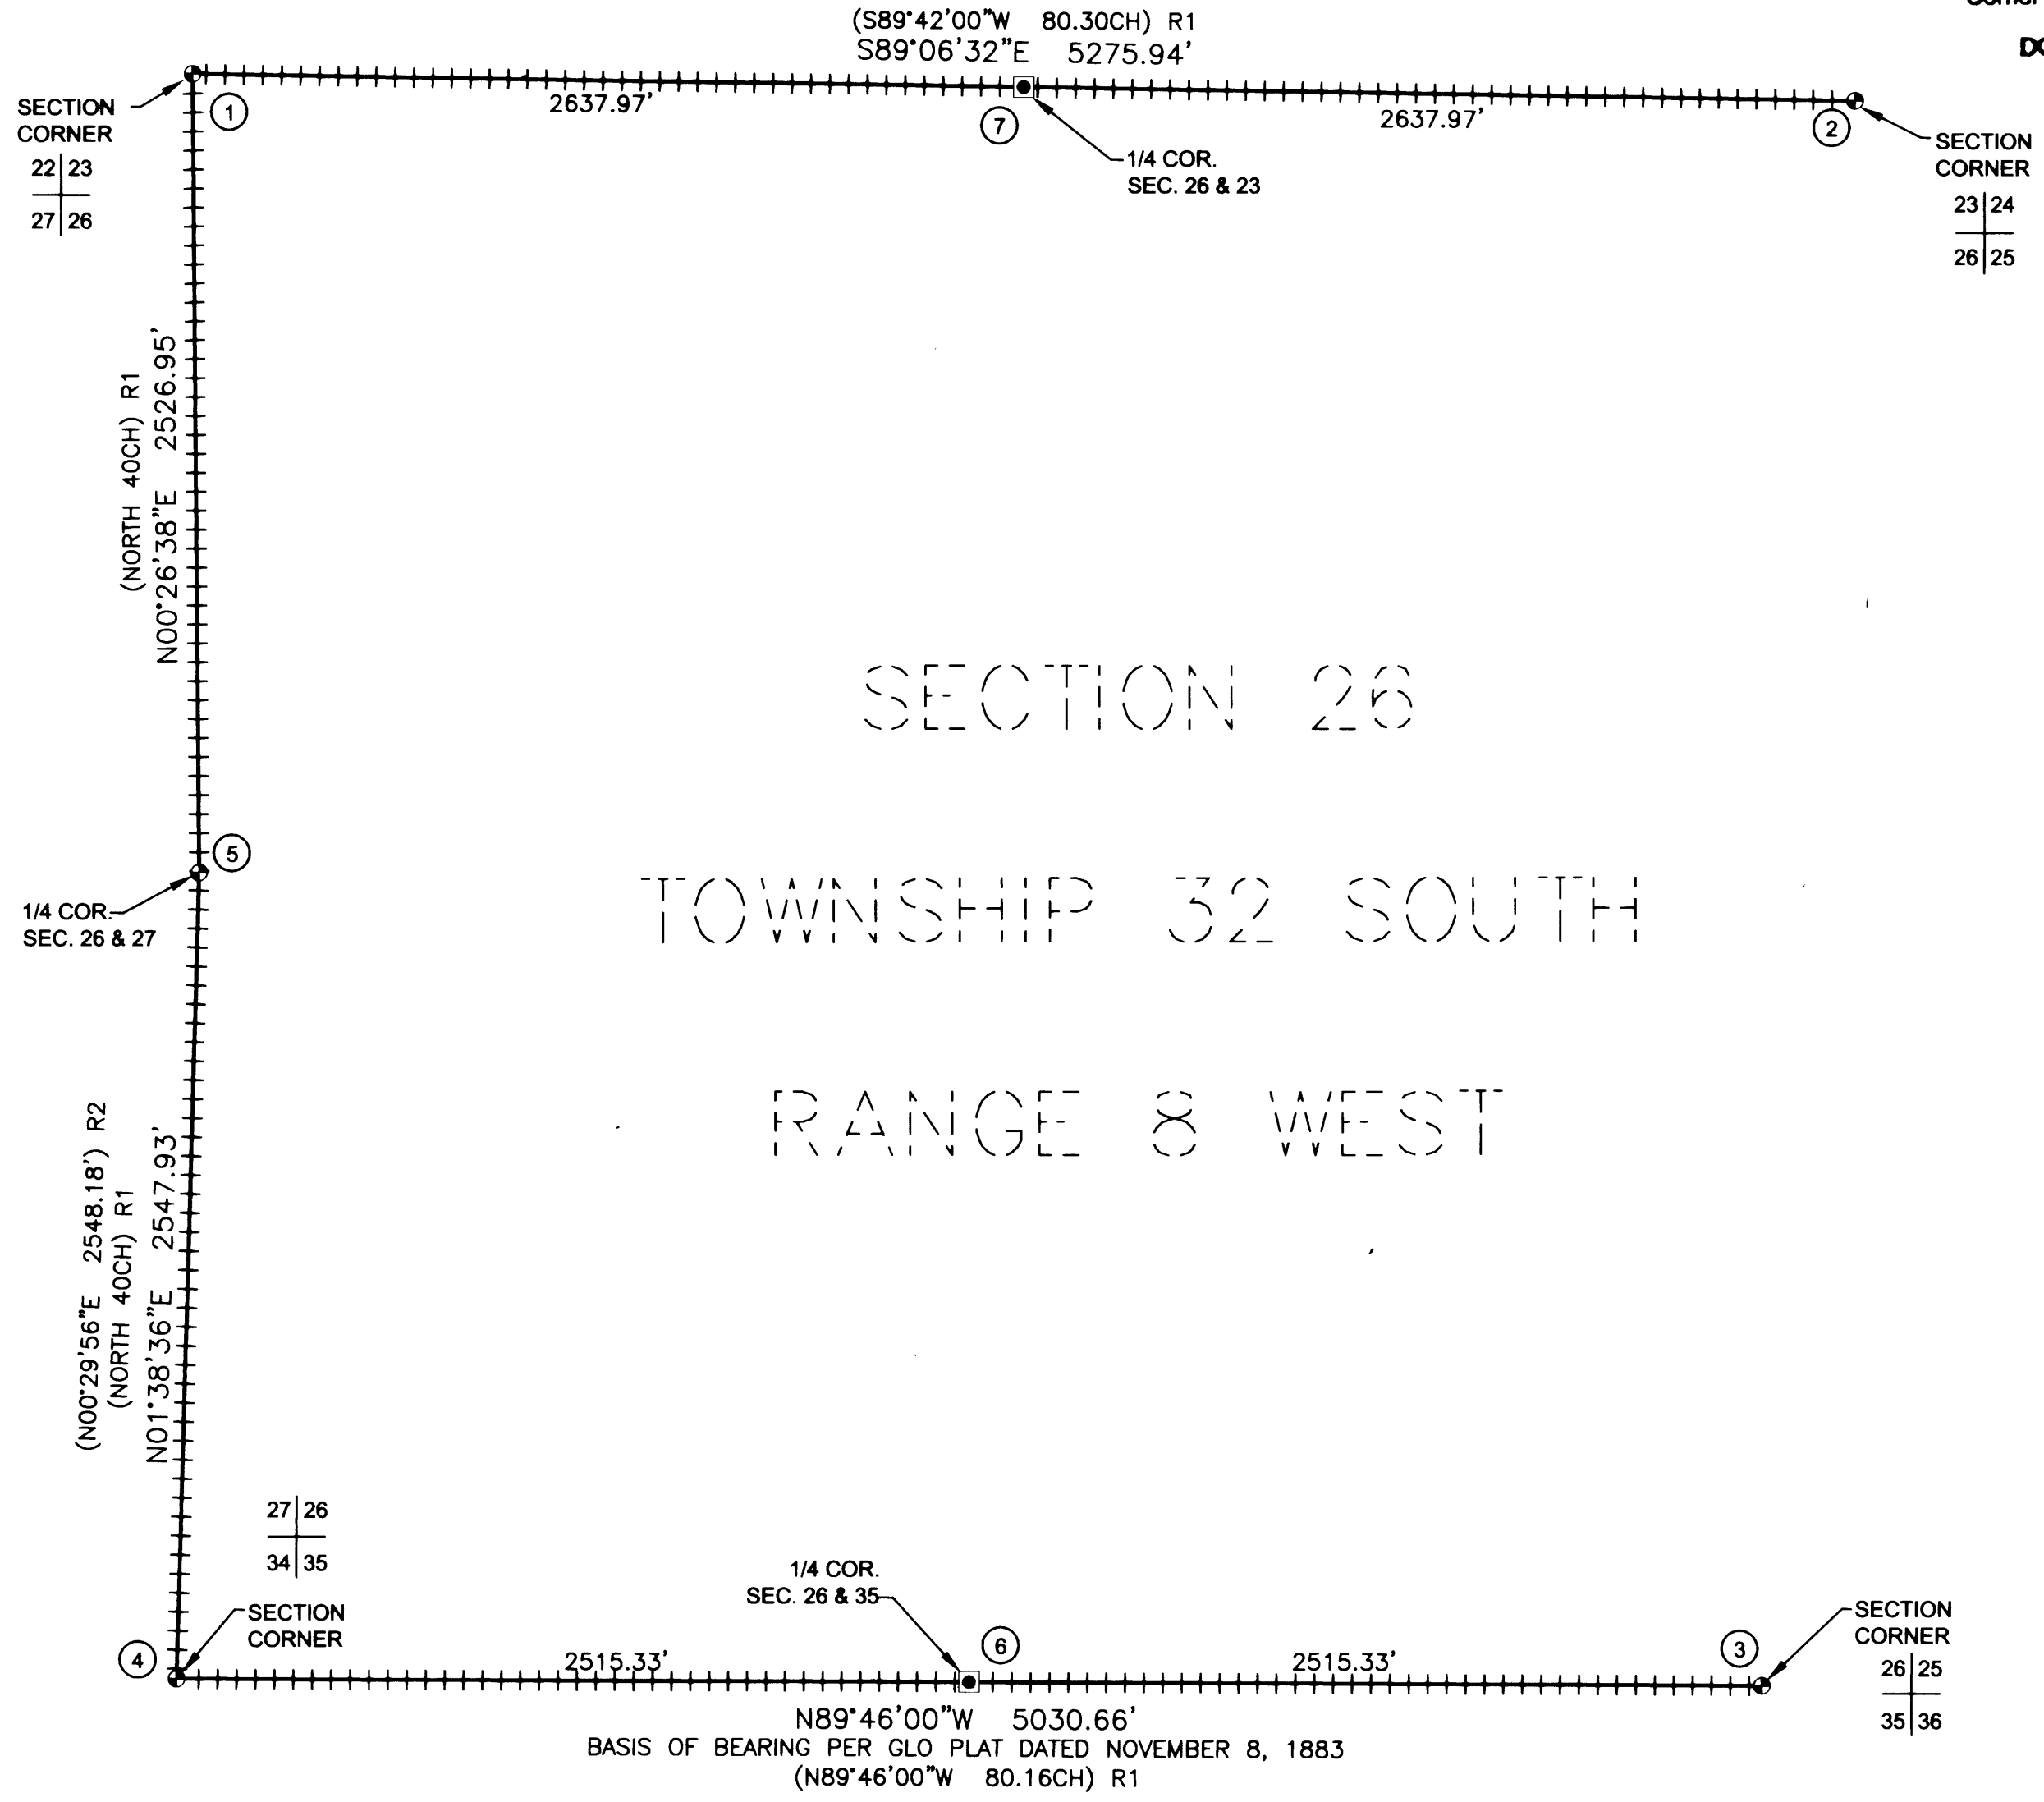

SECTION 26  
TOWNSHIP 32 SOUTH  
RANGE 8 WEST

SURVEYED BY:  
**i.e.**  
ENGINEERING  
809 SE Pine Street  
Roseburg, Oregon 97470  
PHONE (541) 673-0166  
FAX (541) 440-9392  
iemail@ieengineering.com

SURVEYED FOR:  
ROSEBURG RESOURCES  
P.O. BOX 1088  
ROSEBURG, OREGON 97470

DWG. BY: BHK  
PM: RAQ  
PAGE: 1 OF 1  
JOB NO: 1851-20  
SCALE: AS SHOWN  
DATE: 2/06/2014

0' 250' 500' 1000'  
SCALE: 1" = 500'

**RECORD OF SURVEY**  
SECTION 26 TOWNSHIP 32 SOUTH, RANGE 8 WEST,  
WILLAMETTE MERIDIAN, DOUGLAS COUNTY, OREGON

REGISTERED  
PROFESSIONAL  
LAND SURVEYOR

*Ronald A. Gumbly*  
OREGON  
JULY 14, 1978  
RONALD A. GUMBLY  
1654

EXPIRES: 12/31/2014

MAP FILE M167-22