


RECORD OF SURVEY  
 FOR: OXBOW TIMBER 1 LLC  
 SECTION 6, T21S, R7W, W.M.  
 DOUGLAS COUNTY, OREGON  
 10 FEBRUARY 2014

FILED  
 DATE: 4-3-2014 BY: JC  
 THIS SURVEY CONSISTS OF:  
 MAP: M167-49  
 NARRATIVE:  
 CORNER RPT: CS65/77-40  
 DOUGLAS COUNTY  
 SURVEYOR CS65/77-41

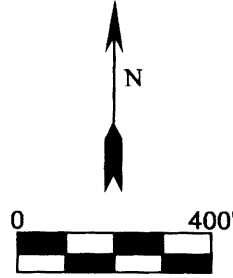

**NARRATIVE**

THE PUROPOSE FOR FILING THIS SURVEY IS TO DOCUMENT A PROPERTY LINE SURVEY FOR OXBOW TIMBER 1 LLC THAT WAS PERFORMED IN SEPTEMBER OF 2012. ROSEBURG RESOURCES CO., HAS REQUESTED THAT ALL SURVEY WORK PERFORMED FOR THEM BETWEEN 2011 AND 2014 BE SHOWN IN A RECORD OF SURVEY. WHEN THE SURVEY WORK WAS PERFORMED, NO CORNERS WERE SET, ONLY PROPERTY LINES WERE MARKED AS NOTED HEREON.

THIS SURVEY RESULTED IN MARKING THE TRUE LINE BETWEEN THE NORTHEAST CORNER AND THE EAST QUARTER CORNER OF SECTION 6 OF TOWNSHIP 21 SOUTH, RANGE 7 WEST OF THE WILLAMETTE MERIDIAN EXISTING CORNERS WERE TIED BY GROUND TRAVERSE FOR CONTROL AND HELD IN THEIR AS TIED POSITIONS FOR MARKING TRUE LINE. TRUE LINE WAS MARKED WITH RED PAINTED BLAZES, RED FLAGGING AND 5-1/2' GALVANIZED STEEL POSTS SET AT AN AVERAGE INTERVAL OF 200'

THE BASIS OF BEARING FOR THIS SURVEY WAS THE 1885 BUREAU OF LAND MANAGEMENT SURVEY OF TOWNSHIP 21 SOUTH, RANGE 7 WEST OF THE WILLAMETTE MERIDIAN




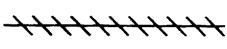
"A"  
 NORTHEAST SECTION CORNER S6


FOUND 2 1/2" ALUM PIPE, PROTRUDING 6" ABOVE GROUND WITH STANDARD INTERNATIONAL PAPER CO. 3/4" ALUM. CAP MKD. "T20S R7W S32 S6 S5 T21S R7W 1983 PLS 1137" WITH THE FOLLOWING ACCESSORIES:  
 26" D. FIR BEARS N3°E 33.7' - HEALED FACE  
 23" CHINQUAPIN BEARS S32°W 5.8' - HEALED FACE  
 27" D. FIR BEARS S25°E 43.6' - HEALED FACE  
 ACCESSORIES ADDED:  
 15" CHINQUAPIN BEARS S70°E 6.3' SCRIBED T21SR7WS5BT

"B"  
 EAST QUARTER CORNER S6


FOUND - 1962 DOUG. CO. BRASS CAP  
 23" HEMLOCK BEARS S30°W 83.7' - HEALED FACE  
 24" HEMLOCK BEARS S69°W 53.7' - HEALED FACE  
 25" D. FIR STUMP BEARS S73°E 21.3' - ROTTED FACE  
 ACCESSORIES ADDED:  
 21" D. FIR BEARS S6°E 35.9' SCRIBED 1/4 S5 BT  
 20" D. FIR BEARS N23°E 19.6' SCRIBED 1/4 S5 BT

**LEGEND**

-  FOUND SECTION CORNER
-  FOUND QUARTER CORNER
-  BASIS OF BEARING
-  PROPERTY LINE MARKED WITH RED PAINTED BLAZES, RED FLAGGING, AND 5-1/2' GALVANIZED STEEL POSTS SET AT 200' +/- INTERVALS

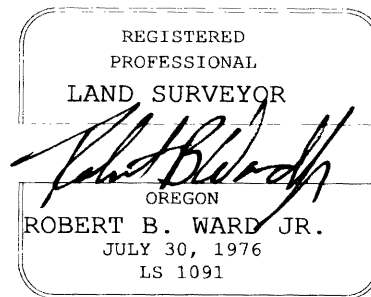

EXPIRATION DATE: 6/30/14

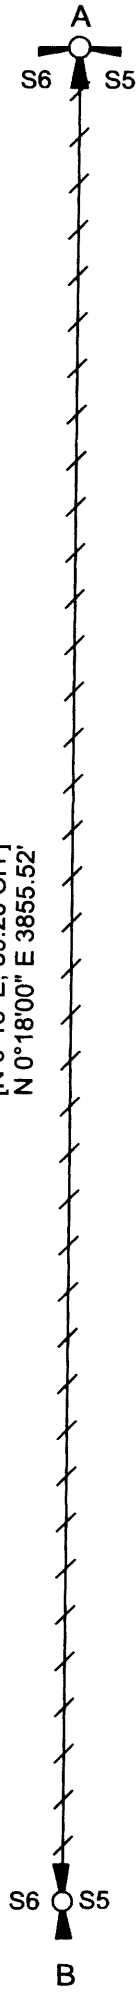

BASIS OF BEARING  
 FEB. 25, 1885 GLO SURVEY  
 [N 0°18' E, 59.20 CH ]  
 N 0°18'00" E 3855.52'

FILE NAME		
12-72.TRV		
SCALE	DATE	DRAWN BY
400 F/In	2-10-2014	CAK
JOB	REVISION	SHEET
SLIDEOUT FIRST	--	1/1

This map drawn with TRAVERSE PC Software

