


RECORD OF SURVEY
 FOR: OXBOW TIMBER 1 L. L. C.
 SE1/4, SECTION 33, T. 20 S., R. 9 W., W.M.
 DOUGLAS COUNTY, OREGON
 20 FEBRUARY 2014

FILED
 DATE: 4-3-2014 BY: X
 THIS SURVEY CONSISTS OF:
 MAP: M167-50
 NARRATIVE:
 CORNER RPT: CS65/77-47
 DOUGLAS COUNTY
 SURVEYOR CS65/77-48
 CS65/78-49

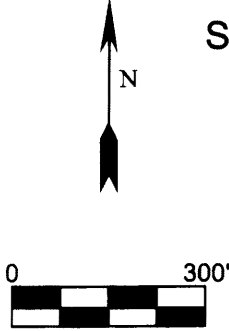

C1/4 S33

C1/4 SECTION 33
 FOUND 3-1/4" BLM BRASS CAP DATED 1984
 WITH THE FOLLOWING ACCESSORIES:
 44" D. FIR BEARS N 63-1/4° E 52.1' - HEALED FACE
 32" R. CEDAR BEARS S 72° W 70.0' - HEALED FACE
 STEEL POST ADJACENT TO CORNER

N 6°15'52" W 1351.10' [N 6°16' W 20.47 CHAINS]

CS1/16 SECTION 33
 FOUND 3-1/4" BLM BRASS CAP DATED 1984
 WITH THE FOLLOWING ACCESSORIES:
 27" D. FIR BEARS S 38-1/2° E 51.5' - HEALED FACE
 21" D. FIR BEARS N 30-1/4° W 57.8 - HEALED FACE
 STEEL POST ADJACENT TO CORNER

BASIS OF BEARING [S 88°59' W 21.08 CHAINS] S 88°59'00" W 1392.14'

CS1/16 S33

SE1/16 S33

SE1/16 SECTION 33
 FOUND 3-1/4" BLM BRASS CAP DATED 1984
 WITH THE FOLLOWING ACCESSORIES:
 67" D. FIR BEARS N 45-1/2° E 84.5' - HEALED FACE
 RECORD 9" CHERRY - MISSING
 NEW BEARING TREE THIS SURVEY
 21" ALDER BEARS N 55° W 16.4' - BARK SCRIBED SE1/16 S33 BT
 STEEL POST ADJACENT TO CORNER

NARRATIVE:


THE PURPOSE FOR FILING THIS SURVEY IS TO DOCUMENT A PROPERTY LINE SURVEY FOR OXBOW TIMBER 1 L. L. C. THAT WAS PERFORMED IN OCTOBER OF 2012. ROSEBURG RESOURCES CO., HAS REQUESTED THAT ALL SURVEY WORK PERFORMED FOR THEM BETWEEN 2011 AND 2014 BE SHOWN IN A RECORD OF SURVEY. WHEN THE SURVEY WORK WAS PERFORMED, NO CORNERS WERE SET, ONLY PROPERTY LINES WERE MARKED AS NOTED HEREON.

THIS SURVEY RESULTED IN MARKING THE TRUE LINE BETWEEN THE C1/4 TO THE CS1/16 THEN TO THE SE1/16 OF SECTION 33, TOWNSHIP 20 SOUTH, RANGE 9 WEST OF THE WILLAMETTE MERIDIAN

EXISTING CORNERS WERE TIED BY GROUND TRAVERSE FOR CONTROL AND HELD IN THEIR AS TIED POSITIONS FOR MARKING TRUE LINE. TRUE LINE WAS MARKED WITH RED PAINTED BLAZES, RED FLAGGING AND 5-1/2' GALVANIZED STEEL POSTS SET AT AN AVERAGE INTERVAL OF 200'

THE BASIS OF BEARING FOR THIS SURVEY WAS THE 1986 BUREAU OF LAND MANAGEMENT DEPENDENT RESURVEY AND SUBDIVISION OF SECTION 33. TOWNSHIP 20 SOUTH, RANGE 9 WEST OF THE WILLAMETTE MERIDIAN.

THIS SURVEY WAS PERFORMED USING A NIKON TOTAL STATION.

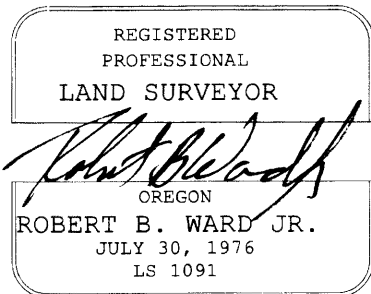

EXPIRATION DATE: 6/30/14



LEGEND

- FOUND SURVEY MONUMENT AS NOTED
- [] RECORD DATA 1986 BUREAU OF LAND MANAGEMENT DEPENDENT RESURVEY AND SUBDIVISION OF SECTION 33
- BLM BUREAU OF LAND MANAGEMENT

FILE NAME		
12-90.TRV		
SCALE	DATE	DRAWN BY
300 Ft/In	2-20-2014	RLR
JOB	REVISION	SHEET
G STA FLAT	----	1/1

This map drawn with TRAVERSE PC Software