



RECORD OF SURVEY  
 FOR: OXBOW TIMBER 1 LLC  
 SECTION 4, T20S, R8W, W.M.  
 DOUGLAS COUNTY, OREGON  
 25 APRIL 2014

FILED  
 DATE: 5/13/2014 BY: *hw*  
 THIS SURVEY CONSISTS OF:  
 MAP: M 168-3  
 NARRATIVE:  
 CORNER RPT:  
 DOUGLAS COUNTY  
 SURVEYOR

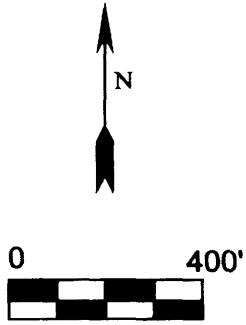

SECTION CORNER SECTIONS 3, 4, 33, 34  
 FOUND 1952 GLO BRASS CAP WITH THE FOLLOWING ACCESSORIES:  
 46" METAL CAPPED FIR STUMP BEARS N 26-1/2° E 48.2' - NO MARKS  
 63" FIR BEARS S 49° E 45.5' - HEALED FACE  
 42" FIR SNAG BEARS N 54° W 52.8' - HEALED FACE  
 27" HEMLOCK STUMP BEARS S 55-3/4° W 59.4' - NO MARKS  
 6" ALDER BEARS N 36° E 18.7' - BARK SCRIBING VISIBLE  
 10" D. FIR BEARS S 45° W 4.8' - HEALED FACE  
 13" D. FIR BEARS N 8-1/4° W 6.7' - HEALED FACE  
 2 STEEL POSTS ADJACENT TO CORNER

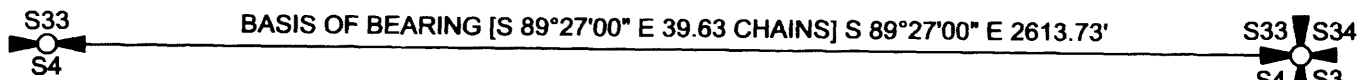

1/4 CORNER SECTIONS 4, 33  
 FOUND 1952 GLO BRASS CAP WITH THE FOLLOWING ACCESSORIES:  
 (RECORD 60" D. FIR N 23° E 87 LKS.) - DOWN  
 (RECORD 10" MAPLE S 26-1/2° E 46 LKS.) - MISSING  
 18" MAPLE BEARS N 22° W 22.9 FT. - BLAZED, SCRIBED 1/4 S33 BT  
 17" D. FIR BEARS N 37° E 28.7 FT. - BLAZED SCRIBED 1/4 S33 BT  
 16" D. FIR BEARS S 44° E 38.0 FT. - BLAZED SCRIBED 1/4 S4 BT  
 20" D. FIR BEARS S 63° W 19.8 FT. - BLAZED SCRIBED 1/4 S4 BT  
 STEEL POST ADJACENT TO CORNER

NARRATIVE:

THE PURPOSE OF THIS SURVEY IS TO DOCUMENT THE MARKING OF TRUE LINE ON THE EAST HALF OF THE NORTH LINE OF SECTION 4, AND THE NORTH HALF OF THE EAST LINE OF SECTION 4, TOWNSHIP 20 SOUTH, RANGE 8 WEST OF THE WILLAMETTE MERIDIAN.

EXISTING CORNERS WERE TIED BY GROUND TRAVERSE FOR CONTROL AND HELD IN THEIR AS TIED POSITIONS FOR MARKING TRUE LINE. TRUE LINE WAS MARKED WITH RED PAINTED BLAZES, RED FLAGGING AND 5-1/2' GALVANIZED STEEL POSTS SET AT AN AVERAGE INTERVAL OF 200'

THE BASIS OF BEARING FOR THIS SURVEY WAS THE 1960 BUREAU OF LAND MANAGEMENT DEPENDENT RESURVEY OF SECTION 4, TOWNSHIP 20 SOUTH, RANGE 8 WEST OF THE WILLAMETTE MERIDIAN.

THIS SURVEY WAS PERFORMED USING A NIKON TOTAL STATION.

LEGEND

- 1/4 CORNER AS NOTED
- SECTION CORNER AS NOTED
- [ ] 1960 BUREAU OF LAND MANAGEMENT DEPENDENT RESURVEY OF SECTION 4, T20S R8W W.M. RECORD DATA
- GLO GENERAL LAND OFFICE

1/4 CORNER SECTIONS 3, 4,  
 FOUND 1954 GLO BRASS CAP WITH THE FOLLOWING ACCESSORIES:  
 38" FIR STUMP BEARS S 66-1/4° E 14.5' - NO MARKS  
 60" FIR STUMP BEARS N 56° W 10.6' - AXE MARKS, NO SCRIBING VISIBLE  
 15" D. FIR BEARS N 67-1/2° E 6.6' - HEALED FACE  
 14" D. FIR BEARS S 87-1/2° W 9.8' - HEALED FACE  
 STEEL POST ADJACENT TO CORNER

REGISTERED  
 PROFESSIONAL  
 LAND SURVEYOR

*Ronald L. Rice*

OREGON  
 JULY 9, 2002  
 RONALD L. RICE  
 54633LS

EXPIRATION DATE: 12-31-2014

Northwest Land Surveying, Inc.  
 P. O. Box 2827  
 FLORENCE, OR 97439 541-997-9201

|             |           |          |
|-------------|-----------|----------|
| FILE NAME   |           |          |
| 14-33-4     |           |          |
| SCALE       | DATE      | DRAWN BY |
| 400 Ft/In   | 4-25-2014 | RLR      |
| JOB         | REVISION  | SHEET    |
| SWEDEN 10-4 | —         | 1/1      |

This map drawn with TRAVERSE PC Software