


RECORD OF SURVEY
FOR: OXBOW TIMBER 1 L.L.C.
ALL QUARTERS, SECTION 9, T. 20 S., R. 7 W., W.M.
DOUGLAS COUNTY, OREGON
13 MAY 2014

FILED
DATE: 5/20/2014 BY: NW
THIS SURVEY CONSISTS OF:
MAP: M 168-5
NARRATIVE:
CORNER RPT:
DOUGLAS COUNTY
SURVEYOR

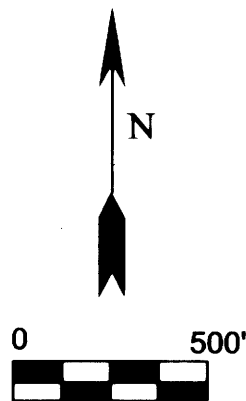

SECTION CORNER SECTIONS 4,5,8,9
FOUND BLM BRASS CAP DATED 1966 WITH
THE FOLLOWING ACCESSORIES:
INDETERMINATE DIAMETER HEMLOCK SNAG BEARS S58-1/2"W, 43.6' NO MARKS
50" BURNT DECAYED D. FIR STUMP BEARS N19-1/4"E, 41.6' SCRIBING VISIBLE
45" BURNT DECAYED D. FIR STUMP BEARS N71"W, 27.1' NO MARKS
14" D. FIR BEARS N13"E, 16.4' HEALED FACE
9" D. FIR BEARS S28-1/2"E, 41.3' HEALED FACE
11" D. FIR BEARS S30"W, 14.7' HEALED FACE
13" D. FIR BEARS N62-3/4"W, 9.1' HEALED FACE
STEEL POST ADJACENT TO CORNER

QUARTER CORNER SECTIONS 8,9
FOUND BLM BRASS CAP DATED 1967 WITH
THE FOLLOWING ACCESSORIES:
23" D. FIR STUMP BEARS N27"E, 27.4' ROTTED FACE
27" D. FIR STUMP BEARS S43"W, 56.4' ROTTED FACE
NEW BT'S THIS SURVEY:
15" D. FIR BEARS S51"W, 8.0' SCRIBED "1/4 S8 BT"
15" D. FIR BEARS S10"E, 36.5' SCRIBED "1/4 S9 BT"
13" D. FIR BEARS N23"E, 17.0' SCRIBED "1/4 S9 BT"
15" D. FIR BEARS N11"W, 16.3' SCRIBED "1/4 S8 BT"
STEEL POST ADJACENT TO CORNER

SECTION CORNER SECTIONS 8,9,16,17
FOUND BLM BRASS CAP DATED 1967
WITH THE FOLLOWING ACCESSORIES:
28" BURNT D. FIR SNAG BEARS S 38° E 5.9' SCRIBING VISIBLE
70" BURNT D. FIR STUMP BEARS S 48° W 39.9' SCRIBING VISIBLE
36" BURNT D. FIR STUMP BEARS N 24-1/2° W 42.2' NO MARKS
18" D. FIR BEARS N 3° E 34.0' SCRIBED T20S R7W S9 BT
16" D. FIR BEARS S 38° W 49.2' SCRIBED T20S R7W S17 BT
STEEL POST ADJACENT TO CORNER

QUARTER CORNER SECTIONS 4 & 9
SET 2-1/2" DIA. ALUMINUM CAP ON 5/8" X 30" REBAR
MARKED AS SHOWN WITH THE FOLLOWING ACCESSORIES:
20" D. FIR BEARS N76"W, 9.8' SCRIBED "1/4 S4 BT"
14" D. FIR BEARS N71"E, 12.9' SCRIBED "1/4 S4 BT"
12" D. FIR BEARS S51"E, 16.7' SCRIBED "1/4 S9 BT"
18" D. FIR BEARS S16"W, 21.4' SCRIBED "1/4 S9 BT"
STEEL POST ADJACENT TO CORNER

T20S R7W
1/4 S4
S9
2014
54633LS

QUARTER CORNER SECTIONS 9 & 16
SET 2-1/2" DIA. ALUMINUM CAP ON 5/8" X 30" REBAR
MARKED AS SHOWN WITH THE FOLLOWING ACCESSORIES:
12" D. FIR BEARS S11"E, 23.4' SCRIBED "1/4 S16 BT"
15" D. FIR BEARS S21"W, 14.6' SCRIBED "1/4 S16 BT"
15" D. FIR BEARS S88"W, 16.3' SCRIBED "1/4 S9 BT"
16" D. FIR BEARS N34"E, 34.8' SCRIBED "1/4 S9 BT"
STEEL POST ADJACENT TO CORNER

T20S R7W
1/4 S9
S16
2014
54633LS

SECTION CORNER SECTIONS 3,4,9,10
FOUND ORE. STATE BOARD OF FORESTRY BRASS CAP
DATED 1967 WITH THE FOLLOWING ACCESSORIES:
40" DECAYED D. FIR STUMP BEARS N76"E 16.5' AXE WORK VISIBLE
32" DECAYED D. FIR STUMP BEARS S12"E 35.6' AXE WORK VISIBLE
35" DECAYED D. FIR STUMP BEARS S87"W 35.6' AXE WORK VISIBLE
43" DECAYED D. FIR STUMP BEARS N27"E, 29.7' ROTTED FACE
46" DECAYED D. FIR STUMP BEARS S66"E, 51.2' ROTTED FACE
44" DECAYED D. FIR STUMP BEARS N59"W, 40.3' ROTTED FACE
15" D. FIR BEARS N35"E, 12.3' HEALED FACE
12" D. FIR BEARS S45-1/4"E, 9.7' HEALED FACE
11" D-FIR BEARS S15-1/4"W, 6.6' HEALED FACE
9" D-FIR BEARS N18-1/4"W, 16.1' HEALED FACE
STEEL POST ADJACENT TO CORNER

QUARTER CORNER SECTIONS 9,10
FOUND ORE. STATE BOARD OF FORESTRY BRASS CAP
DATED 1967 WITH THE FOLLOWING ACCESSORIES:
25" D. FIR STUMP BEARS S44"E 21.1'
(RECORD 9 LINKS) SCRIBING VISIBLE
NEW BT'S THIS SURVEY:
11" D-FIR BEARS N15"W, 30.0' SCRIBED "1/4 S9 BT"
16" D-FIR BEARS S61"E, 12.3' SCRIBED "1/4 S10 BT"
8" D-FIR BEARS S0"E 1.5' SCRIBED "X BT"
11" D-FIR BEARS N89"W, 9.7' SCRIBED "1/4 S9 BT"
STEEL POST ADJACENT TO CORNER

SECTION CORNER SECTIONS 9,10,15,16
FOUND BLM BRASS CAP DATED 1966 WITH THE
FOLLOWING ACCESSORIES:
15" D. FIR BEARS N89-3/4"E, 18.0' HEALED FACE
11" D. FIR BEARS S68"E, 16.7' HEALED FACE
11" MAPLE BEARS S27-1/4"W, 14.2' SCRIBING VISIBLE
12" D. FIR BEARS N0-3/4"W, 5.9' HEALED FACE
STEEL POST ADJACENT TO CORNER

NARRATIVE:

THE PURPOSE OF THIS SURVEY WAS TO MARK TRUE LINE BETWEEN THE CORNERS SHOWN ON THIS RECORD OF SURVEY FOR SECTION 9, TOWNSHIP 20 SOUTH, RANGE 7 WEST OF THE WILLAMETTE MERIDIAN.

EXISTING CORNERS WERE TIED BY GROUND TRAVERSE FOR CONTROL AND HELD IN THEIR AS-TIED POSITION FOR MARKING OF TRUE LINE. NO EVIDENCE OF THE NORTH 1/4 CORNER, SOUTH 1/4 CORNER OR THE LINE TREES ON THE WEST LINE OF SECTION 9 WERE RECOVERED. MISSING 1/4 CORNERS WERE SET AT PROPORTIONATE POSITION BASED THE 1892 GLO RECORD.

TRUE LINE WAS MARKED WITH RED PAINTED BLAZES, RED FLAGGING AND 5-1/2" GALVANIZED STEEL POST SET AT AN AVERAGE INTERVAL OF 200'.

THE BASIS OF BEARING FOR THIS SURVEY WAS THE 1892 GENERAL LAND OFFICE SURVEY OF THE WEST LINE OF SECTION 9, TOWNSHIP 20 SOUTH, RANGE 9 WEST OF THE WILLAMETTE MERIDIAN.

THIS SURVEY WAS PERFORMED USING A NIKON TOTAL STATION.

LEGEND

- 1/4 CORNER AS NOTED
- SECTION CORNER AS NOTED
- [] 1892 GLO RECORD DATA
- () RECORD DATA CS FILE 55/36
- GLO GENERAL LAND OFFICE
- BLM BUREAU OF LAND MANAGEMENT

REGISTERED
PROFESSIONAL
LAND SURVEYOR
Ronald L. Rice
OREGON
JULY 9, 2002
RONALD L. RICE
54633LS



(541) 997-9201
www.northwestlandsurveying.com

P.O. Box 2827
Florence, OR 97439
Fax (541) 992-0743

EXPIRATION DATE: 12-31-2014

FILE NAME		
14-13		
SCALE	DATE	DRAWN BY
500 F/U	5-13-2014	RBW
JOB	REVISION	SHEET
OXBOW BEAR		1/1

This map drawn with TRAVERSE PC Software