

SHEET INDEX

- VICINITY MAP, NARRATIVE & REFERENCES.
- LEGAL DESCRIPTION, DETAILS AND LEGEND
- MONUMENT TABLES, CONTROL TABLE AND CURVE TABLE
5. SURVEY SHEETS

RECORD OF SURVEY

REEDSPORT SUBSTATION
 LYING WITHIN
 THE NE1/4NE1/4 OF SECTION 4 AND
 THE NW1/4NW1/4 OF SECTION 3 T.22S., R.12W., W.M.
 DOUGLAS COUNTY, OREGON

FILED
 Date: 3-30-2016 By: JC
 This survey consists of:
 Map: H170-54A-E
 Narrative: _____
 Corner: _____
 DOUGLAS COUNTY
 CLERK

CURVE TABLE

NO.	RADIUS	LENGTH	CHORD	CHORD BEARING	DELTA ANGLE
C1	622.59'	250.73'	249.04'	S 60°04'21" W	23°04'27"
C2	875.32'	112.05'	111.98'	N 52°00'31" E	07°20'05"
C3	875.32'	266.93'	265.90'	N 64°24'44" E	17°28'21"
C4	875.32'	378.98'	376.03'	N 60°44'41" E	24°48'26"
C5	358.10'	167.53'	166.00'	S 61°51'41" W	26°48'15"
(C5-R7)					26°48'00"
(C5-R11)	358.10'	167.00'			26°43'

SET MONUMENT TABLE

PT ID	GRID NORTHING	GRID EASTING	DESCRIPTION
REED-PC05	760383.25	3963218.13	5/8" X 30" IRON ROD WITH 3-1/4" BPA ALUMINUM CAP, STAMPED AS SHOWN ON SHEET 4
REED-PC06	760234.05	3963257.31	5/8" X 30" IRON ROD WITH 3-1/4" BPA ALUMINUM CAP, STAMPED AS SHOWN ON SHEET 4

FOUND MONUMENT TABLE

YPC - YELLOW PLASTIC CAP
 ALL FOUND MONUMENTS IN GOOD CONDITION, UNLESS OTHERWISE NOTED

PT ID	GRID NORTHING	GRID EASTING	DESCRIPTION	REFERENCE DOCUMENT
REED-PC01	760109.81	3963041.49	3-1/2" BONNEVILLE POWER ADMINISTRATION BRASS DISK	BONNEVILLE POWER ADMINISTRATION DRAWING SERIAL NO. 38233 (DRAWING *221-02-340-DI, SHEET 33 OF 33)
REED-PC02	760010.62	3962929.23	3-1/2" BONNEVILLE POWER ADMINISTRATION BRASS DISK	BONNEVILLE POWER ADMINISTRATION DRAWING SERIAL NO. 38233 (DRAWING *221-02-340-DI, SHEET 33 OF 33)
REED-PC03	760216.99	3962746.14	2" IRON PIPE	BONNEVILLE POWER ADMINISTRATION DRAWING SERIAL NO. 38233 (DRAWING *221-02-340-DI, SHEET 33 OF 33)
REED-PC04	760317.49	3962859.11	3-1/2" BONNEVILLE POWER ADMINISTRATION BRASS DISK	BONNEVILLE POWER ADMINISTRATION DRAWING SERIAL NO. 38233 (DRAWING *221-02-340-DI, SHEET 33 OF 33)
REED-RC01	760388.18	3962946.82	3/4" IRON PIPE	ORIGIN UNKNOWN, SHOWN FOUND PER COUNTY SURVEY NO. M49-44 (POSSIBLY PER C.S. 51/283)
WM22S12W400700	760800.05	3963160.39	BRASS CAP IN CONCRETE	PER THE CORNER RE-ESTABLISHMENT NOTES AND THE DOUGLAS COUNTY SURVEYORS OFFICE
I000	759945.24	3962751.81	5/8" IRON ROD W/ YPC MARKED *ESTABROOK LS 2703*	PER COUNTY SURVEY NO. M127-49
I001	759881.03	3962711.58	5/8" IRON ROD	PER COUNTY SURVEY NO. M49-44
I002	759845.92	3962618.05	5/8" IRON ROD IN PVC TUBE	PER COUNTY SURVEY NO. C.S. 58/201-I
I003	759810.74	3962524.35	5/8" IRON ROD W/ YPC ILLEGIBLE	PER COUNTY SURVEY NO. C.S. 58/201-I
I004	760155.62	3962674.27	5/8" IRON ROD W/ YPC MARKED *ESTABROOK LS 2703*	PER COUNTY SURVEY NO. M127-49
I005	760190.66	3962769.50	5/8" IRON ROD W/ YPC MARKED *ESTABROOK LS 2703*	PER COUNTY SURVEY NO. M127-49
I006	760043.64	3963382.53	1" BRASS DISK MARKED *ODOT CONTROL 100*	PER COUNTY SURVEY NO. ST HWY 101-008A THRU 008F
I007	760047.40	3963397.18	2" ALUM CAP MARKED *ODOT RIGHT-OF-WAY 5000*	PER COUNTY SURVEY NO. ST HWY 101-008A THRU 008F
I008	760053.36	3963386.92	2" ALUM CAP MARKED *ODOT RIGHT-OF-WAY 5001*	PER COUNTY SURVEY NO. ST HWY 101-008A THRU 008F
I009	759878.99	3962916.59	MAG NAIL W/ WASHER MARKED *ODOT CONTROL 105*	PER COUNTY SURVEY NO. ST HWY 101-008A THRU 008F
I010	759605.35	3962091.78	3/8" IRON ROD, BENT, TIED SPIN POINT	PER ODOT ROLL MAP NO. 7B-07-12 OREGON COAST HIGHWAY REEDSPORT-WINCHESTER BAY SECTION
I011	759595.85	3962095.22	3/8" IRON ROD, BENT, TIED SPIN POINT	PER ODOT ROLL MAP NO. 7B-07-12 OREGON COAST HIGHWAY REEDSPORT-WINCHESTER BAY SECTION
I012	759698.93	3962856.18	5/8" IRON ROD W/ YPC MARKED *RJ HINTZ PLS 497*	PER COUNTY SURVEY NO. C.S. 63/3-5
I015	759938.35	3963342.73	1" BRASS DISK MARKED *ODOT CONTROL 101*	PER COUNTY SURVEY NO. ST HWY 101-008A THRU 008F
I016	760259.60	3962572.08	5/8" IRON ROD, BENT, TIED SPIN POINT	PER COUNTY SURVEY NO. M49-44
I017	760277.50	3962629.34	1" IRON PIPE	ORIGIN UNKNOWN, SHOWN FOUND PER COUNTY SURVEY NO. M49-44 (POSSIBLY PER C.S. 51/283)
I018	760008.25	3962933.90	5/8" IRON ROD BENT, TIED SPIN POINT	ORIGIN UNKNOWN, SHOWN FOUND PER COUNTY SURVEY NO. ST HWY 101-008A THRU 008F
I019	760254.39	3963334.67	3/4" IRON PIPE	PER ORIGINAL PLAT OF *REEDSPORT* RECORDED IN VOLUME 3, PAGE 32 OF PLATS, DOUGLAS COUNTY
I020	760521.55	3963264.51	1/2" IRON PIPE	PER ORIGINAL PLAT OF *REEDSPORT* RECORDED IN VOLUME 3, PAGE 32 OF PLATS, DOUGLAS COUNTY
I021	760772.47	3963984.04	1" IRON PIPE	PER COUNTY SURVEY NO. C.S. 51/228-4
I022	760447.64	3964069.25	1/2" IRON PIPE	PER COUNTY SURVEY NO. M161-53
I025	760343.64	3963673.11	1/2" IRON PIPE	PER ORIGINAL PLAT OF *REEDSPORT* RECORDED IN VOLUME 3, PAGE 32 OF PLATS, DOUGLAS COUNTY


CONTROL AND BASELINE MONUMENT TABLE

PT ID	GRID NORTHING	GRID EASTING	DESCRIPTION
REEDA	760157.02	3963122.47	3-1/4" BPA ALUMINUM CAP MARKED *REEDA 2013 OBE*
REEDB	760171.25	3963148.25	3-1/4" BPA ALUMINUM CAP MARKED *REEDB 2013 OBE*
REEDC	760226.82	3963236.13	3-1/4" BPA ALUMINUM CAP MARKED *REEDC 2013 OBE*
REED-E92	760294.40	3963149.33	3-1/4" BPA ALUMINUM CAP IN CONCRETE MARKED *REED BL E92 BAT14*
REED-INTX	760241.94	3963073.74	3-1/4" BPA ALUMINUM CAP IN CONCRETE MARKED *N/S BL INT*
REED-N120.61	760341.01	3963004.98	3-1/4" BPA ALUMINUM CAP IN CONCRETE MARKED *PT N/S B/LINE*
REED-S73	760181.98	3963115.37	3-1/4" BPA ALUMINUM CAP IN CONCRETE MARKED *REED BL S73 BAT14*
REED-W202	760126.78	3962907.82	3-1/4" BPA ALUMINUM CAP IN CONCRETE MARKED *REED BL W202 BAT14*

REED-E92, REED-INTX, REED-N120.61, REED-S73 & REED-W202
 INFORMATION PROVIDED BY BPA, A CHECK WAS MADE TO REED-W202
 AND FIT SITE CONTROL REEDA, REEDB AND REEDC WELL.

FILE NAME: WO_356103_17_ROS.dgn

Corporate Office: 920 COUNTRY CLUB ROAD, SUITE 100B EUGENE, OREGON 97401-8086, 541-683-8090
 3880 FAIRVIEW INDUSTRIAL DR SE, SUITE 200 SALEM, OREGON 97302-1106, 503-588-4100
 831 O'HARE PARKWAY MEDFORD, OREGON 97504-4005, 541-774-5580
 5000 MEADOWS ROAD, SUITE 420 LAKE OSWEGO, OREGON 97035, 503-620-6103
 1111 MAIN STREET, SUITE 401 VANCOUVER, WASHINGTON 98660 360-314-2301
 www.obec.com

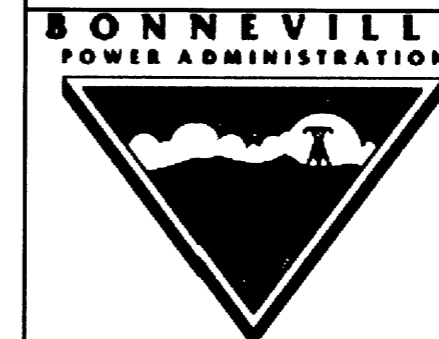

REEDSPORT SUBSTATION
 RECORD OF SURVEY
 DOUGLAS COUNTY, OREGON

MARCH 29, 2016
 NO SCALE
 SHEET 3 OF 5

REGISTERED
 PROFESSIONAL
 LAND SURVEYOR

OREGON
 JULY 12, 2005
 LOGAN MILES
 65452

RENEWAL: DEC. 31, 2016
 Signed: 3/29/16

DESIGNED: L. MILES
 DRAWN: C. BARROWS
 CHK'D: A. CUTSFORTH
 PROJ. NO. 684-003.15
 W/O# 356103-17

MAP File No H170-54C

MAP File No H170-54C