


FILED
Date: 7-7-2016 By: JC
This survey consists of:
Map: M171-12 A & B
Narrative:
Corner Ppt:
DOUGLAS COUNTY
SURVEYOR

④ N 1/4 CORNER SECTION 5 ONLY

SET 5/8"x30" IR WITH 2" ALUMINUM CAP MARKED "1/4 S5 2016 RLS 1654"
FOUND 1968 USBLM BRASS CAP STAMPED "C794 S5 S4 CC 1968"
NEW BEARING TREES:
18" D FIR S63°W, 28.4' SCRIBED "1/4 S5 BT".
12" D FIR S07°E, 21.1' SCRIBED "1/4 S5 BT".
14" D FIR N51°W, 22.5' SCRIBED "1/4 S5 BT".
8" D FIR N82°E, 27.3' SCRIBED "1/4 S5 BT".

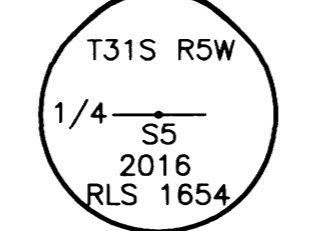

⑤ S 1/4 CORNER SECTION 32 ONLY

FOUND 2007 DCSO BRASS CAP
FOUND BEARING TREES/OBJECTS:
2" CHISELED "+ B0" IN ROCK OUTCROP N44°E, 6.7'.
40" D FIR SNAG NORTH, 91.6' WITH CHOPED OUT BLAZE.
12" D FIR N29°W, 32.9' WITH VISIBLE SCRIBE.
12" MADRONE S46°W, 19.3' WITH VISIBLE SCRIBE.
6" OAK BEARS S32°E, 28.3' WITH VISIBLE SCRIBE.

⑥ SECTION CORNER SECTIONS 4, 5, 32, & 33

FOUND 1959 DCSO BRASS CAP
FOUND BEARING TREES:
48" CEDAR SNAG S38°W, 100.7' WITH VISIBLE SCRIBE.
10" D FIR N13°W, 8.8' WITH VISIBLE SCRIBE.
9" D FIR N24°E, 18.0' WITH GOOD SCAR.
12" D FIR S48°E, 16.7' WITH GOOD SCAR.
6" DOWNED MADRONE N67°E, 7.2'.
8" D FIR S13°W, 7.0' WITH GOOD SCAR.

⑦ NORTH CLAIM CORNER

FOUND 1968 USBLM BRASS CAP STAMPED "CC S5 S4 C794 1968"
FOUND BEARING TREES:
30" FIR N20°E, 28.7' WITH GOOD SCAR.
6" MADRONE SNAG S73°W, 54.1' WITH NO MARKS.
NEW BEARING TREE:
4" D FIR N88°W, 15.6' SCRIBED "T31S R5W S5 CC BT".

⑧ SOUTH CLAIM CORNER

FOUND BEARING TREES:
56" FIR S19°E, 144.5' WITH GOOD SCAR.
40" FIR SNAG S45°W, 235.0' WITH GOOD SCAR.
NEW BEARING TREE:
7" D FIR S32°W, 23.6' SCRIBED "T31S R5W S5 CC BT".

⑨ N 1/16 CORNER SECTIONS 5 & 6

FOUND 3/4 IRON ROD PER M12-15
FOUND BEARING TREES:
12" MADRONE S15°W, 32.4' GOOD SCAR.
10" MADRONE S52°E, 22.5' SNAG.
NEW BEARING TREES:
10" D FIR S80°E, 13.6' SCRIBED "N1/16 S5 BT".


⑩ NW 1/16 CORNER SECTION 5

SET 5/8"x30" IR WITH 2" ALUMINUM CAP MARKED "NW 1/16 S5 2016 RLS 1654"
NEW BEARING TREES:
12" D FIR S83°W, 22.7' SCRIBED "NW1/16 BT".
14" D FIR S13°W, 25.6' SCRIBED "NW1/16 BT".



⑪ NE 1/16 CORNER SECTION 5

SET 5/8"x30" IR WITH 2" ALUMINUM CAP MARKED "NE 1/16 S5 2016 RLS 1654"
NEW BEARING TREES:
4" D FIR N28°E, 21.9' SCRIBED "NE1/16 BT".
10" D FIR N89°W, 7.7' SCRIBED "NE1/16 BT".

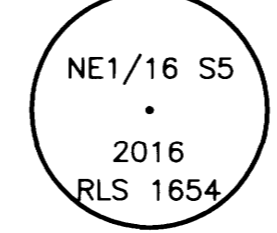


⑫ N 1/16 CORNER SECTION 5 & 4

FOUND BRASS CAP PER 1966-1968 BLM RESURVEY
FOUND BEARING TREES:
22" FIR N46°E 44.9' HEALED FACE
46" FIR N58°W 116.8' HEALED FACE
24" DIA. x 48" TALL BURNED FIR SNAG N82°W 5.9' NO VISIBLE SCRIBE


⑬ SE NW 1/64 CORNER SECTION 5

SET 5/8"x30" IR WITH 2" ALUMINUM CAP MARKED "SESENW S5 2016 RLS 1654"
NEW BEARING TREES:
14" D FIR S14°E, 12.8' SCRIBED "SESENW1/64 BT".
6" D FIR N32°E, 8.9' SCRIBED "SESENW1/64 BT".

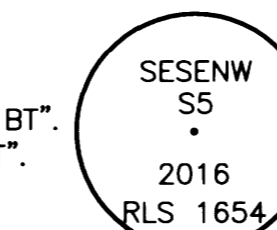


⑭ C S N 1/64 CORNER SECTION 5

SET 5/8"x30" IR WITH 2" ALUMINUM CAP MARKED "CNS 1/64 S5 2016 RLS 1654"
NEW BEARING TREES:
12" D FIR S06°E, 18.4' SCRIBED "CNS1/64 BT".
25" PINE N62°E, 9.0' SCRIBED "CNS1/64 BT".

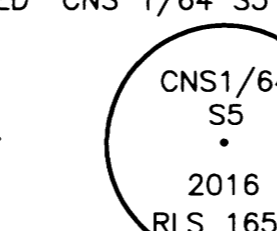


⑮ C S NE 1/64 CORNER SECTION 5

SET 5/8"x30" IR WITH 2" ALUMINUM CAP MARKED "CSNE 1/64 S5 2016 RLS 1654"
NEW BEARING TREES:
8" D FIR N66°W, 16.6' SCRIBED "CSNE1/64 BT".
4" D FIR N87°E, 23.4' SCRIBED "CSNE1/64 BT".

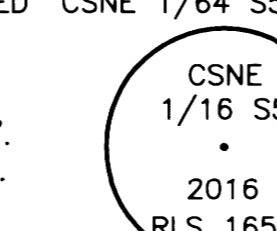

⑯ C E SE NE 1/256 CORNER

SET 5/8"x30" IR WITH 2" ALUMINUM CAP MARKED "1/256 S5 2016 RLS 1654"
NEW BEARING TREES:
12" D FIR S28°E, 22.3' SCRIBED "1/256 BT".
11" D FIR S56°E, 15.8' SCRIBED "1/256 BT".

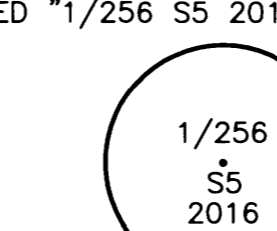

⑰ S N 1/64 CORNER SECTIONS 5 & 4


FOUND BRASS CAP PER 1966-1968 BLM RESURVEY
FOUND BEARING TREES:
18" MADRONE S15°E 46.5' HEALED FACE
31" FIR S40°W 55.4' HEALED FACE

⑱ 1/4 CORNER SECTIONS 5 & 6

FOUND 1966 DCSO BRASS CAP
FOUND BEARING TREES:
16" MADRONE N67°W, 13.2' WITH VISIBLE SCRIBE.
28" D FIR S32°E, 44.8' WITH GOOD SCAR.
10" DOWNED OAK N59°E, 19.8'.
NEW BEARING TREES:
4" D FIR S51°W, 22.8' SCRIBED "1/4 S6 BT".
8" CEDAR N04°E, 43.8' SCRIBED "1/4 S5 BT".


⑲ CW 1/16 CORNER SECTION 5

SET 5/8"x30" IR WITH 2" ALUMINUM CAP MARKED "W 1/16 C-C S5 2016 RLS 1654"
NEW BEARING TREES:
6" D FIR N35°W, 16.2' SCRIBED "CW1/16 BT".
12" D FIR S63°W, 43.5' SCRIBED "CW1/16 BT".

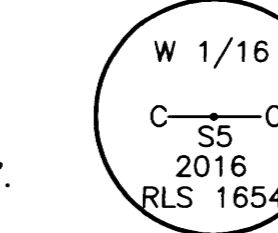


⑳ C E W 1/64 CORNER SECTION 5

SET 5/8"x30" IR WITH 2" ALUMINUM CAP MARKED "CWE 1/64 S5 2016 RLS 1654"
NEW BEARING TREES:
9" D FIR S12°W, 20.0' SCRIBED "CWE1/64 BT".
10" D FIR N24°E, 14.7' SCRIBED "CWE1/64 BT".

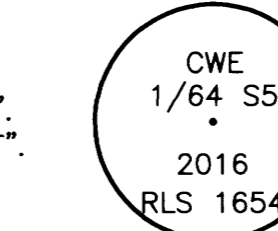

㉑ 1/256 CORNER

SET 5/8"x30" IR WITH 2" ALUMINUM CAP MARKED "1/256 S5 2016 RLS 1654"
NEW BEARING TREES:
9" D FIR N33°E, 13.1' SCRIBED "1/256 BT".
16" D FIR S15°E, 13.1' SCRIBED "1/256 BT".

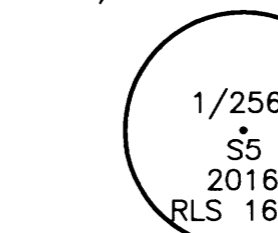


㉒ 1/4 CORNER SECTION 5 & 4

FOUND BRASS CAP PER 1966-1968 BLM RESURVEY
FOUND BEARING TREES:
20" HEMLOCK S55°E 21.1' HEALED FACE
66" CEDAR S65°W 37.6' HEALED FACE
30" FIR N26°W 7.9' HEALED FACE
15" HEMLOCK N46°E 6.9' WITH VISIBLE SCRIBE


㉓ NE SW 1/64 CORNER

SET 5/8"x30" IR WITH 2" ALUMINUM CAP MARKED "1/256 S5 2016 RLS 1654"
NEW BEARING TREES:
13" P PINE S44°E, 33.3' SCRIBED "CNESW 1/64 BT".
18" D FIR S43°W, 45.8' SCRIBED "CNESW 1/64 BT".

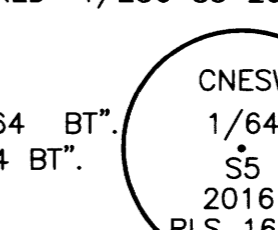


㉔ C S N 1/64 CORNER SECTION 5

SET 5/8"x30" IR WITH 2" ALUMINUM CAP MARKED "CSN 1/64 S5 2016 RLS 1654"
NEW BEARING TREES:
7" D FIR S14°W, 19.2' SCRIBED "CSN1/64 BT".
9" D FIR S60°E, 37.0' SCRIBED "CSN1/64 BT".

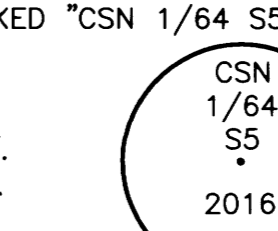


㉕ C N SE 1/64 CORNER

SET 5/8"x30" IR WITH 2" ALUMINUM CAP MARKED "1/64 S5 2016 RLS 1654"
NEW BEARING TREES:
9" D FIR S66°E, 19.3' SCRIBED "CNSE 1/64 BT".
12" D FIR S76°W, 21.6' SCRIBED "CNSE 1/64 BT".

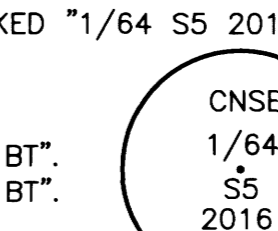

㉖ C E NE SE 1/256 CORNER

SET 5/8"x30" IR WITH 2" ALUMINUM CAP MARKED "1/256 S5 2016 RLS 1654"
NEW BEARING TREES:
8" D FIR S07°W, 16.8' SCRIBED "1/256 BT".
6" HEMLOCK N26°E, 26.1' SCRIBED "1/256 BT".

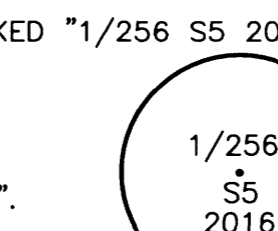

㉗ N S 1/64 CORNER SECTION 5 & 4

FOUND BRASS CAP PER 1966-1968 BLM RESURVEY
FOUND BEARING TREES:
17" HEMLOCK S38°E 10.9' HEALED FACE
17" FIR S42°W 21.8' HEALED FACE

㉘ S 1/16 CORNER SECTIONS 5 & 4

FOUND BRASS CAP PER 1966-1968 BLM RESURVEY
FOUND BEARING TREES:
17" HEMLOCK S34°W, 25.7' HEALED FACE (RECORD S34°W, 39LKS)
15" HEMLOCK N77°E, 13.2' WITH VISIBLE SCRIBE

㉙ SECTION CORNER SECTIONS 5, 6, 7, & 8

FOUND ORIGINAL CORNER TREE 34" FIR SNAG WITH HEALED BLAZE ON SE & SW SIDES
FOUND BRASS CAP REFERENCE MONUMENT MARKED "RM 3.7FT TO COR 1998" S42°47'26"E, 3.71'

FOUND BEARING TREES:

24" D FIR N30°E, 2.0' WITH GOOD SCAR.
26" PINE S72°E, 14.5' WITH GOOD SCAR.
40" CEDAR STUMP S22°E, 30.4' WITH NO MARKS.
19" FIR SNAG N10°W, 2.6' WITH GOOD SCAR.
20" CEDAR N54°E, 46.2' WITH VISIBLE SCRIBE.
22" D FIR N15°W, 52.8' WITH GOOD SCAR.
1/4 CORNER SECTIONS 5 & 8

FOUND 1966 USBLM BRASS CAP

FOUND BEARING TREES:
10" MADRONE N16°W, 50.8' WITH NO SCAR.
6" OAK N18°E, 28.7' WITH VISIBLE SCRIBE.

NEW BEARING TREES:

8" D FIR S44°W, 13.3' SCRIBED "1/4 S8 BT".
12" PINE N61°W, 26.3' SCRIBED "1/4 S5 BT".

㉚ SE CORNER SECTIONS 5

FOUND BRASS CAP PER 1966-1968 BLM RESURVEY

FOUND BEARING TREES:

24" W FIR N83°E, 57.8' WITH HEALED FACE
30" STUMP N59°W, 141.5' WITH HEALED FACE
13" D FIR S17°E, 19.5' WITH HEALED FACE
10" D FIR S55°W, 15.7' WITH HEALED FACE
8" D FIR N71°W, 22.9' WITH HEALED FACE

① CC CORNER SECTIONS 5 & 6



FOUND 3/4 IRON ROD PER M12-15
FOUND BEARING TREES:
20" D FIR S59°W, 60.0' NOW UPROOTED SNAG.
32" D FIR S48°E, 54.8' WITH GOOD SCAR.
NEW BEARING TREES:
12" D FIR S54°W, 10.9' SCRIBED "T31S R5W S6 BT".
11" D FIR S32°E, 19.6' SCRIBED "T31S R5W S5 BT".
30" D FIR S81°W, 30.8' SCRIBED "T31S R5W S6 BT".

② SECTION CORNER SECTIONS 31 & 32

FOUND 2006 DCSO BRASS CAP
FOUND BEARING TREES:
8" CHINQUAPIN N89°W, 5.8' WITH VISIBLE SCRIBE.
8" D FIR N29°W, 45.9' WITH GOOD SCAR.
8" MADRONE N04°E, 14.6' WITH VISIBLE SCRIBE.
10" D FIR N65°E, 10.9' WITH GOOD SCAR.

③ W 1/16 CORNER SECTION 5

SET 5/8"x30" IR WITH 2" ALUMINUM CAP MARKED "W 1/16 S5 2016 RLS 1654"
NEW BEARING TREES:
6" D FIR S73°W, 2.7' SCRIBED "W1/16 S5 BT".
6" MAPLE N74°W, 10.5' SCRIBED "W1/16 S5 BT".

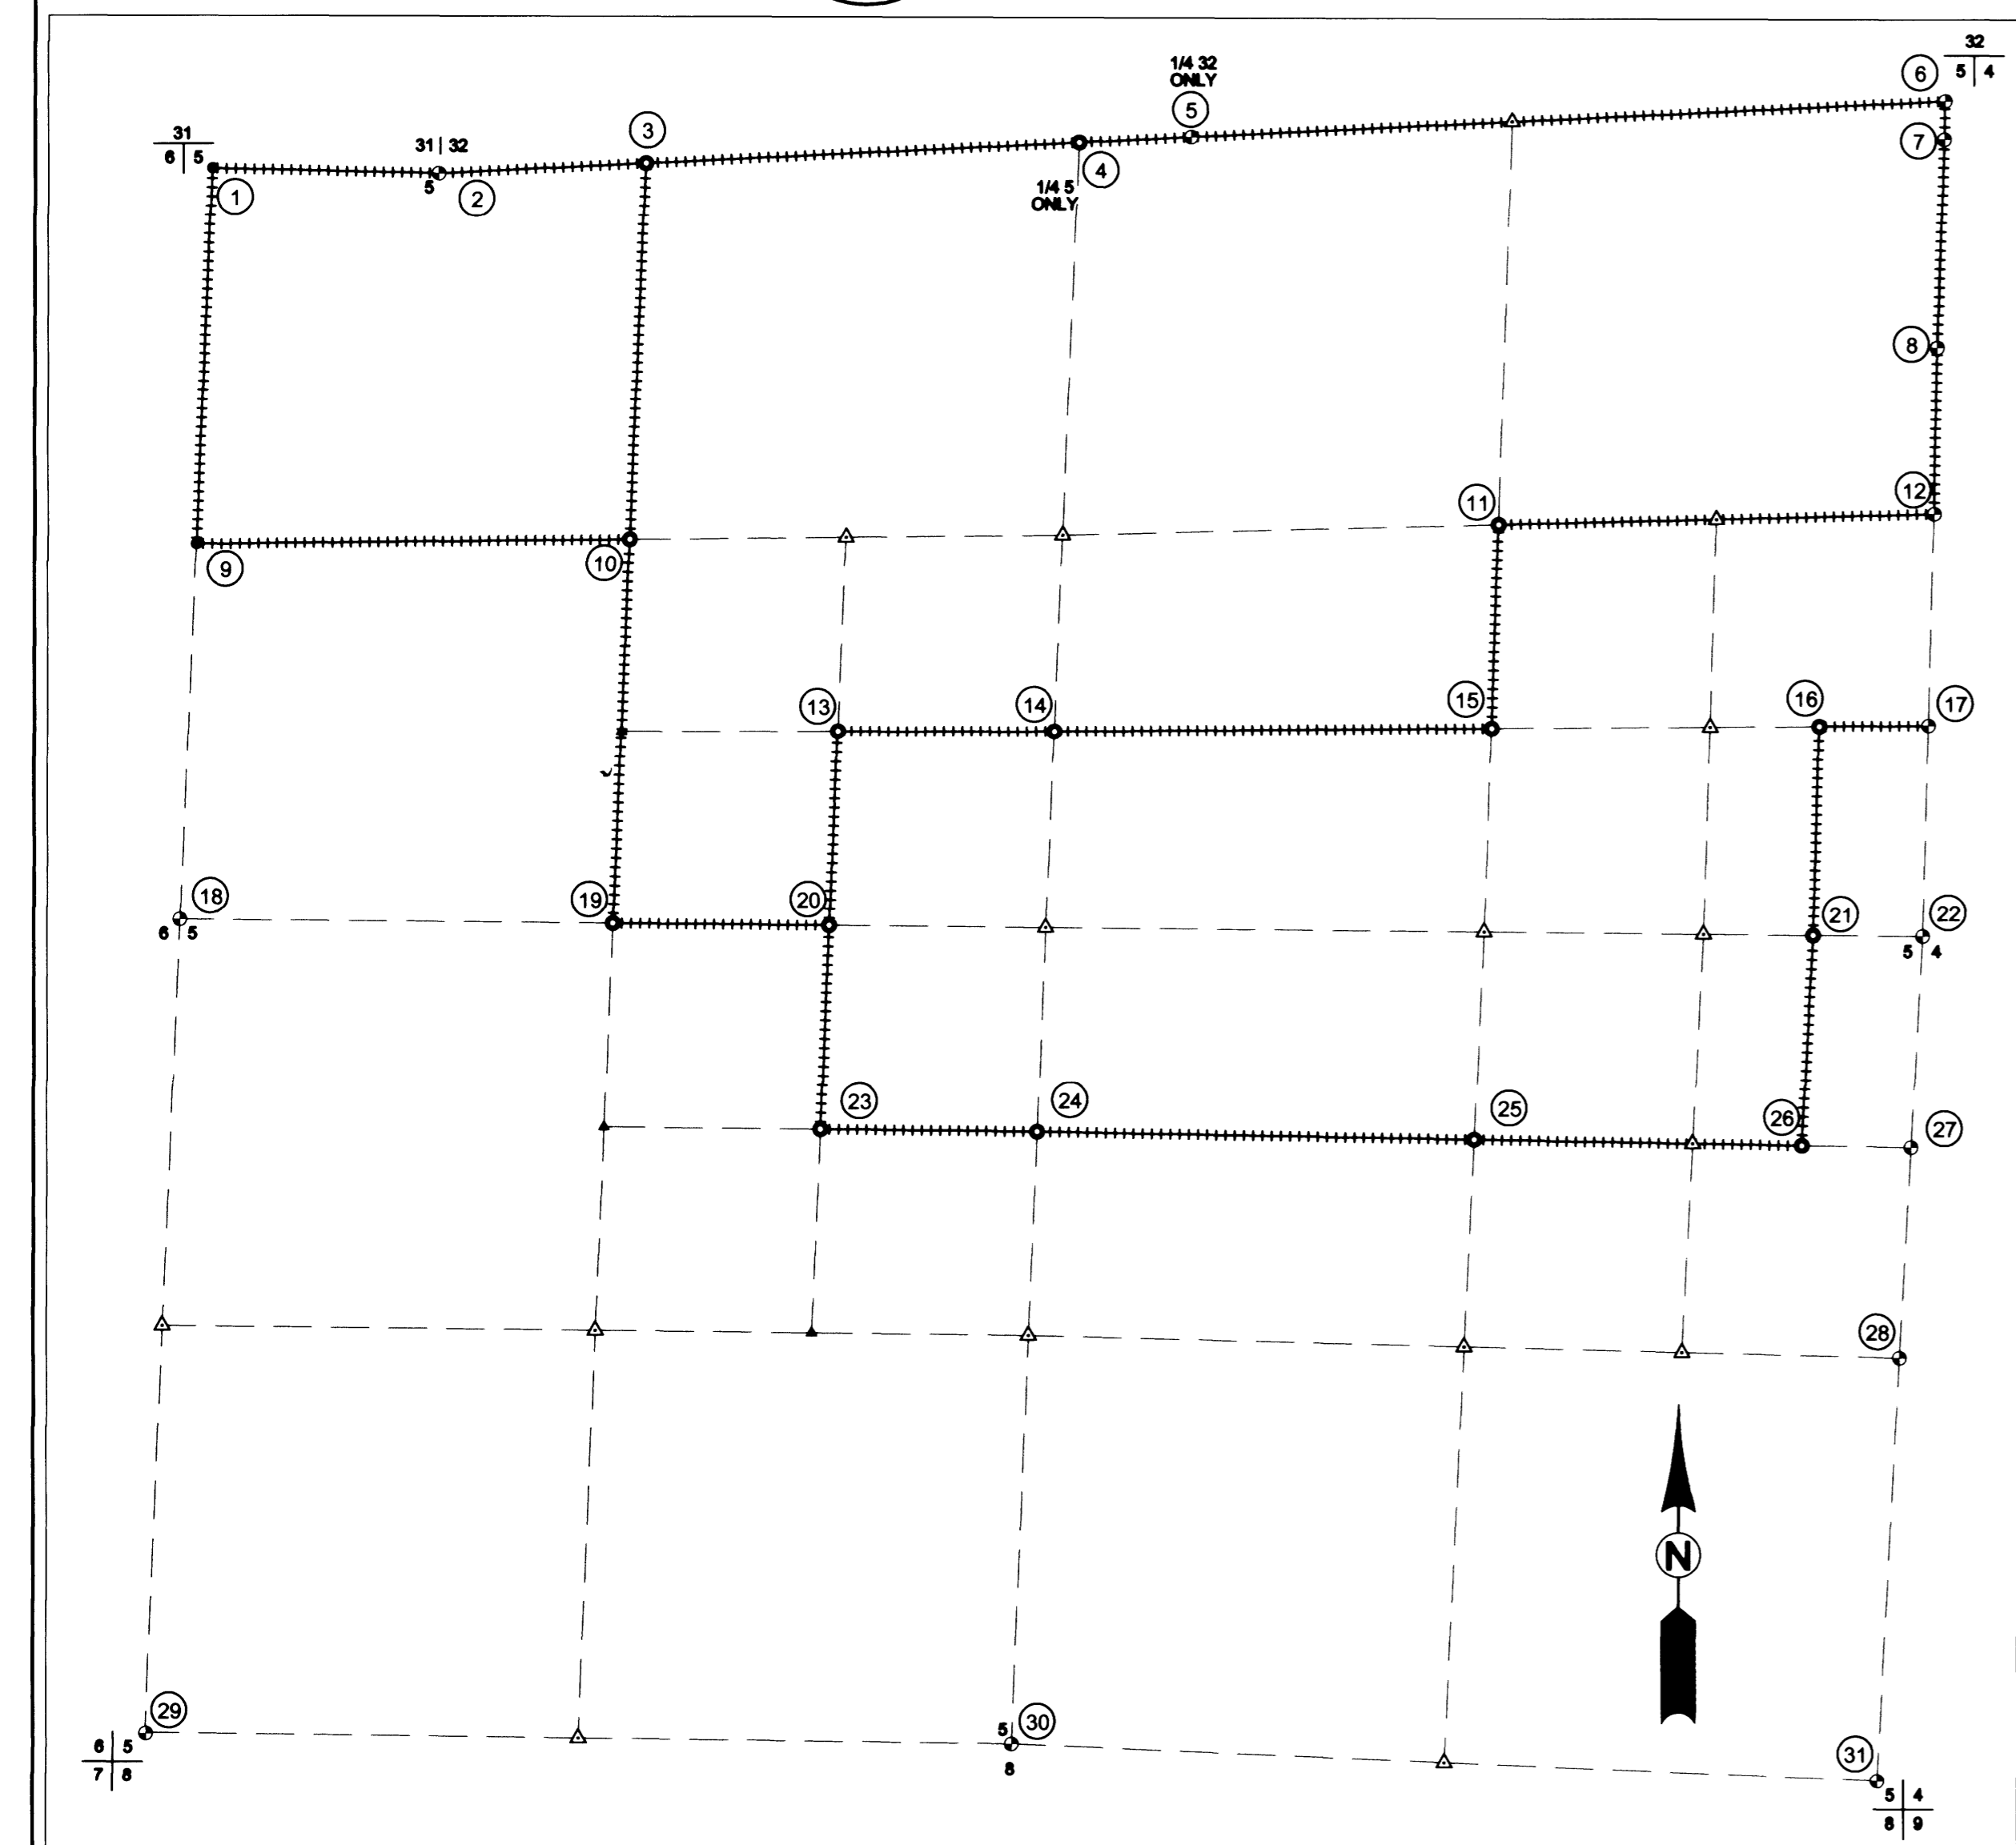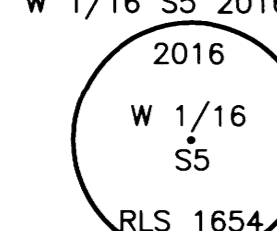


SURVEYED BY:
i.e. ENGINEERING
809 SE Pine Street
Roseburg, Oregon 97470
PHONE (541) 673-0166
FAX (541) 440-9392
email@engineering.com

SURVEYED FOR:
COW CREEK INDIANS
237 NE STEPHENS ST.
ROSEBURG, OR 97470

DWG. BY:DTM
PM:RAQ
SCALE: AS NOTED

PAGE: 2 OF 2
JOB NO:0324-38
DATE: JUNE 2016

RECORD OF SURVEY
LYING IN SECTION 5,
TOWNSHIP 31 SOUTH, RANGE 05 WEST, WILLAMETTE MERIDIAN, DOUGLAS COUNTY, OREGON

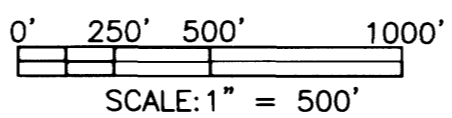

REGISTERED PROFESSIONAL LAND SURVEYOR
OREGON
JULY 14, 1978
RONALD A. GUNBY
1654
EXPIRES: 12/31/2016