


RECORD OF SURVEY  
FOR: ROME CREEK TIMBER 1 LLC  
NW1/4, SW1/4, SECTION 34, T.23 S., R.8 W., W.M.  
DOUGLAS COUNTY, OREGON  
10 JUNE 2016

FILED  
DATE: 7-20-2016 BY: JC  
THIS SURVEY CONSISTS OF:  
MAP: M172-20  
NARRATIVE:  
CORNER RPT:  
DOUGLAS COUNTY  
SURVEYOR

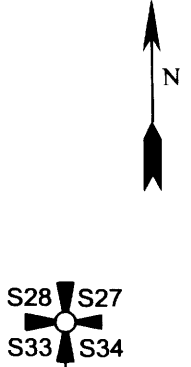

SECTION CORNER SECTIONS 27, 28, 33, 34  
NO MONUMENT FOUND, SEE NARRATIVE FOR DETAILS  
RESET CORNER AT RECORD BEARING AND DISTANCE FROM:  
43" D. FIR SNAG BEARING N 56° E 11.2' - NO MARKS  
SET 5/8" X 30" REBAR WITH 2-1/2" ALUMINUM CAP MARKED AS SHOWN  
43" D. FIR SHATTERED STAUB BEARS S 52° W 33.6' (RECORD 36.3'] - HEALED FACE  
RECORD 40" D. FIR BEARING S 29° E 13.9' - DOWN OUT OF POSITION  
STEEL POST ADJACENT TO CORNER

T23S R8W  
S28|S27  
S33|S34  
2016  
54633LS

LEGEND

- SECTION CORNER AS NOTED
- 1893 GENERAL LAND OFFICE RECORD DATA
- SET MONUMENT AS NOTED
- SECTION CORNER OF MINOR CONTROL AS NOTED
- CHS. CHAINS

NARRATIVE:

THE PURPOSE OF THIS SURVEY IS TO DOCUMENT THE MARKING OF TRUE LINE BETWEEN SECTION 33 AND 34, TOWNSHIP 23 SOUTH, RANGE 8 WEST OF THE WILLAMETTE MERIDIAN.

EXISTING CORNERS WERE TIED BY GROUND TRAVERSE FOR CONTROL AND HELD IN THEIR AS -TIED POSITIONS FOR MARKING TRUE LINE. THE 1/4 CORNER WAS SEARCHED FOR. NO EVIDENCE WAS FOUND. THE PROPORTIONED CORNER POSITION FELL ON WHAT IS NOW A STEEP ROCK FACE WHICH COULD NOT BE OCCUPIED. THE CORNER WAS NOT MONUMENTED AT THE REQUEST OF THE CLIENT. THE NORTH SECTION CORNER MONUMENT APPEARED TO BE LOST TO SLIDE ACTIVITY.

TRUE LINE WAS MARKED WITH RED PAINTED BLAZES, RED FLAGGING AND 5-1/2' GALVANIZED STEEL POSTS SET AT AN AVERAGE INTERVAL OF 200'

THE BASIS OF BEARING FOR THIS SURVEY WAS THE 1893 GENERAL LAND OFFICE SURVEY OF SECTIONS 33, 34, TOWNSHIP 23 SOUTH, RANGE 8 WEST OF THE WILLAMETTE MERIDIAN.

THIS SURVEY WAS PERFORMED USING A NIKON TOTAL STATION AND OPUS GPS.

LINE TREE SECTIONS 33, 34

FOUND 20" D. FIR HOLLOW STUMP WITH TRUNK ADJACENT  
DOUBLE HACK MARKS VISIBLE ON SOUTH FACE OF TRUNK  
SET 5/8" X 30" REBAR IN CENTER OF HOLLOW STUMP WITH  
2-1/2" ALUMINUM CAP MARKED AS SHOWN  
BEARING TREES ESTABLISHED THIS SURVEY  
9" D. FIR BEARS S 72° E 21.9' - BLAZED, SCRIBED AP S34 BT  
21" D. FIR BEARS S 40° W 4.9' - BLAZED, SCRIBED AP S33 BT  
STEEL POST ADJACENT TO CORNER

T23S R8W  
AP  
S33|S34  
2016  
54633LS

BASIS OF BEARING [N 0°02' W 80 CHS.] N 0°02'00" W 5290.84'  
N 0°02'23" W 4522.66'  
[N 0°02' W 68.37 CHS.]

N 0°00'15" E 768.18'  
[N 0°02' W 11.63 CHS.]

S33|S34  
S3  
T24S, R8W

SECTION CORNER SECTIONS 21, 22, 27, 28  
FOUND DOUGLAS COUNTY BRASS CAP MARKED RESET 2008  
WITH THE FOLLOWING ACCESSORIES:  
45" X 5' TALL D. FIR STUMP WITH METAL CAP BEARS N 83° E 19.1'  
50" D. FIR BEARS S 63° W 40.9' - AXE WORK VISIBLE  
15" D. FIR STUMP BEARS N 38° E 22.9' - HEALED FACE  
42" D. FIR STUMP BEARS S 86° W 46.8' - AXE WORK VISIBLE  
7" D. FIR BEARS N 40-1/2° E 14.6' - SCRIBING VISIBLE  
STEEL POST ADJACENT TO CORNER

REGISTERED  
PROFESSIONAL  
LAND SURVEYOR

*Ronald L. Rice*

OREGON  
JULY 9, 2002  
RONALD L. RICE  
54633LS

EXPIRATION DATE: 12-31-2016

FILE NAME		
16-63		
SCALE	DATE	DRAWN BY
500 Ft/in	6-10-2016	RLR
JOB	REVISION	SHEET
OLD BLUE	---	1/1

This map drawn with TRAVERSE PC Software

Northwest Land Surveying, Inc.  
P. O. Box 2827  
FLORENCE, OR 97439 541-997-9201