



FILED
 Date: 12/1/2017 By: [Signature]
 This survey consists of:
 Map: M 173-80 A-B
 Name: [Blank]
 Corner: [Blank]
DOUGLAS COUNTY SURVEYOR

LINE TABLE		
LINE	BEARING	LENGTH
L1	N84°10'04"E (N84°20'48"E)	39.30' 39.24')R1
L2	N65°40'59"E (N65°49'53"E)	107.91' 108.00')R1
L3	N57°02'36"E (N56°44'17"E)	81.95' 82.00')R1
L4	N01°52'50"W (N01°52'50"W)	3.15' R1
L5	N48°08'13"E (N48°09'15"E)	68.92' 68.92')R1
L6	N22°07'55"W (N22°08'23"W)	6.50' 6.50')R3
L7	N49°36'15"W (S49°50'12"E)	80.65' R3
L8	N67°53'34"E (S67°51'37"E)	78.81' R3
L9	N24°53'06"E (S24°59'01"W)	55.57' R3
L10	N50°43'33"E (N52°39'26"E)	59.37' 59.37')R2
L11	N51°07'23"E (N53°03'16"E)	44.51' 44.51')R2
L12	N50°40'18"E (N52°36'11"E)	54.57' 54.57')R2
L13	N45°29'39"E (N47°25'32"E)	46.15' 46.15')R2
L14	N19°41'20"E (N21°37'13"E)	37.53' 37.53')R2
L15	N78°45'07"E (N78°33'13"E)	15.41' 15.52')R2

- LEGEND:**
- SET 5/8" x 30" IRON ROD WITH YELLOW PLASTIC CAP MARKED, "I.E. ENGINEERING"
 - FOUND 5/8" IRON ROD, UNLESS OTHERWISE NOTED
 - △ CALCULATED POINT
 - L# DENOTES LINE TABLE INFORMATION
 - DCSO DENOTES DOUGLAS COUNTY SURVEYOR'S OFFICE
 - () R1 FAIRWAY ESTATES AT UMPQUA GOLF RESORT PUD PH.2, VOL. 23, PG. 21, DOUGLAS COUNTY PLAT RECORDS
 - () R2 INST. NUMBER 2016-12443, OFFICIAL RECORDS OF DOUGLAS COUNTY
 - () R3 INST. NUMBER 2008-00022, OFFICIAL RECORDS OF DOUGLAS COUNTY
 - () R4 REPLAT OF LOT 138, LOT 139 & LOTS 155 THRU 165, KNOLLS ESTATES PUD PHASE 3, VOL.21, PG. 50, DOUGLAS COUNTY PLAT RECORDS

- NOTES:**
1. SEE SHEET 1 FOR ACREAGE NOTE.
 2. SEE SHEET 1 FOR APPROVAL SIGNATURE.
 3. SEE SHEET 1 FOR SURVEY NARRATIVE.

PLANNING DEPARTMENT FILE NO. 17-S003

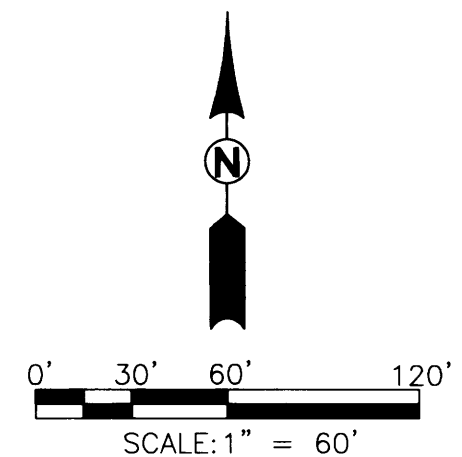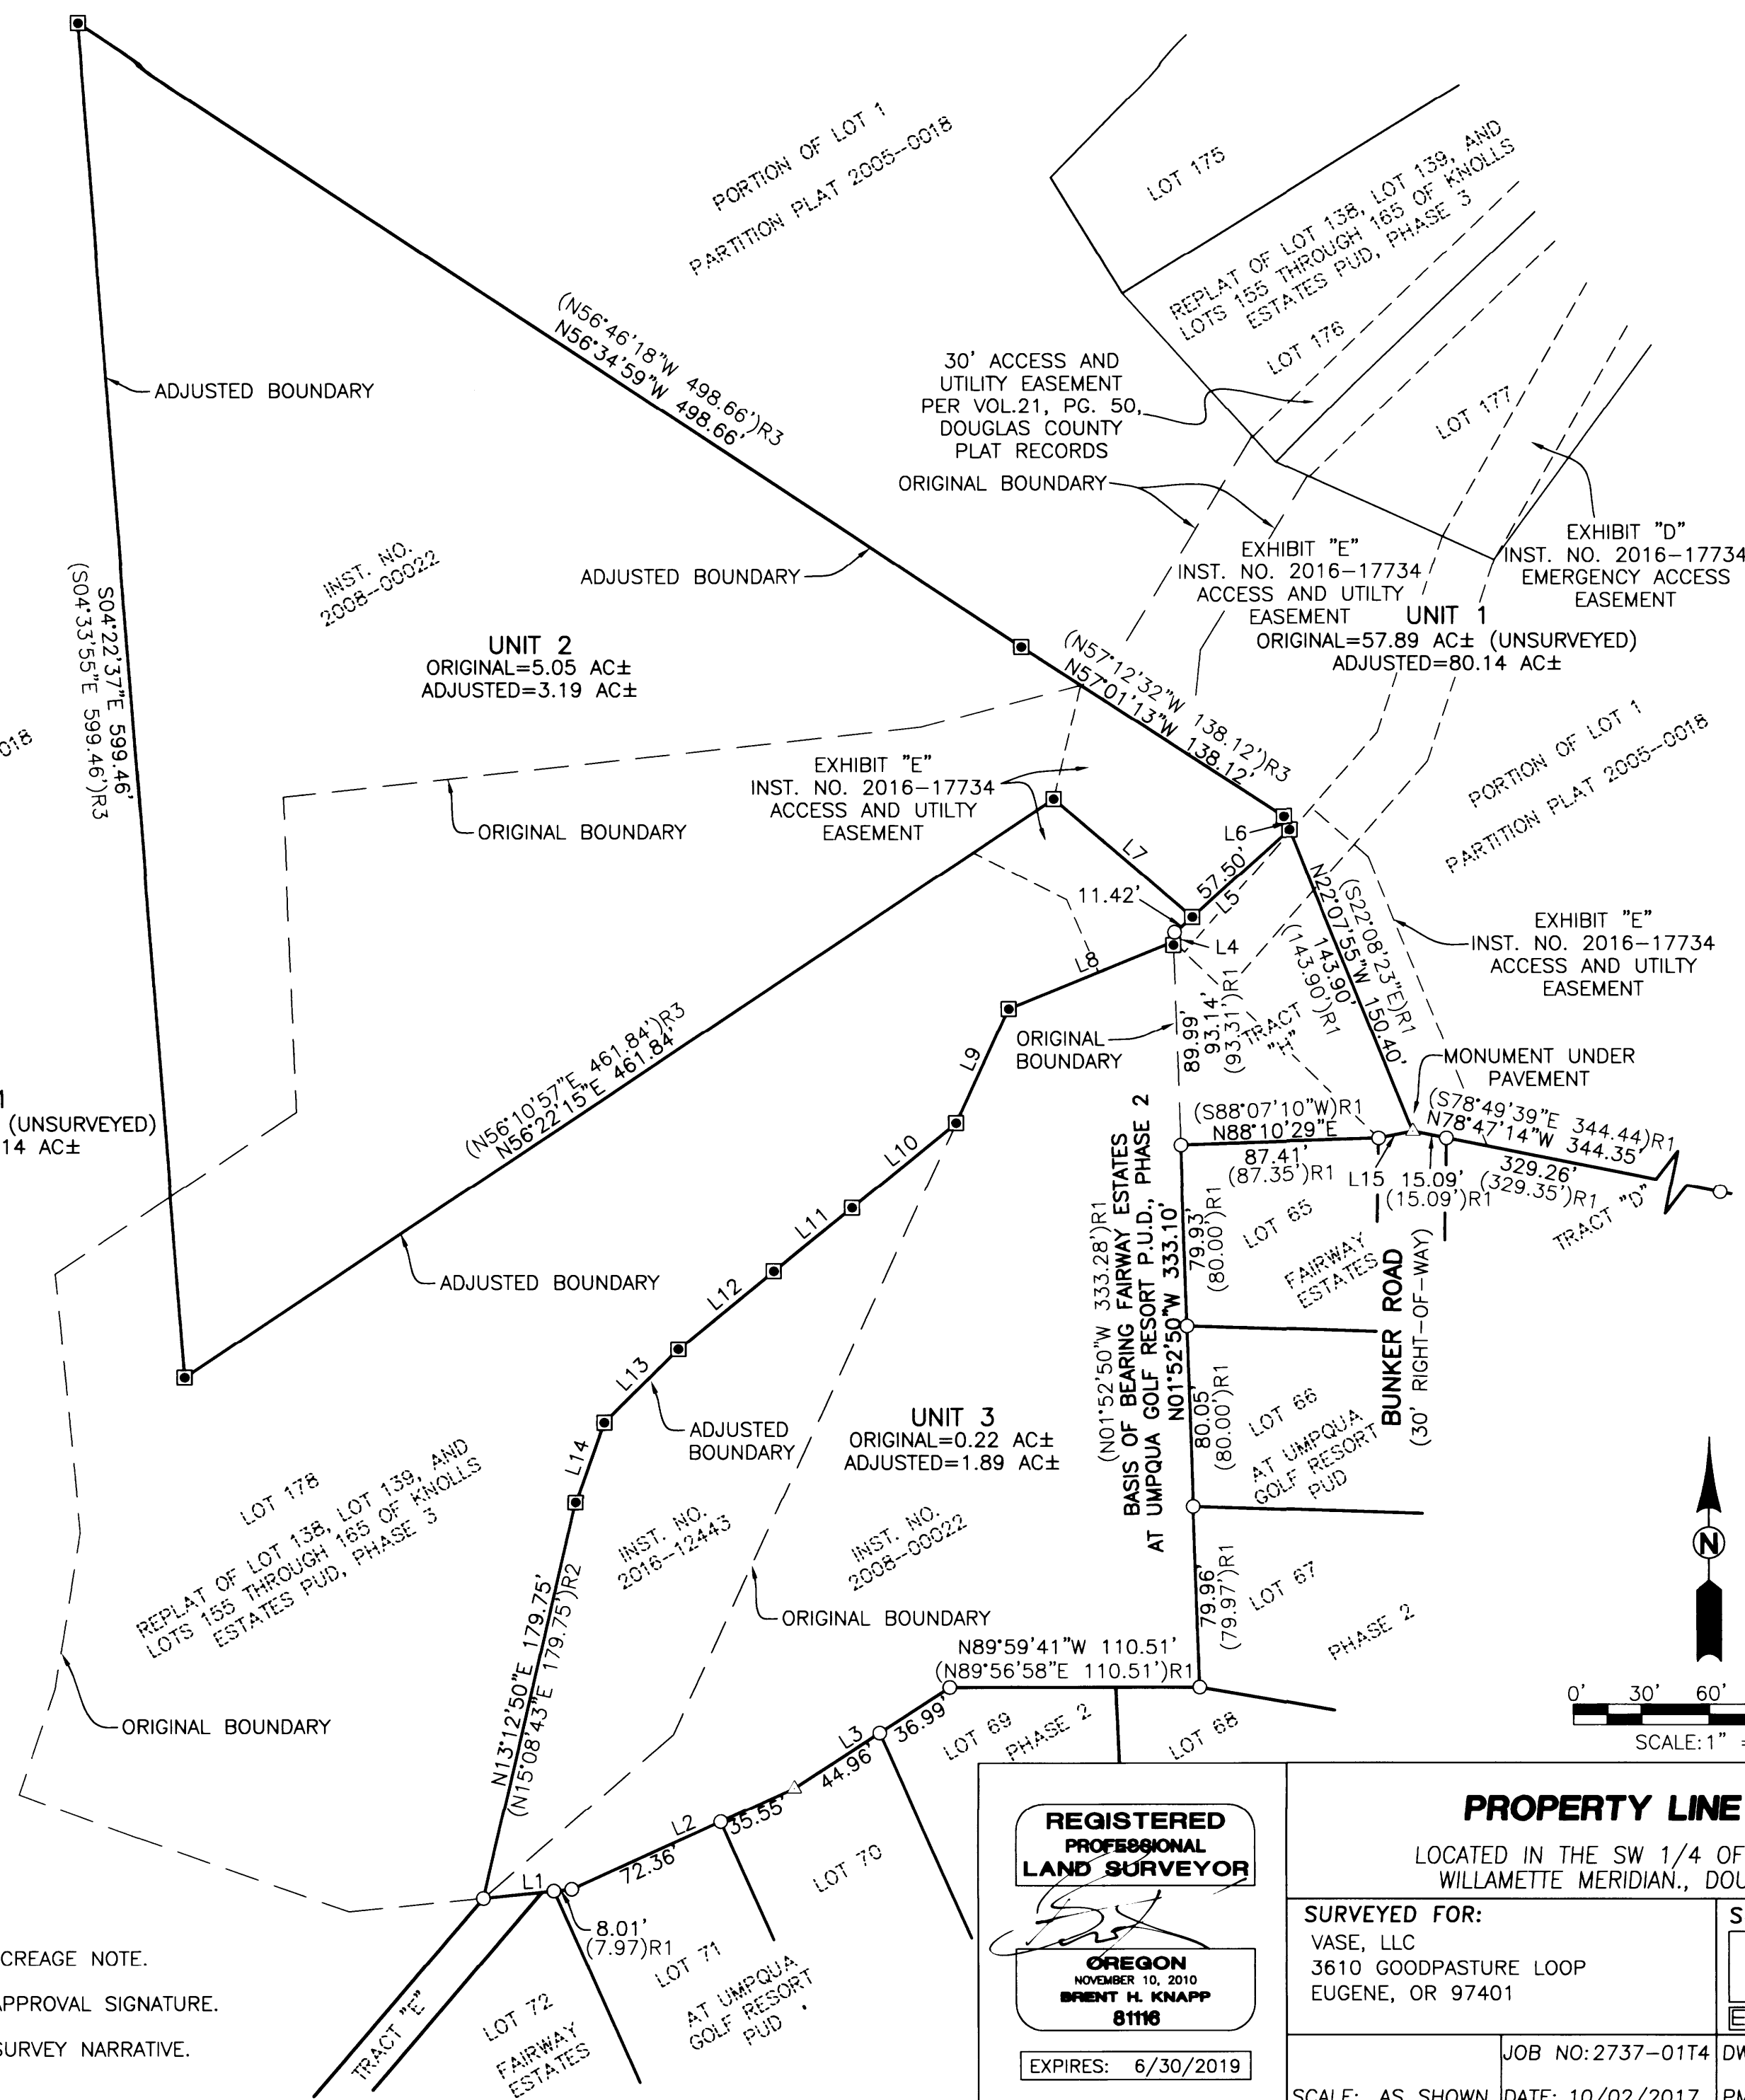

REGISTERED PROFESSIONAL LAND SURVEYOR		PROPERTY LINE ADJUSTMENT	
 BRENT H. KNAPP 8116 EXPIRES: 6/30/2019		LOCATED IN THE SW 1/4 OF SEC. 18 T.25S., R.5W., WILLAMETTE MERIDIAN., DOUGLAS COUNTY, OREGON	
SURVEYED FOR: VASE, LLC 3610 GOODPASTURE LOOP EUGENE, OR 97401		SURVEYED BY: 809 SE Pine Street Roseburg, Oregon 97470 PHONE (541) 673-0166 FAX (541) 440-9392 email@ieengineering.com	
SCALE: AS SHOWN	JOB NO: 2737-0174	DWG. BY: BHK	PAGE: 2 OF 2

MAP FILE 173-80B