

MAP OF SURVEY

SITUATED IN THE NE1/4 OF SEC. 6, T.25S.,
R.1W., W.M., DOUGLAS COUNTY, OREGON.
(ASSESSOR'S MAP: 25-1-00)

FILED
Date: 1-2-2019 By: DL
This survey consists of:
Map: M175-10
Narrative: _____
Corner Rpt: _____
DOUGLAS COUNTY
SURVEYOR

1/4 COR. {SEC. 31 ONLY}
FD. 1951 B.L.M. BRASS CAP
PER INDEX NO. 139700

FOUND B.T.'s: (1896)
24" FIR, NOW 32" SNAG
BEARS N44°W, 39.6'
HEALED BLAZE

24" FIR, NOW BLOW DOWN
ROOT HOLE BEARS S58°W, 12.5'

FOUND B.T.: (1951)
14" FIR, NOW 20"
BEARS N04°45'E, 24.4'
HEALED BLAZE

SECTION COR.
FD. 1966 COUNTY SURVEYOR BRASS
CAP PER INDEX NO. 200700

FOUND B.T.: (1896)
12" FIR, NOW ROTTEN STUMP
BEARS S85°W, 46.2'
HEALED BLAZE


FOUND B.T.'s: (1966)
8" HEMLOCK, NOW 21"
BEARS N27°E, 59.7'
HEALED BLAZE

11" YEW, NOW 14" SNAG
BEARS S27°E, 23.8'
VISIBLE SCRIBE

12" YEW, NOW 12" SNAG
BEARS S64°W, 16.8'
VISIBLE SCRIBE

6" HEMLOCK, NOW 23"
BEARS N73°W, 52.1'
HEALED BLAZE

SET 5' GALV. METAL POST 1.0' WEST

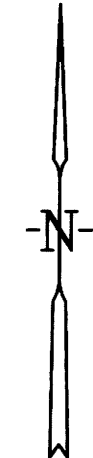

LEGEND

- FOUND MONUMENT AS NOTED
- [] RECORD PER B.L.M DEPENDENT RESURVEY NO. 5974
- () RECORD PER M156-53
- LINE MARKED WITH GALVANIZED METAL POSTS,
BLAZES PAINTED RED AND RED RIBBON.
- BEARINGS BASED ON M156-53

SURVEY NARRATIVE

THE PURPOSE IS TO MARK THE NORTH, EAST AND SOUTH LINE OF THE NORTHEAST QUARTER OF SECTION 6, TOWNSHIP 25 SOUTH, RANGE 1 WEST, WILLAMETTE MERIDIAN, DOUGLAS COUNTY, OREGON.

I RECOVERED AND HELD TO MONUMENTS SET PER INDEX NO. 139700, INDEX NO. 140640, INDEX NO. 140700, INDEX NO. 200640 AND INDEX NO. 200700, WHICH WERE FOUND AS SHOWN ON ANNEXED MAP.

A NIKON DTM-322 TOTAL STATION WAS USED TO EXECUTE THIS SURVEY.

REGISTERED
PROFESSIONAL
LAND SURVEYOR

OREGON
GERALD V. NYGREN
AUGUST 22, 1975
1035
RENEW: 12-31-20

NE1/4, SEC. 6

ILLINOIS MUNICIPAL
RETIREMENT FUND

C1/4 COR.

FD. 1981 B.L.M. BRASS CAP
PER INDEX NO. 140640

FOUND B.T.'s: (1981)
7" FIR, NOW BLOW DOWN
ROOT HOLE BEARS N66°30'E, 18.2'

9" FIR, NOW 15"
BEARS N37°30'W, 15.2'
HEALED BLAZE

FD. 5' METAL POST, SOUTH, 0.20'
SET 5' GALV. METAL POST, EAST, 5.0'

1/4 COR.

FD. 1981 B.L.M. BRASS CAP
PER INDEX NO. 200640

FOUND B.T.'s: (1981)
6" CEDAR, NOW 23"
BEARS S78°E, 29.4'
HEALED BLAZE

6" HEMLOCK, NOW 20"
BEARS N59°30'W, 90.8'
HEALED BLAZE

FD. 5' METAL POST NORTH, 1.0'
SET 5' GALV. METAL POST WEST, 4.0'

[N89°39'W, 2671.68']
S89°42'40"E 2672.52'

T.24S.
T.25S.

2641.64'

S87°58'53"E 30.85'
(N87°54'02"W, 30.71')
[N89°39'W, 31.02']

1/4 COR. {SEC. 6 ONLY}

FD. 1981 B.L.M. BRASS CAP
PER INDEX NO. 140700
0.93' SOUTH OF TOWNSHIP LINE

FOUND B.T.'s: (1981)
16" FIR, NOW 32"
BEARS S33°30'E, 31.7'
HEALED BLAZE

6" FIR, NOW 20"
BEARS N47°30'W, 33.7'
HEALED BLAZE

SET 5' GALV. METAL POST, EAST, 5.0'

[N02°44'E, 2761.44']
[N02°41'59"E, 2760.86' - BASIS OF BEARINGS]
N02°41'59"E 2761.98'

S02°58'42"W 2758.92'
[N03°03'E, 2758.80']

N89°48'40"W 2628.41'
[N89°43'W, 2627.46']

MAP FILE M175-10

MAP FILE M175-10

THIS PLAT WAS PREPARED WITH A HEWLETT-PACKARD DESIGNJET 500 USING HP NO. C4844A INKJET INK ON MILANO NO. JPC4M2 POLYESTER FILM

SURVEYED FOR:
BARNES & ASSOCIATES, INC.
3000 NW STEWART PARKWAY, SUITE 204
ROSEBURG, OR 97471

GERALD V. NYGREN
522 BARKER DRIVE
MERLIN, OREGON 97532

DATE: DEC. 4, 2018
SCALE: 1" = 300'
JOB NO. 18-67