


MAP FILE M175-60

RECORD OF SURVEY  
FOR  
**CAMPBELL-GLOBAL**  
IN THE  
NE 1/4 OF SECTION 34  
T 22 S, R 5 W, W.M.  
DOUGLAS COUNTY, OREGON

FILED  
Date: 7-1-19 By: [Signature]  
This survey consists of:  
Map: M175-60  
Narrative:  
Corner Rpt:  
DOUGLAS COUNTY  
SURVEYOR

MAY 31, 2019

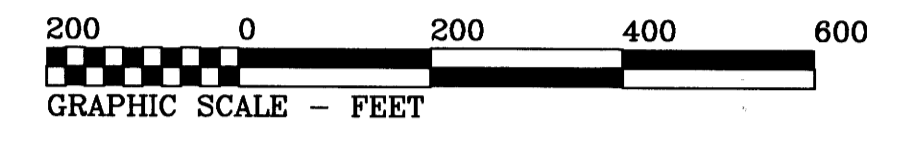

**LEGEND**

- .....Found Monument as noted.
  - + .....Computed position, nothing found or set.
- Data of, or computed from, the following:  
( ) ... County Survey M-53-75  
< > ... County Survey M-61-59

**NARRATIVE**

The purpose of this survey was to document our measurements and corner data on this property. In the history of surveys of this area, the North-South centerline of this Section 34 has been monumented but not properly. It is not my intention to prove or disprove the monuments South of the North 1/4 corner at this time. There is a fence inside these monuments.

REGISTERED  
PROFESSIONAL  
LAND SURVEYOR

[Signature]  
OREGON  
JULY 26, 1988  
ROBERT ALAN COOK  
2336

RENEWS: 12/31/2019

**1/4 CORNER SECTIONS 34 & 35**  
Found 1958 Douglas Co. 2-1/2" brass cap up 8", C.S. File 49/59, about 70' South of Ridge top.  
10" Oak S 45°W 16.8' healed face and tag.  
14" Oak N 16°E 16.6' healed face and tag.  
22" D.Fir West 6.7' healed face and tag

N 89°44'10"W 1320.90'  
(N 89°45'11"W) (1321.52)

**EAST 1/16 CORNER SECTIONS 27 & 34**  
Found 5/8" rod up 6" per M-53-75.

**CORNER OF SEC. 26, 27, 34 & 35**  
Found 1958 Douglas Co. 2-1/2" brass cap up 15", C.S. File 49/59.  
10" Yew N 64°W 29.9 ft. scribes.  
48" D.Fir S 87°W 70.8 ft. healed, tag

N 89°47'27"W 1320.98'  
(N 89°45'11"W) (1321.52)

**1/4 CORNER SECTIONS 27 & 34**  
Found 2-1/2" brass cap up 12" per M-53-75, 6.5 ft West of downed N-S 4' wire fence.  
22" Oak S 19°E 18.9 ft. healed face and tag; per M-53-75

BASIS OF BEARINGS  
(N 0°06'59"E) (1317.01)  
N 00°06'59"E 1317.49'

**NORTH 1/16 CORNER SEC. 34 & 35**  
Found 5/8" rod per M-53-75 up 5" on slight South slope.  
A 5/8" rod per M-35-10 lies N 00°41'32"E 6.80 ft.  
32" D.Fir N 60°E 57.3 ft. healed and tag.  
18" D.Fir stump N 33°W 2.2 ft.

Found 5/8" rod up 4" per M-61-59, with steel post riser South 0.5 ft.

Found 5/8" rod bent and up 6" per M-61-59, we tie spin hole, on Steep SW slope.

Found 5/8" rod up 6" per M-61-59, on SE slope, 100 ft. from creek.

(S 0°06'06"W) (1323.54)  
S 00°07'11"W 1322.37'

<S 0°06'06"W> <1739.8>  
S 00°11'37"W 1738.25

FENCE

Found 5/8" rod per M-53-75 at locally accepted Center-North 1/16 corner Section 34. Monument is down 2" in N-S skid road and 6.2 ft. West of N-S fence.

S 00°25'42"W 415.88'

Found 5/8" rod down 1" per M-61-59, 0.7 ft West of N-S fence and 6 ft. South of fence "T" to SE.

<S 71°47'08"E> <1057.63>

<S 86°47'E> <614.87>

<S 58°42'30"E> <458.61>  
S 58°22'20"E 458.21'

S 19°57'28"E <321.93>  
S 19°59'05"E 322.62'

N 89°54'27"E 520.23'  
<N 89°57'50"E> <520.4>

(N 0°06'59"E) (1317.01)  
N 00°06'37"E 1316.50'



**Northstar**  
SURVEYING

720 NW 4TH ST. CORVALLIS, OR 97330  
EMAIL: bcook@northstarsurveying.com  
(541) 757-9050 PROJECT No. 19132

MAP FILE M175-60