

206--FOUND MONUMENT

CORNER P-3, (GCDB 140340)
CENTER 1/4 CORNER OF SECTION 19 T. 30 S., R. 08 W., W.M.

APRIL 1980
BLM DEPENDENT RESURVEY BY JAMES E. JELLEY AND WAYNE L. ROGERS, CADASTRAL SURVEYORS
UNDER GROUP #1021
(DCSO VOLUME 45, PAGES 17282-3)
POINT FOR THE 1/4 SECTION CORNER OF SECTION 19 AT THE INTERSECTION WITH THE E & W CENTERLINE.
SET AN IRON POST, 28" LONG, 2-1/2" DIA., 24" IN THE GROUND, WITH BRASS CAP MARKED:
T30S RBW C 1/4 S19 1980
FROM WHICH:
A FIR, 6" DIA., BEARS S 27-1/2' E, 11-1/2 LKS. DIST. MKD: C 1/4 S19 BT
A FIR, 6" DIA., BEARS N 25-1/2' W, 6 LKS. DIST. MKD: C 1/4 S19 BT
(SET CHAINING NAIL AT SIDE CENTER, BT SIGNS ON FRONT AND REAR, AND PAINTED RED BAND FOR EXISTING BT)

MAY 24, 2023
GARRETT FINCH AND CREW WITH MINISTER AND GLAESER SURVEYING
FOUND A 3-1/4" BLM BRASS CAP, 0.4 FT ABOVE GROUND FROM WHICH:
A 12" FIR BEARS N 20' W, 4.3 FT, WITH HEALED BLAZE AND BT SIGNS (1980)
A 14" FIR BEARS S 30' E, 7.8 FT, WITH HEALED BLAZE AND BT SIGNS (1980)
(SET CHAINING NAIL AT SIDE CENTER, NAIL AND WASHER STAMPED "PLS 2830" AT BASE OF BLAZE, BT SIGNS ON FRONT AND BACK AND PAINTED RED BAND FOR NEW BT)

207--FOUND MONUMENT

CORNER P-5, (GCDB 200340)
1/4 CORNER OF SECTIONS 19 & 20 T. 30 S., R. 08 W., W.M.

JULY 28, 1882
GLO SURVEY BY W.H. BYARS
UNDER CONTRACT #456
(DCSO RECORDS VOLUME 17, PAGE 7359)
SET AN OAK POST, 3 FT LONG, 3" SQUARE, 18" IN THE GROUND, FOR 1/4 SECTION CORNER, MARKED 1/4 S ON W FACE; FROM WHICH:
AN OAK, 12" DIA., BEARS S 75' E, 41 LKS. MKD: 1/4 S BT
A LAUREL, 12" DIA., BEARS S 5' W, 38 LKS. MKD: 1/4 S BT

SEPTEMBER 1965
DCSO VRT (C.S. FILE 53/67-27)
REPORTED AS NOT FOUND

AUGUST - SEPTEMBER 1972
BLM DEPENDENT RESURVEY BY CHARLES E. AKIN, JR., CADASTRAL SURVEYOR
UNDER GROUP #795
(DCSO RECORDS VOLUME 37, PAGES 15227-8)
POINT FOR 1/4 SECTION CORNER OF SECTIONS 19 & 20, AT PROPORTIONATE DISTANCE; THERE IS NO REMAINING EVIDENCE OF THE ORIGINAL CORNER.
SET AN IRON POST, 28 LONG, 2-1/2" DIA., 22" IN THE GROUND WITH BRASS CAP MARKED:
T30S RBW 1/4 S19 S20 1972
FROM WHICH:
A FIR, 20" DIA., BEARS S 75' E, 49 LKS. MKD: 1/4 S20 BT
A FIR, 18" DIA., BEARS WEST, 45 LKS. MKD: 1/4 S19 BT

JUNE 1973
BRUCE A. SHANER FOR MOORE MILL AND LUMBER CO.
(MAP FILE M49-25)
FOUND BRASS CAP MKD. U.S. DEPT. OF THE INTERIOR CADASTRAL SURVEY BUREAU OF LAND MANAGEMENT T30S RBW S19 S20 1972 FROM WHICH:
A 10" DOUGLAS FIR BEARS S 75' E, 32.3' WITH SCRIBE VISIBLE
A 16" DOUGLAS FIR BEARS WEST, 28.1' WITH SCRIBE VISIBLE (REC. 29.7')

APRIL 1980
BLM DEPENDENT RESURVEY BY JAMES E. JELLEY & WAYNE L. ROGERS, CADASTRAL SURVEYOR
UNDER GROUP #1021
(DCSO RECORDS VOLUME 45, PAGES 17283-4)
THE 1/4 CORNER OF SECTIONS 19 & 20, MONUMENTED WITH AN IRON POST, 2-1/2" DIA., FIRMLY SET, PROJECTING 6" ABOVE GROUND, WITH BRASS CAP (PROPERLY) MARKED.
FROM WHICH BEARING TREES MARKED BY AKIN:
A FIR, 13" DIA., BEARS S 75' E, 49 LKS., WITH HEALED BLAZE
A FIR, 20" DIA., BEARS WEST, 42 LKS., WITH ILLEGIBLE SCRIBE MARKS VISIBLE ON PARTIALLY HEALED BLAZE (REC 45 LKS.)

MAY 2020 - FEBRUARY 2021
BLM DEPENDENT RESURVEY BY JEFFREY O. COVINGTON, CADASTRAL SURVEYOR
UNDER GROUP #2972
(DCSO RECORDS VOLUME 59, PAGE 23965)
THE 1/4 SECTION CORNER OF SECTIONS 19 & 20, REPORTED BY JELLEY AND ROGERS IN 1980, MONUMENTED WITH AN IRON POST, 2-1/2" DIA., FIRMLY SET, PROJECTING 6" ABOVE GROUND, WITH BRASS CAP (PROPERLY) MARKED.
FROM WHICH THE REMAINS OF THE BEARING TREES REPORTED BY JELLEY AND ROGERS:
A FIR STUMP, 20" DIA., BEARS S 75' E, 32.3 FT, WITH HEALED BLAZE
A FIR, 23" DIA., BEARS S 88-1/2' W, 27.7 FT, WITH HEALED DOUBLE BLAZE (RECORD W, 29.7 FT) AND A NEW BEARING TREE:
A CEDAR, 7" DIA., BEARS N 64-3/4' E, 27.3 FT, MKD: 1/4 S20 BT
EACH NEW BT HAS A 2-1/2"x1/4" MAGNETIC NAIL (MAG NAIL) DRIVEN AT THE BASE RIGHT SIDE CENTER & EACH MONUMENT ESTABLISHED OR REMONUMENTED AS A MAGNET DEPOSITED IN A WHITE PLASTIC CASE AT THE BASE OF THE STAINLESS STEEL POST. ALUMINUM ANGLE IRON DRIVEN ALONGSIDE EACH MONUMENT.


MAY 26, 2023
GARRETT FINCH AND CREW WITH MINISTER AND GLAESER SURVEYING
FOUND A 3-1/4" BLM BRASS CAP, 0.5 FT ABOVE GROUND FROM WHICH:
A 24" FIR BEARS WEST, 27.7 FT, WITH HEALED BLAZE AND MOORE MILL & LUMBER AND BT SIGNS (1972)
AN 8" CEDAR BEARS N 64-3/4', 27.3 FT, WITH BT SIGNS AND VISIBLE SCRIBE MKD: 1/4 S20 BT (2020)
A 20" STUMP BEARS S 75' E, 32.3 FT, WITH HEALED BLAZE (1972)
(SET CHAINING NAIL AT SIDE CENTER, BT SIGNS ON FRONT AND REAR, AND PAINTED RED BAND FOR EXISTING BT'S)

RECORD OF SURVEY

LOCATED IN A PORTION OF
GOV'T LOTS 1, 2, 5, 6 AND
THE NW 1/4, NE 1/4 AND SW 1/4
OF SECTION 19, T. 30 S., R. 8 W., W.M.
BEETLE BATTLE SOUTH-TASK D
DOUGLAS COUNTY, OREGON
CONTRACT NO. 1204T020D0010
TASK ORDER NO. 140L4322F0063

FILED
DATE: 12-5-2023 BY: DR
THIS SURVEY CONSISTS OF:
MAP: M178-74A-D
NARRATIVE:
CORNER RPT:
DOUGLAS COUNTY
SURVEYOR

11/28/2023
REGISTERED
PROFESSIONAL
LAND SURVEYOR
Daniel A. Renton
OREGON
JUNE 30, 1997
DANIEL A. RENTON
2830
Expires 12-31-2024

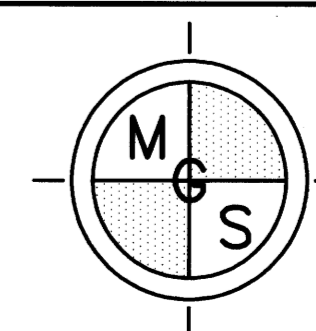

MINISTER-GLAESER
SURVEYING INC.
2200 E. EVERGREEN BLVD.
VANCOUVER, WA 98661
(360) 694-3313

SCALE: N/A
JOB NO. 22-319
DATE: 11/28/2023
CALC BY: DAR
DRAWN BY: RDH
CHECKED BY: DAR
SHEET 4 OF 4