

203-FOUND MONUMENT

CORNER E-7, (GCDB 240600) 1/4 CORNER OF SECTIONS 5 & 8 T. 31 S., R. 08 W., W.M.

JULY 28, 1882 GLO SURVEY BY W.H. BYARS, DEPUTY SURVEYOR UNDER CONTRACT #456 (DCSO RECORDS VOLUME 19, PAGE 8162) MARKED A HEMLOCK POST 3 FT LONG, 3" SQUARE, 18" IN THE GROUND, 1/4 S FOR THE 1/4 SECTION CORNER FROM WHICH: A HEMLOCK, 14" DIA., BEARS EAST, 20 LKS, MKD: 1/4 S BT A HEMLOCK, 12" DIA., BEARS S 85° W, 33 LKS. MKD: 1/4 S BT

NOVEMBER 1960 - SEPTEMBER 1962 BLM DEPENDENT RESURVEY BY C. ALBERT WHITE, HAROLD D. CORBIN, CADASTRAL SURVEYORS AND DONALD R. BECK, SURVEY TECHNICIAN UNDER GROUP #350 (DCSO RECORDS VOLUME 32, PAGES 13209-10)

THE 1/4 SECTION CORNER OF SECTIONS 5 & 8, DETERMINED AT RECORD BEARING AND DISTANCE FROM THE REMAINS OF THE ORIGINAL BEARING TREES: A STUMP HOLE, WITH ROOTS OF A HEMLOCK REMAINING, BEARS EAST 20 LKS A HEMLOCK, 16" DIA., BEARS S 85° W, 33 LKS, WITH OLD AXE MARKS VISIBLE ON OPENED BLAZE AT CORNER POINT: SET IRON POST, 28" LONG, 4" DIA, 25" IN THE GROUND, WITH BRASS CAP MKD: 1/4 S5 S8 T31S R8W 1961 FROM WHICH NEW BT'S: A HEMLOCK, 8" DIA., BEARS N 3-1/2° W, 48 LKS, MKD: 1/4 S5 BT A HEMLOCK, 10" DIA., BEARS S 18° W, 17 LKS, MKD: 1/4 S8 BT

AUGUST - OCTOBER 1973 BLM DEPENDENT RESURVEY BY CHARLES E. AKIN, JR., CADASTRAL SURVEYOR UNDER GROUP #819 (DCSO RECORDS VOLUME 36, PAGES 14935-6) THE 1/4 SECTION CORNER OF SECTIONS 5 & 8, MONUMENTED WITH AN IRON POST, 2-1/2" DIA., FIRMLY SET, PROTRUDING 6" ABOVE GROUND, WITH BRASS CAP (PROPERLY) MKD, FROM WHICH THE REMAINS OF THE ORIGINAL BEARING TREES: A STUMP HOLE, WITH ROOTS OF A HEMLOCK REMAINING, BEARS EAST, 20 LKS A HEMLOCK, 17" DIA., BEARS S 85° W, 33 LKS, WITH OLD AXE MARKS VISIBLE ON OPENED BLAZE AND BEARING TREES MARKED BY WHITE, CORBIN AND BECK: A HEMLOCK, 10" DIA., BEARS N 3-1/2° W, 48 LKS, WITH FRAGMENTARY SCRIBE MARKS VISIBLE ON PARTIALLY HEALED BLAZE A HEMLOCK, 12" DIA., BEARS S 18° W, 17 LKS, WITH FRAGMENTARY SCRIBE MARKS VISIBLE ON PARTIALLY HEALED BLAZE

JUNE 6, 2023 GARRETT FINCH AND CREW WITH MINISTER AND GLAESER SURVEYING FOUND A 3-1/4" BLM BRASS CAP, 0.6 FT ABOVE GROUND FROM WHICH: A 14" SNAG (60 FT HIGH) BEARS S 18° W, 10.5 FT WITH HEALED DOUBLE BLAZE AND BT SIGN (1960) A ROTTED STUMP (30" HIGH) BEARS S 82° W, 22.8 FT (1973) (SET CHAINING NAIL AT SIDE CENTER, BT SIGNS ON FRONT AND REAR, AND PAINTED RED BAND FOR EXISTING BT'S)

ESTABLISHED THE FOLLOWING: A 15" HEMLOCK BEARS S 46° W, 9.9 FT MKD: 1/4 S8 BT A 15" FIR BEARS N 57° E, 8.7 FT MKD: 1/4 S5 BT (SET CHAINING NAIL AT SIDE CENTER, NAIL AND WASHER STAMPED "PLS 2830" AT BASE OF BLAZE, BT SIGNS ON FRONT AND BACK AND PAINTED RED BAND FOR NEW BT)

204-FOUND MONUMENT

CORNER A-7, (GCDB 240700) 1/4 CORNER OF SECTION 5 T. 31 S., R. 08 W., W.M. AND SECTION 32 T. 30 S., R. 08 W., W.M.

JULY 28, 1882 GLO SURVEY BY W.H. BYARS, DEPUTY SURVEYOR UNDER CONTRACT #456 (DCSO RECORDS VOLUME 17, PAGES 7308-09) SET A FIR POST 3 FT LONG, 3" SQUARE, 18" IN THE GROUND MKD: 1/4 S ON NORTH SIDE FOR THE 1/4 SECTION CORNER, FROM WHICH: A FIR, 6" DIA. BEARS S 25° E, 19 LKS. DIST. MKD: 1/4 S BT A FIR, 12" DIA., BEARS N 54° W, 10 LKS. DIST. MKD: 1/4 S BT

NOVEMBER 1960 - SEPTEMBER 1962 BLM DEPENDENT RESURVEY BY C. ALBERT WHITE, HAROLD D. CORBIN, CADASTRAL SURVEYORS AND DONALD R. BECK, SURVEY TECHNICIAN UNDER GROUP #446 (DCSO RECORDS VOLUME 31, PAGES 13191)

THE 1/4 SECTION CORNER, DETERMINED AT RECORD BEARING AND DISTANCE FROM THE REMAINING ORIGINAL BEARING TREE: A FIR 27" DIA., BEARS N 54° W, 10 LKS. DIST. MKD: 1/4 ON PARTIALLY OPENED BLAZE AT THE CORNER POINT: SET AN IRON POST, 28" LONG, 2-1/2" DIA., 22" IN THE GROUND, WITH BRASS CAP MKD: T30S R8W 1/4 S32 S5 T31S 1960 FROM WHICH NEW BEARING TREES: A FIR 19" DIA., BEARS N 30° W, 49 LKS. DIST. MKD: 1/4 S32 BT A FIR 15" DIA., BEARS S 77° E, 20 LKS. DIST. MKD: 1/4 S5 BT

MARCH 1974 R.E. STUNTZNER FOR RESERVATION RANCH (MAP FILE M53-9) FOUND IRON PIPE WITH 1960 BRASS CAP AND BT'S, BY CADASTRALS

NOVEMBER 1976 HOWARD W. JOHNSTONE FOR ROSEBURG LUMBER COMPANY FOUND 1960 CADASTRAL BRASS CAP FROM WHICH: A 28" FIR BEARS N 56° W, 6.7 FT OBT A 16" FIR STUMP BEARS S 78-1/2° E, 12.0 FT

JUNE 5, 2023 GARRETT FINCH AND CREW WITH MINISTER AND GLAESER SURVEYING FOUND A 3-1/4" BLM BRASS CAP, 0.5 FT ABOVE GROUND FROM WHICH: A 25" ROTTED STUMP (3 FT HIGH) BEARS N 52° W, 6.6 FT (1882) A 15" ROTTED STUMP BEARS S 82° E, 12.1 FT WITH HEALED BLAZE, BARK SCRIBE "X", PROP LINE SIGN (1960) A 23" ROTTED STUMP BEARS N 28° W, 31.3 FT (1960) (SET CHAINING NAIL AT SIDE CENTER, BT SIGNS ON FRONT AND REAR, AND PAINTED RED BAND FOR EXISTING BT'S)

ESTABLISHED THE FOLLOWING: A 17" FIR BEARS N 22° E, 25.8 FT MKD: 1/4 S32 BT A 9" FIR BEARS S 41° E, 19.85 FT MKD: 1/4 S5 BT (SET CHAINING NAIL AT SIDE CENTER, NAIL AND WASHER STAMPED "PLS 2830" AT BASE OF BLAZE, BT SIGNS ON FRONT AND BACK AND PAINTED RED BAND FOR NEW BT'S)

205-FOUND MONUMENT

CORNER A-5, (GCDB 200100) CORNER OF SECTIONS 5 & 6 T. 31 S., R. 08 W., W.M. AND SECTIONS 31 & 32 T. 30 S., R. 08 W., W.M.

JULY 28, 1882 GLO SURVEY BY W.H. BYARS, DEPUTY SURVEYOR UNDER CONTRACT #456 (DCSO RECORDS VOLUME 17, PAGE 7308) SET A CEDAR POST 4-1/2 FT LONG, 4" SQUARE, 24" IN THE GROUND, FOR THE CORNER TO SECTIONS 5, 6, 31 AND 32, MARKED T30S R8W S32 ON THE NORTHEAST FACE, T31S S5 ON THE SOUTHEAST FACE; S6 ON THE SOUTHWEST FACE; AND S31 ON THE NORTHWEST FACE, ALSO 5 NOTCHES ON THE EAST AND 1 NOTCH ON THE WEST ANGLES OF THE SAME, FROM WHICH: A FIR 12" DIA., BEARS N 21° E, 56 LKS. DIST. MKD: T30S R8W S32 BT A FIR 50" DIA., BEARS S 16° E, 40 LKS. DIST. MKD: T31S R8W S5 BT A FIR 14" DIA., BEARS S 53° W, 28 LKS. DIST. MKD: T31S R8W S6 BT A FIR 10" DIA., BEARS N 40° W, 8 LKS. DIST. MKD: T30S R8W S31 BT

NOVEMBER 1960 - SEPTEMBER 1962 BLM DEPENDENT RESURVEY BY C. ALBERT WHITE, HAROLD D. CORBIN, CADASTRAL SURVEYORS AND DONALD R. BECK, SURVEY TECHNICIAN UNDER GROUP #446 (DCSO RECORDS VOLUME 31, PAGES 13190-91)

THE SECTION CORNER, DETERMINED AT RECORD BEARING AND DISTANCE FROM THE REMAINING ORIGINAL BEARING TREES: A FIR 62" DIA., BEARS S 16° E, 40 LKS. DIST. MKD: T31S R8W S5 BT, ON BARK BLAZE A FIR SNAG 10" DIA., N 40° W, 8 LKS. DIST. MKD: W, ON OPEN BLAZE AT THE CORNER POINT: SET AN IRON POST, 28" LONG, 2-1/2" DIA., 22" IN THE GROUND, WITH BRASS CAP MKD: T30S R8W S31 S32 S6 S5 T31S 1962 FROM WHICH NEW BEARING TREES: A FIR 23" DIA., BEARS N 85° E, 66 LKS. DIST. MKD: T30S R8W S32 BT A FIR 15" DIA., BEARS S 42° E, 25 LKS. DIST. MKD: T31S R8W S5 BT A CEDAR 6" DIA., BEARS S 89° W, 43 LKS. DIST. MKD: T31S R8W S6 BT A FIR 47" DIA., BEARS N 21-1/2° W, 43 LKS. DIST. MKD: T30S R8W S31 BT (ON BARK)

SEPTEMBER 1972 US DEPARTMENT OF INTERIOR BUREAU OF LAND MANAGEMENT SURVEY BY DON E. GARRETT RPLS 544 CONTRACT #53500-CT2-334(N) (MAP FILE M91-10) FOUND BRASS CAP MARKED: US CADASTRAL SURVEY BLM 1962 S5 S6 T31S & S31 S32 T30S R8W 62" FIR BEARS S 17-1/2° E, 40 LKS. (BARK SCRIBE) 18" FIR BEARS S 42° E, 25 LKS. (SHOWS SCAR) 47" FIR BEARS N 21° W, 42 LKS. (BARK SCRIBE) 26" FIR BEARS N 85° E, 66 LKS. (SHOWS SCRIBING) 8" CEDAR BEARS S 89° W, 42 LKS. (SHOWS SCRIBING)

AUGUST - OCTOBER 1973 BLM RESURVEY BY CHARLES E. AKIN, JR., CADASTRAL SURVEYOR UNDER GROUP #819 (DCSO RECORDS VOLUME 36, PAGES 14937-38)

THE SECTION CORNER, MONUMENTED WITH AN IRON POST 2-1/2" DIA., FIRMLY SET, PROTRUDING 6" ABOVE GROUND WITH BRASS CAP MARKED IN 1962, FROM WHICH REMAINS OF THE ORIGINAL BEARING TREES: A FIR SNAG 63" DIA., BEARS S 16° E, 40 LKS. DIST., WITH FRAGMENTARY SCRIBE MARKS VISIBLE ON BARK BLAZE A FIR SNAG 12" DIA., BEARS N 40° W, 8 LKS. DIST., WITH NO MARKS VISIBLE ON ROTTED BLAZE AND BEARING TREES MARKED BY WHITE, CORBIN AND BECK: A W.FIR 18" DIA., BEARS S 42° E, 25 LKS. DIST., WITH HEALED BLAZE A CEDAR 8" DIA., BEARS S 89° W, 43 LKS. DIST., WITH SCRIBE MARKS T31S R8W S6 BT, VISIBLE ON PARTIALLY HEALED BLAZE A FIR 50" DIA., BEARS N 21-1/2° W, 43 LKS. DIST., WITH SCRIBE MARKS T30S R8W S31 BT, VISIBLE ON BARK BLAZE AND BEARING TREES MARKED BY JOHN POWELL, DEPUTY COUNTY SURVEYOR IN 1967: A W.FIR 14" DIA., BEARS N 2-1/2° E, 48 LKS. DIST., WITH HEALED BLAZE A W.FIR 26" DIA., BEARS N 21° E, 56 LKS. DIST., WITH HEALED BLAZE (NOTE: THE ABOVE BT'S REPORTED AS TO BE BY POWELL WERE NOT OF RECORD IN ANY MATERIALS GIVEN TO ME FOR THIS PROJECT. A "RENEWAL" NUMBER WAS NOT LISTED ON THE "OLD" VISUAL PAGE.) V. LAUGEN, JUNE 1977

MARCH 1974 R.E. STUNTZNER FOR RESERVATION RANCH (MAP FILE M53-9) FOUND IRON PIPE WITH 1962 BRASS CAP AND BT'S, BY CADASTRALS

JUNE 7, 2023 GARRETT FINCH AND CREW WITH MINISTER AND GLAESER SURVEYING FOUND A 3-1/4" BLM BRASS CAP, 0.5 FT ABOVE GROUND FROM WHICH: A 12" ROTTED STUMP (18" HIGH) BEARS N 30° W, 5.2 FT (1973) A 50" SNAG (80 FT HIGH) BEARS N 16° W, 29.4 FT WITH BARK SCRIBE MKD: T30S R8W S31 BT (1972) A 59" STUMP METAL TOP (8 FT HIGH) BEARS S 16° E, 27.7 FT WITH HEALED BLAZE AND BT SIGN (1972) A 24" STUMP METAL TOP BEARS S 42° E, 16.8 FT, TRUNK ALONGSIDE (1960) A 10" CEDAR BEARS S 89° W, 27.4 FT WITH HEALED BLAZE AND BT SIGN (1960) (SET CHAINING NAIL AT SIDE CENTER, BT SIGNS ON FRONT AND REAR, AND PAINTED RED BAND FOR EXISTING BT'S)

ESTABLISHED THE FOLLOWING: A 7" FIR BEARS N 06° W, 27.5 FT MKD: T30S R8W S31 BT A 6" CEDAR BEARS S 70° E, 6.9 FT MKD: T31S R8W S5 BT A 12" HEMLOCK BEARS N 33° E, 37.8 FT MKD: T30S R8W S32 BT (SET CHAINING NAIL AT SIDE CENTER, NAIL AND WASHER STAMPED "PLS 2830" AT BASE OF BLAZE, BT SIGNS ON FRONT AND BACK AND PAINTED RED BAND FOR NEW BT'S)

206-FOUND MONUMENT

CORNER C-5, (GCDB 200640) 1/4 CORNER OF SECTIONS 5 & 6 T. 31 S., R. 08 W., W.M.

JULY 28, 1882 GLO SURVEY BY W.H. BYARS, DEPUTY SURVEYOR UNDER CONTRACT #456 (DCSO RECORDS VOLUME 19, PAGE 8165) SET A YEW POST 3 FT LONG, 3" SQUARE, 18" IN THE GROUND, MAKRED 1/4 S FOR THE 1/4 SECTION CORNER FROM WHICH: A CEDAR, 6" DIA., BEARS N 10° E, 16 LKS. MKD: 1/4 S BT A FIR, 48" DIA., BEARS S 20° W, 15 LKS. MKD: 1/4 S BT

AUGUST - OCTOBER 1973 BLM DEPENDENT RESURVEY BY CHARLES E. AKIN JR., CADASTRAL SURVEYOR UNDER GROUP #819 (DCSO RECORDS VOLUME 36, PAGE 14937) POINT FOR 1/4 SECTION CORNER OF SECTIONS 5 & 6, AT PROPORTIONATE DISTANCE; THERE IN NO REMAINING EVIDENCE OF THE ORIGINAL CORNER. SET IRON POST, 28" LONG, 2-1/2" DIA., 22" IN THE GROUND, WITH BRASS CAP MARKED: T31S R8W 1/4 S6 S5 1973 FROM WHICH: A FIR, 13" DIA., BEARS N 89° E, 53 LKS. MKD: 1/4 S5 BT A W.FIR, 12" DIA., BEARS S 20° W, 36-1/2 LKS. MKD: 1/4 S6 BT

RECORD OF SURVEY

LOCATED IN A PORTION OF GOV'T LOTS 1, 2, 3, 4 AND THE NW 1/4, NE 1/4, SE 1/4, SW 1/4 OF SECTION 5 AND THE NE 1/4 OF SECTION 7 T. 31 S., R. 8 W., W.M., AND IN A PORTION OF THE NE 1/4 OF SECTION 1, T. 31 S., R. 9 W., W.M. SNAKE EYES 2-TASK H DOUGLAS COUNTY, OREGON CONTRACT NO. 1204T020D0010 TASK ORDER NO. 140L4322F0063

FILED DATE: 12-5-2023 BY: [Signature] THIS SURVEY CONSISTS OF: MAP: M178-75 A-E NARRATIVE: CORNER RPT: DOUGLAS COUNTY SURVEYOR

REGISTERED PROFESSIONAL LAND SURVEYOR DANIEL A. RENTON OREGON JUNE 30, 1997 DANIEL A. RENTON 2830 Expires 12-31-2024

206 CONT.

NOVEMBER 24, 2003 CARL SWEEDEN (C.S. FILE 85/48-48) FOUND 3-1/4" BRASS CAP ON 2-1/2" IRON PIPE PUSHED OUT OF POSITION, LEANING NORTH BY LOG AGAINST SOUTH SIDE, REMOVED LOG & RESET CAP & PIPE IN VERTICAL POSITION USING BT AND BT STUMP, 1973 BLM: A 19" D.FIR, N 89° E, 34.98 FT HEALED DOUBLE BLAZE, TAG ROTTED REMAINS OF BT STUMP S 20° W, 24.09 FT, REMNANT OF BT ON GROUND, SCRIBE FD "1/4 S6 BT" NEW: 18" D.FIR N 10° E, 34.4 FT, SCRIBED "W 1/4 S5 BT", TAG 10" R.CEDAR S 24° E, 24.5 FT, SCRIBED "W 1/4 S5 BT", TAG NO REASONABLE TREES IN SECTION 6 TO MARK NOTE: CORNER IS LOCATED ON EAST FACE OF SLOPE ON WEST SIDE OF NORTH/SOUTH DRAINAGE

JUNE 7, 2023 GARRETT FINCH AND CREW WITH MINISTER AND GLAESER SURVEYING FOUND A 3-1/4" BLM BRASS CAP, 0.9 FT ABOVE GROUND FROM WHICH: A 12" CEDAR BEARS S 24° E, 24.5 FT WITH PARTIAL HEALED BLAZE WITH ILLEGIBLE SCRIBE & BT SIGN (2003) A 20" FIR BEARS N 10° E, 34.4 FT WITH HEALED BLAZE AND BT SIGN (2003) A 23" FIR BEARS N 89° E, 35.0 FT WITH HEALED DOUBLE BLAZE AND BT SIGN (1973) A ROTTED 16" STUMP (2 FT HIGH) BEARS S 16° W, 24.1 FT (1973) (SET CHAINING NAIL AT SIDE CENTER, BT SIGNS ON FRONT AND REAR, AND PAINTED RED BAND FOR EXISTING BT'S)

ESTABLISHED THE FOLLOWING: A 7" FIR BEARS N 86° W, 31.0 FT MKD: 1/4 S6 BT (SET CHAINING NAIL AT SIDE CENTER, NAIL AND WASHER STAMPED "PLS 2830" AT BASE OF BLAZE, BT SIGNS ON FRONT AND BACK AND PAINTED RED BAND FOR NEW BT)

207-FOUND MONUMENT


CORNER E-5, (GCDB 200600) CORNER OF SECTIONS 5, 6, 7 & 8 T. 31 S., R. 08 W., W.M.

JULY 28, 1882 GLO SURVEY BY W.H. BYARS, DEPUTY SURVEYOR UNDER CONTRACT #456 (DCSO RECORDS VOLUME 19, PAGES 8161-2) SET A FIR POST 4 FT LONG, 4" SQUARE, 20" IN THE GROUND, MARKED T31S R8W S5 ON THE NORTHEAST, S8 ON THE SOUTHEAST, S7 ON THE SOUTHWEST AND S6 ON THE NW FACES. ALSO 5 NOTCHES ON THE EAST AND SOUTH ANGLES OF THE SAME FOR THE CORNER TO SECTIONS 5, 6, 7 & 8, FROM WHICH: A FIR, 12" DIA., BEARS N 4° E, 28 LKS. MKD: T31S R8W S5 BT A FIR, 16" DIA., BEARS S 20° E, 5 LKS. MKD: T31S R8W S8 BT A FIR, 14" DIA., BEARS S 77° W, 22 LKS. MKD: T31S R8W S7 BT A FIR, 12" DIA., BEARS N 39° W, 17 LKS. MKD: T31S R8W S6 BT

MARCH 1968 BY DCSO JP (C.S. FILE 54/36-37) REPORTED AS NOT FOUND, AREA BADLY BURNT & ROTTED

AUGUST - OCTOBER 1973 BLM DEPENDENT RESURVEY BY CHARLES E. AKIN JR., CADASTRAL SURVEYOR UNDER GROUP #819 (DCSO RECORDS VOLUME 36, PAGE 14935) POINT FOR THE CORNER OF SECTIONS 5, 6, 7 & 8 AT PROPORTIONATE DISTANCE; THERE IS NO REMAINING EVIDENCE OF THE ORIGINAL CORNER. SET AN IRON POST, 28" LONG, 2-1/2" DIA., 22" IN THE GROUND, WITH BRASS CAP MARKED: T31S R8W S5 S6 S7 S8 1973 FROM WHICH: A FIR, 8" DIA., BEARS N 37° E, 37 LKS. MKD: T31S R8W S5 BT A FIR, 13" DIA., BEARS S 22-1/2° E, 24 LKS. MKD: T31S R8W S8 BT A FIR, 10" DIA., BEARS S 24-1/2° W, 28 LKS. MKD: T31S R8W S7 BT A FIR, 10" DIA., BEARS N 82° W, 17-1/2 LKS. MKD: T31S R8W S6 BT

JUNE 8, 2023 GARRETT FINCH AND CREW WITH MINISTER AND GLAESER SURVEYING FOUND A 3-1/4" BLM BRASS CAP, 0.7 FT ABOVE GROUND FROM WHICH: A 23" FIR BEARS N 82° W, 11.6 FT WITH HEALED DOUBLE BLAZE (1973) A 14" FIR BEARS N 37° E, 24.4 FT WITH HEALED DOUBLE BLAZE AND BT SIGN (1973) A 20" FIR BEARS S 22-1/2° E, 15.8 FT WITH HEALED DOUBLE BLAZE AND BT SIGN (1973) A 19" FIR BEARS S 24-1/2° W, 18.5 FT WITH HEALED DOUBLE BLAZE AND BT SIGN (1973) (SET CHAINING NAIL AT SIDE CENTER, BT SIGNS ON FRONT AND REAR, AND PAINTED RED BAND FOR EXISTING BT'S)

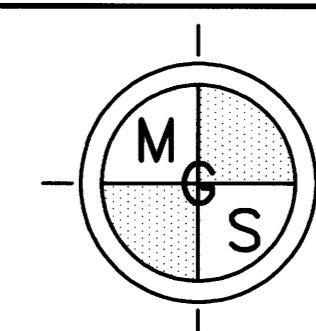

MINISTER-GLAESER SURVEYING INC. 2200 E. EVERGREEN BLVD. VANCOUVER, WA 98661 (360) 694-3313

SCALE: N/A JOB NO. 22-319 DATE: 11/29/2023 CALC BY: DAR DRAWN BY: RDH CHECKED BY: DAR SHEET 4 OF 5