

208-FOUND MONUMENT

CORNER E-3, (GCDB 140600)
1/4 CORNER OF SECTIONS 6 & 7 T. 31 S., R. 08 W., W.M.

JULY 28, 1882
GLO SURVEY BY W.H. BYARS
UNDER CONTRACT #456
(DCSO RECORDS VOLUME 19, PAGE 8164)
SET STONE 18X12X10", 8" IN THE GROUND, MARKED 1/4 ON NORTH SIDE FOR THE 1/4 SECTION CORNER AND FROM WHICH:
A FIR, 26" DIA., BEARS N 12' E, 58 LKS. MKD: 1/4 S BT
A FIR, 72" DIA., BEARS S 10' W, 38 LKS. MKD: 1/4 S BT

MARCH 7, 1968
DOUGLAS COUNTY SURVEYORS OFFICE JOHN M. POWELL, FRANK JONES AND W. PENLEY
(C.S. FILE 54/36-36)
FOUND:
STONE MKD "1/4", ALSO UNRECORDED 3/4" IRON PIPE
26", NOW 48" D.FIR, N 12' E, 38.3 FT, TREE PARTIALLY OPENED, NO SCRIBE VISIBLE, STARTING TO SHOW BURL
72" D.FIR, NOW 7.0, S 10' W, 25.1 FT, BARK SCRIBE VISIBLE
SET:
BRASS CAP AT CORNER MKD: COUNTY SURVEYORS OFFICE 1/4 S6 S7 1968
NEW BT'S:
8" W.FIR S 75' W, 23.3 FT MKD: 1/4 S7 CS BT
6" W. FIR N 9' E, 9.1 FT MKD: 1/4 S6 CS BT

AUGUST - OCTOBER 1973 (PER 1975 BLM PLAT MAP)
BLM DEPENDENT RESURVEY BY CHARLES E. AKIN JR., CADASTRAL SURVEYOR
UNDER GROUP #819
(DCSO RECORDS VOLUME 36, PAGE 14936)
THE 1/4 SECTION CORNER OF SECTIONS 6 & 7, PERPETUATED AND RECORDED BY POWELL, IN 1968, MONUMENTED WITH IRON PIPE, 1" DIA., FIRMLY SET, PROTRUDING 10" ABOVE GROUND WITH THE ORIGINAL BASALT STONE ALONGSIDE, 18X12X10", FIRMLY SET, 10" IN THE GROUND, MKD: 1/4 ON NORTH FACE, WITH BRASS CAP (PROPERLY) MARKED FROM WHICH THE REMAINS OF THE ORIGINAL BEARING TREES:
A FIR, 50" DIA., BEARS N 12' E, 58 LKS, WITH NO MARKS VISIBLE ON OPENED BLAZE
A FIR STUMP, 75" DIA., BEARS S 10' W, 38 LKS, WITH FRAGMENTARY SCRIBE MARKS VISIBLE ON BARK BLAZE AND BEARING TREES MARKED BY POWELL:
A W.FIR, 8" DIA., BEARS N 09' W, 14 LKS, WITH FRAGMENTARY SCRIBE MARKS VISIBLE ON PARTIALLY HEALED BLAZE
A W.FIR, 10" DIA., BEARS S 75' W, 35 LKS, WITH FRAGMENTARY SCRIBE MARKS VISIBLE ON PARTIALLY HEALED BLAZE

JUNE 8, 2023
GARRETT FINCH AND CREW WITH MINISTER AND GLAESER SURVEYING
FOUND A 2-1/2" COUNTY SURVEYORS OFFICE BRASS CAP, 1.0 FT ABOVE GROUND FROM WHICH:
A 1/2" IRON PIPE BEARS WEST 0.1 FT
A 22" FIR BEARS N 12' E, 9.4 FT WITH HEALED DOUBLE BLAZE (1968)
A 22" FIR BEARS S 75' W, 23.5 FT WITH HEALED BLAZE AND BT SIGN (1968)
AN 89" FIR BEARS S 10' W, 28.6 FT WITH HEALED BLAZE AND BT SIGN (1882)
A 40" STUMP BEARS N 12' E, 38.5 FT WITH BT SIGN ON TOP (1882)
(SET CHAINING NAIL AT SIDE CENTER, BT SIGNS ON FRONT AND REAR, AND PAINTED RED BAND FOR EXISTING BT'S)

209-FOUND MONUMENT

CORNER C-1, (GCDB 100640)
1/4 CORNER OF SECTION 1 T. 31 S., R. 09 W., W.M. AND SECTION 6 T. 31 S., R. 08 W., W.M.

JULY 28, 1882
GLO SURVEY BY W.H. BYARS, DEPUTY SURVEYOR
UNDER CONTRACT #456
(DCSO RECORDS VOLUME 19, PAGES 8108)
SET FIR POST 3 FT LONG, 3" DIA., 20" IN THE GROUND MARKED 1/4 S ON THE WEST SIDE FOR THE 1/4 SECTION CORNER, AND FROM WHICH:
A LAUREL 7" DIA., BEARS N 80' E, 11 LKS. DIST. MKD: 1/4 S BT
A FIR 5" DIA., BEARS S 85' W, 11 LKS. DIST. MKD: 1/4 S BT

DECEMBER 20, 1900
GLO SURVEY BY W.H. BYARS, DEPUTY SURVEYOR
UNDER CONTRACT #727
(DCSO RECORDS VOLUME 19, PAGES 8243)
POST GONE. WITNESS TREES STANDING. SET A FIR POST 4 FT LONG, 4" SQUARE, 24" IN THE GROUND MKD S6 ON THE EAST AND S1 1/4 S ON THE W FACES, FOR THE 1/4 SECTION CORNER AT THE POINT INDICATED BY THE WITNESS TREES FROM THE FIELD NOTES FURNISHED BY THE SURVEYOR GENERAL.

NOVEMBER 1960 - SEPTEMBER 1962
BLM RESURVEY BY C. ALBERT WHITE, HAROLD D. CORBIN, CADASTRAL SURVEYORS
AND DONALD R. BECK, SURVEY TECHNICIAN
UNDER GROUP #446
(DCSO RECORDS VOLUME 31, PAGES 13188-89)
THE 1/4 SECTION CORNER, DETERMINED AT RECORD BEARING AND DISTANCE FROM THE REMAINING ORIGINAL BEARING TREE:
A FIR 20" DIA., BEARS S 85' W, 11 LKS. DIST. MKD: 1/4 S, ON PARTIALLY OPENED BLAZE AT THE CORNER POINT:
SET AN IRON POST, 28" LONG 2-1/2" DIA., 22" IN THE GROUND. WITH BRASS CAP MKD:
1/4 S1 R9W S6 R8W T31S 1962
FROM WHICH NEW BEARING TREES:
A FIR 20" DIA., BEARS N 67-1/2' E, 24 LKS MKD: 1/4 S6 BT
A FIR 13" DIA., BEARS N 74-1/2' W, 41 LKS MKD: 1/4 S1 BT

JUNE 2001
KRIS DEGROOT FOR ROSEBURG RESOURCES
(MAP FILE M137-13)
FOUND:
2-1/2" IRON POST BY USBLM IN 1962, FIRMLY SET FLUSH WITH GROUND ON A STEEP NORTHEAST SLOPE, WITH 3-1/4" USBLM BRASS CAP PROPERLY MKD
FROM WHICH AN ORIGINAL BT BY BYARS IN 1882:
20" FIR SNAG BEARS N 89' W, 7.0 FT SCRIBED "1/4 S" ON PARTIALLY OPENED FACE (REC. S 85' W, 11 LKS)
BT'S BY WHITE & CORBIN IN 1962:
24" ROTTED D.FIR HIGH STUMP BEARS N 64' W, 16.0 FT WITH HEALED BLAZE (REC. N 67-1/2' W, 24 LKS)
17" D.FIR BEARS N 70' W, 26.9 FT WITH HEALED FACE (REC. N 74-1/2' W, 41 LKS)
NEW BT'S:
18" D.FIR BEARS S 54' W, 12.9 FT SCRIBED "1/4 S1 BT"
5/8"X30" IRON ROD W/ PLASTIC CAP MKD: "BTS ENG-SURV" BEARS S 31' E, 20.0 FT
5/8"X30" IRON ROD W/ PLASTIC CAP MKD: "BTS ENG-SURV" BEARS N 31' W, 15.0 FT
NOTE: ALL NEW BT'S HAVE DOUBLE BLAZED FACES WITH BRASS WASHER STAMPED "PLS 1941" NAIL INTO LOWER BLAZE. BEARINGS ARE TAKEN TO THE CENTER OF THE TREE AT THE ROOT CROWN AND DISTANCES ARE MEASURED TO A NAIL IN THE ROOT CROWN AT THE CENTER OF THE TREE, ALL BT'S HAVE A 6" RED BAND PAINTED AROUND THE TREE AND BLAZED FACE PAINTED RED AND BT SIGNS NAILED TO THE TREE.

JUNE 9, 2023
GARRETT FINCH AND CREW WITH MINISTER AND GLAESER SURVEYING
FOUND A 3-1/4" BLM BRASS CAP, 0.2 FT ABOVE GROUND FROM WHICH:
A 20" SNAG BEARS S 56' W, 12.9 FT WITH DOUBLE BLAZE MKD: "1/4 S1 BT", WASHER AND BT SIGN (2001)
A 19" STUMP (6 FT HIGH) BEARS N 62' E, 16.1 FT WITH HEALED BLAZE (1960)
A ROOTHOLE BEARS N 74' W, 30.0 FT WITH 12" TRUNK ALONGSIDE AND BT SIGN (1960)
A 5/8" IRON ROD WITH ILLEGIBLE YPC BEARS N 31' W, 15.0 FT MKD: "BTS" (2001)
A 5/8" IRON ROD WITH ILLEGIBLE YPC BEARS S 31' E, 20.0 FT (2001)
A ROTTED 20" STUMP BEARS S 88' W, 7.8 FT WITH PARTIAL BLAZE, TRUNK ALONGSIDE (1882)
(SET CHAINING NAIL AT SIDE CENTER, BT SIGNS ON FRONT AND REAR, AND PAINTED RED BAND FOR EXISTING BT'S)

ESTABLISHED THE FOLLOWING:
AN 8" FIR BEARS N 66' E, 10.6 FT MKD: 1/4 S6 BT
A 7" FIR BEARS N 02' W, 10.5 FT MKD: 1/4 S1 BT
(SET CHAINING NAIL AT SIDE CENTER, NAIL AND WASHER STAMPED "PLS 2830" AT BASE OF BLAZE, BT SIGNS ON FRONT AND BACK AND PAINTED RED BAND FOR NEW BT'S)

210-FOUND MONUMENT

CORNER A-25, (GCDB 700700) CORNER OF:
SECTION 1 T. 31 S., R. 09 W., W.M.
SECTION 6 T. 31 S., R. 08 W., W.M.
SECTION 31 T. 30 S., R. 8 W., W.M.
SECTION 36 T. 30 S., R. 09 W., W.M.

APRIL 12, 1855
GLO SURVEY BY DENNIS HATHORN, DEPUTY SURVEYOR
UNDER CONTRACT #57
(DCSO RECORDS VOLUME 17, PAGE 7372)
SET POST, CORNER OF TOWNSHIP 30 & 31 S., RANGE 8 & 9 W., FROM WHICH:
A FIR 12" DIA., BEARS N 2' E, 43 LKS. DIST.
A FIR 10" DIA., BEARS N 63' W, 25 LKS. DIST.
A FIR 15" DIA., BEARS S 75' W, 38 LKS. DIST.
A FIR 30" DIA., BEARS S 40' E, 57 LKS. DIST.

NOVEMBER 1960 - SEPTEMBER 1962
BLM RESURVEY BY C. ALBERT WHITE, HAROLD D. CORBIN, CADASTRAL SURVEYORS
AND DONALD R. BECK, SURVEYING TECHNICIAN
UNDER GROUP #446
(DCSO RECORDS VOLUME 31, PAGE 13189)
THE CORNER OF TOWNSHIP 30 & 31 S., RANGE 8 & 9 W., DETERMINED FROM REMAINS OF THE ORIGINAL BEARING TREES:
A DOWN FIR 27" DIA., BEARS N 2' E, 36 LKS. DIST., 43 LKS. SLOPE DIST., MKD. WITH A HEALED BLAZE (REC. DIST. 43 LKS.)
A FIR 51" DIA., BEARS S 38' E, 59 LKS. DIST. TO THE FACE, MKD. WITH OLD AXE MARKS AND ROTTING BARK BLAZE (REC. S 40' E, 57 LKS.)
A FIR 35" DIA., BEARS S 68' W, 38 LKS. DIST. MKD. WITH A HEALED BLAZE (REC. BRG. S 75' W), REMARKED T31S R9W S1 BT
A FIR 27" DIA., BEARS N 72-1/2' W, 25 LKS. DIST. MKD. WITH A HEALED BLAZE (REC. BRG. N 63' W), REMARKED T30S R9W S36 BT
AT THE CORNER POINT:
SET AN IRON POST, 28" LONG, 2-1/2" DIA., 22" IN THE GROUND, WITH BRASS CAP MKD:
T30S R9W R8W S36 S31 S1 S6 T31S 1962
FROM WHICH:
A FIR 35" DIA., BEARS N 54-1/4' E, 53 LKS. DIST. MKD: T30S R8W S31 BT
A FIR 15" DIA., BEARS S 22-1/2' E, 25 LKS. DIST. MKD: T31S R8W S6 BT

SEPTEMBER 1972
US DEPARTMENT OF INTERIOR BUREAU OF LAND MANAGEMENT
SURVEY BY DON E. GARRETT RPLS 544
CONTRACT #53500-CT2-334(N)
(MAP FILE M 91-10)
FOUND BRASS CAP MARKED:
US CADASTRAL SURVEY BLM 1962 T30S, S31 R8W, S36 R9W, T31S, S6 R8W, S1 R9W
27" FIR BEARS N 73' W, 25 LKS. (SHOWS SCAR)
34" FIR BEARS S 68' W, 38 LKS. (SHOWS SCRIBING)
16" FIR BEARS S 23' E, 26 LKS. (SHOWS SCAR)
33" FIR BEARS N 54-1/4' E, 53 LKS. (SHOWS SCAR)

JUNE 12, 2023
GARRETT FINCH AND CREW WITH MINISTER AND GLAESER SURVEYING
FOUND A 3-1/4" BLM BRASS CAP, 0.4 FT ABOVE GROUND FROM WHICH:
A 35" FIR BEARS N 72-1/2' W, 17.6 FT WITH HEALED BLAZE AND BT SIGN (1855)
A 39" FIR BEARS S 68' W, 25.0 FT WITH HEALED BLAZE (1855)
AN 18" FIR (DEAD) BEARS S 22-1/2' E, 16.5 FT WITH HEALED BLAZE (1960)
A 42" STUMP (5 FT HIGH) BEARS S 38' E, 40.4 FT (1855)
A 39" FIR BEARS N 54-1/4' E, 35.0 FT WITH HEALED BLAZE AND BT SIGN (1960)
A ROOTHOLE BEARS N 02' E, 29.4 FT WITH ROTTED TRUNK ALONGSIDE (1855)
(SET CHAINING NAIL AT SIDE CENTER, BT SIGNS ON FRONT AND REAR, AND PAINTED RED BAND FOR EXISTING BT'S)


ESTABLISHED THE FOLLOWING:
A 6" FIR BEARS S 65' E, 45.1 FT MKD: T31S R8W S6 BT
(SET CHAINING NAIL AT SIDE CENTER, NAIL AND WASHER STAMPED "PLS 2830" AT BASE OF BLAZE, BT SIGNS ON FRONT AND BACK AND PAINTED RED BAND FOR NEW BT)

RECORD OF SURVEY

LOCATED IN A PORTION OF
GOV'T LOTS 1, 2, 3, 4 AND
THE NW 1/4, NE 1/4, SE 1/4, SW 1/4
OF SECTION 5 AND THE NE 1/4 OF SECTION 7
T. 31 S., R. 8 W., W.M., AND IN A PORTION OF
THE NE 1/4 OF SECTION 1, T. 31 S., R. 9 W., W.M.
SNAKE EYES 2-TASK H
DOUGLAS COUNTY, OREGON
CONTRACT NO. 1204T020D0010
TASK ORDER NO. 140L4322F0063

FILED
DATE: 12-5-2023 BY: D
THIS SURVEY CONSISTS OF:
MAP: M178-75A-E
NARRATIVE:
CORNER RPT:
DOUGLAS COUNTY
SURVEYOR

REGISTERED
PROFESSIONAL
LAND SURVEYOR
11/29/2023
Daniel A. Renton
OREGON
JUNE 30, 1997
DANIEL A. RENTON
2830
Expires 12-31-2024

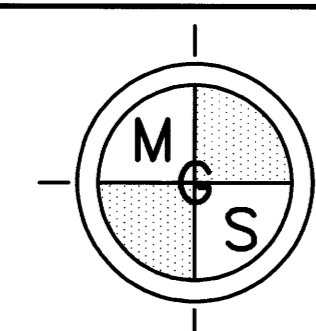

MINISTER-GLAESER
SURVEYING INC.
2200 E. EVERGREEN BLVD.
VANCOUVER, WA 98661
(360) 694-3313

SCALE: N/A
JOB NO. 22-319
DATE: 11/29/2023
CALC BY: DAR
DRAWN BY: RDH
CHECKED BY: DAR
SHEET 5 OF 5