


RECORD OF SURVEY
 LOCATED IN THE NORTHWEST,
 NORTHEAST, AND SOUTHEAST QUARTERS
 OF SECTION 33, TOWNSHIP 28 SOUTH,
 RANGE 2 WEST, WILLAMETTE MERIDIAN
 DOUGLAS COUNTY, OREGON
 SEPTEMBER 27, 2021

FILED
 Date: 9/29/2021 By: JC
 This survey consists of:
 Map: M179-80
 Narrative:
 Corner Rpt:
 DOUGLAS COUNTY
 SURVEYOR

MAP FILE M179-80

NOTES

- ① FOUND BRASS CAP & ACCESSORIES PER DOUGLAS COUNTY SURVEYOR'S OFFICE PLSS CORNER RENEWAL NOTES (300200)
 FOUND ACCESSORIES:
 36" FIR WITH HEALED SCAR BEARS N36°E 8.5'
 15'x22" SNAG WITH HEALED SCAR BEARS S8°W 13.7'
 30" FIR WITH HEALED SCAR BEARS N52°W 50.8'
 12'x9" FIR SNAG WITH USFS TAG AND
 NO SCRIBE BEARS S47°W 14.6' (NO RECORD)
 SET ACCESSORIES:
 A METAL POST BEARS S50°E 4.2'
 A METAL POST BEARS S32°W 6.9'
 A METAL POST BEARS N52°W 4.4'
 A METAL POST BEARS N37°E 4.0'
- ② FOUND BRASS CAP & ACCESSORIES PER DOUGLAS COUNTY SURVEYOR'S OFFICE PLSS CORNER RENEWAL NOTES (400200)
- ③ FOUND 18"x10"x6" STONE & ACCESSORIES PER DOUGLAS COUNTY SURVEYOR'S OFFICE PLSS CORNER RENEWAL NOTES (400100). SET 5/8x30" IRON ROD WITH YELLOW CAP MARKED "I.E. ENGINEERING, INC." IN PLACE OF STONE AND PLACED STONE ALONGSIDE ROD.
 FOUND ACCESSORIES:
 37" CEDAR WITH PARTIALLY VISIBLE SCRIBE BEARS N56°E 32.3' (RECORD N55°50'E 49.0 LK.)
 SET ACCESSORIES:
 25" HEMLOCK SCRIBED "T28S R2W S34 BT" BEARS N09°E 19.1'
 20" HEMLOCK SCRIBED "T28S R2W S34 BT" BEARS S76°E 18.6'
 AN ALUMINUM POST BEARS 3.0' NORTH
 AN ALUMINUM POST BEARS 5.0' EAST
- ④ FOUND BRASS CAP & ACCESSORIES PER DOUGLAS COUNTY SURVEYOR'S OFFICE PLSS CORNER RENEWAL NOTES (340100)
 FOUND ACCESSORIES:
 35" FIR BEARS N23°W 4.0' (UNMARKED)
 24" FIR BEARS N07°E 55.1' (UNMARKED)
 SET ACCESSORIES:
 A METAL POST BEARS 5.0' EAST
 A METAL POST BEARS 5.0' WEST
- ⑤ CALCULATED CENTER 1/4 POSITION FALLS IN A 29" FIR TREE AND COULD NOT BE SET. THE FOLLOWING REFERENCE MONUMENTS WERE SET:
 A 5/8" IRON ROD BEARS N42°59'41"E 11.32'
 A 5/8" IRON ROD BEARS S26°32'27"E 9.48'
 A 5/8" IRON ROD BEARS S33°31'39"W 5.47'
 A 5/8" IRON ROD BEARS N48°40'58"W 4.11'
- ⑥ FOUND BRASS CAP & ACCESSORIES PER DOUGLAS COUNTY SURVEYOR'S OFFICE PLSS CORNER RENEWAL NOTES (300140).
 FOUND ACCESSORIES:
 ROTTEN STUMP REMNANT BEARS S44°W, 31.3'
 57" FIR (UNRECORDED) WITH TAG FROM 1958,
 AXE SCARS, NO SCRIBE, BEARS S58°E 29.04'
 SET ACCESSORIES:
 A 8" FIR SCRIBED "1/4 S33 BT" BEARS S24°E 8.5'
 A 10" FIR SCRIBED "1/4 S32 BT" BEARS S65°W 11.9'
 A 10" FIR SCRIBED "1/4 S32 BT" BEARS N52°W 19.0'
 A 12" FIR SCRIBED "1/4 S32 BT" BEARS S57°W 21.8'

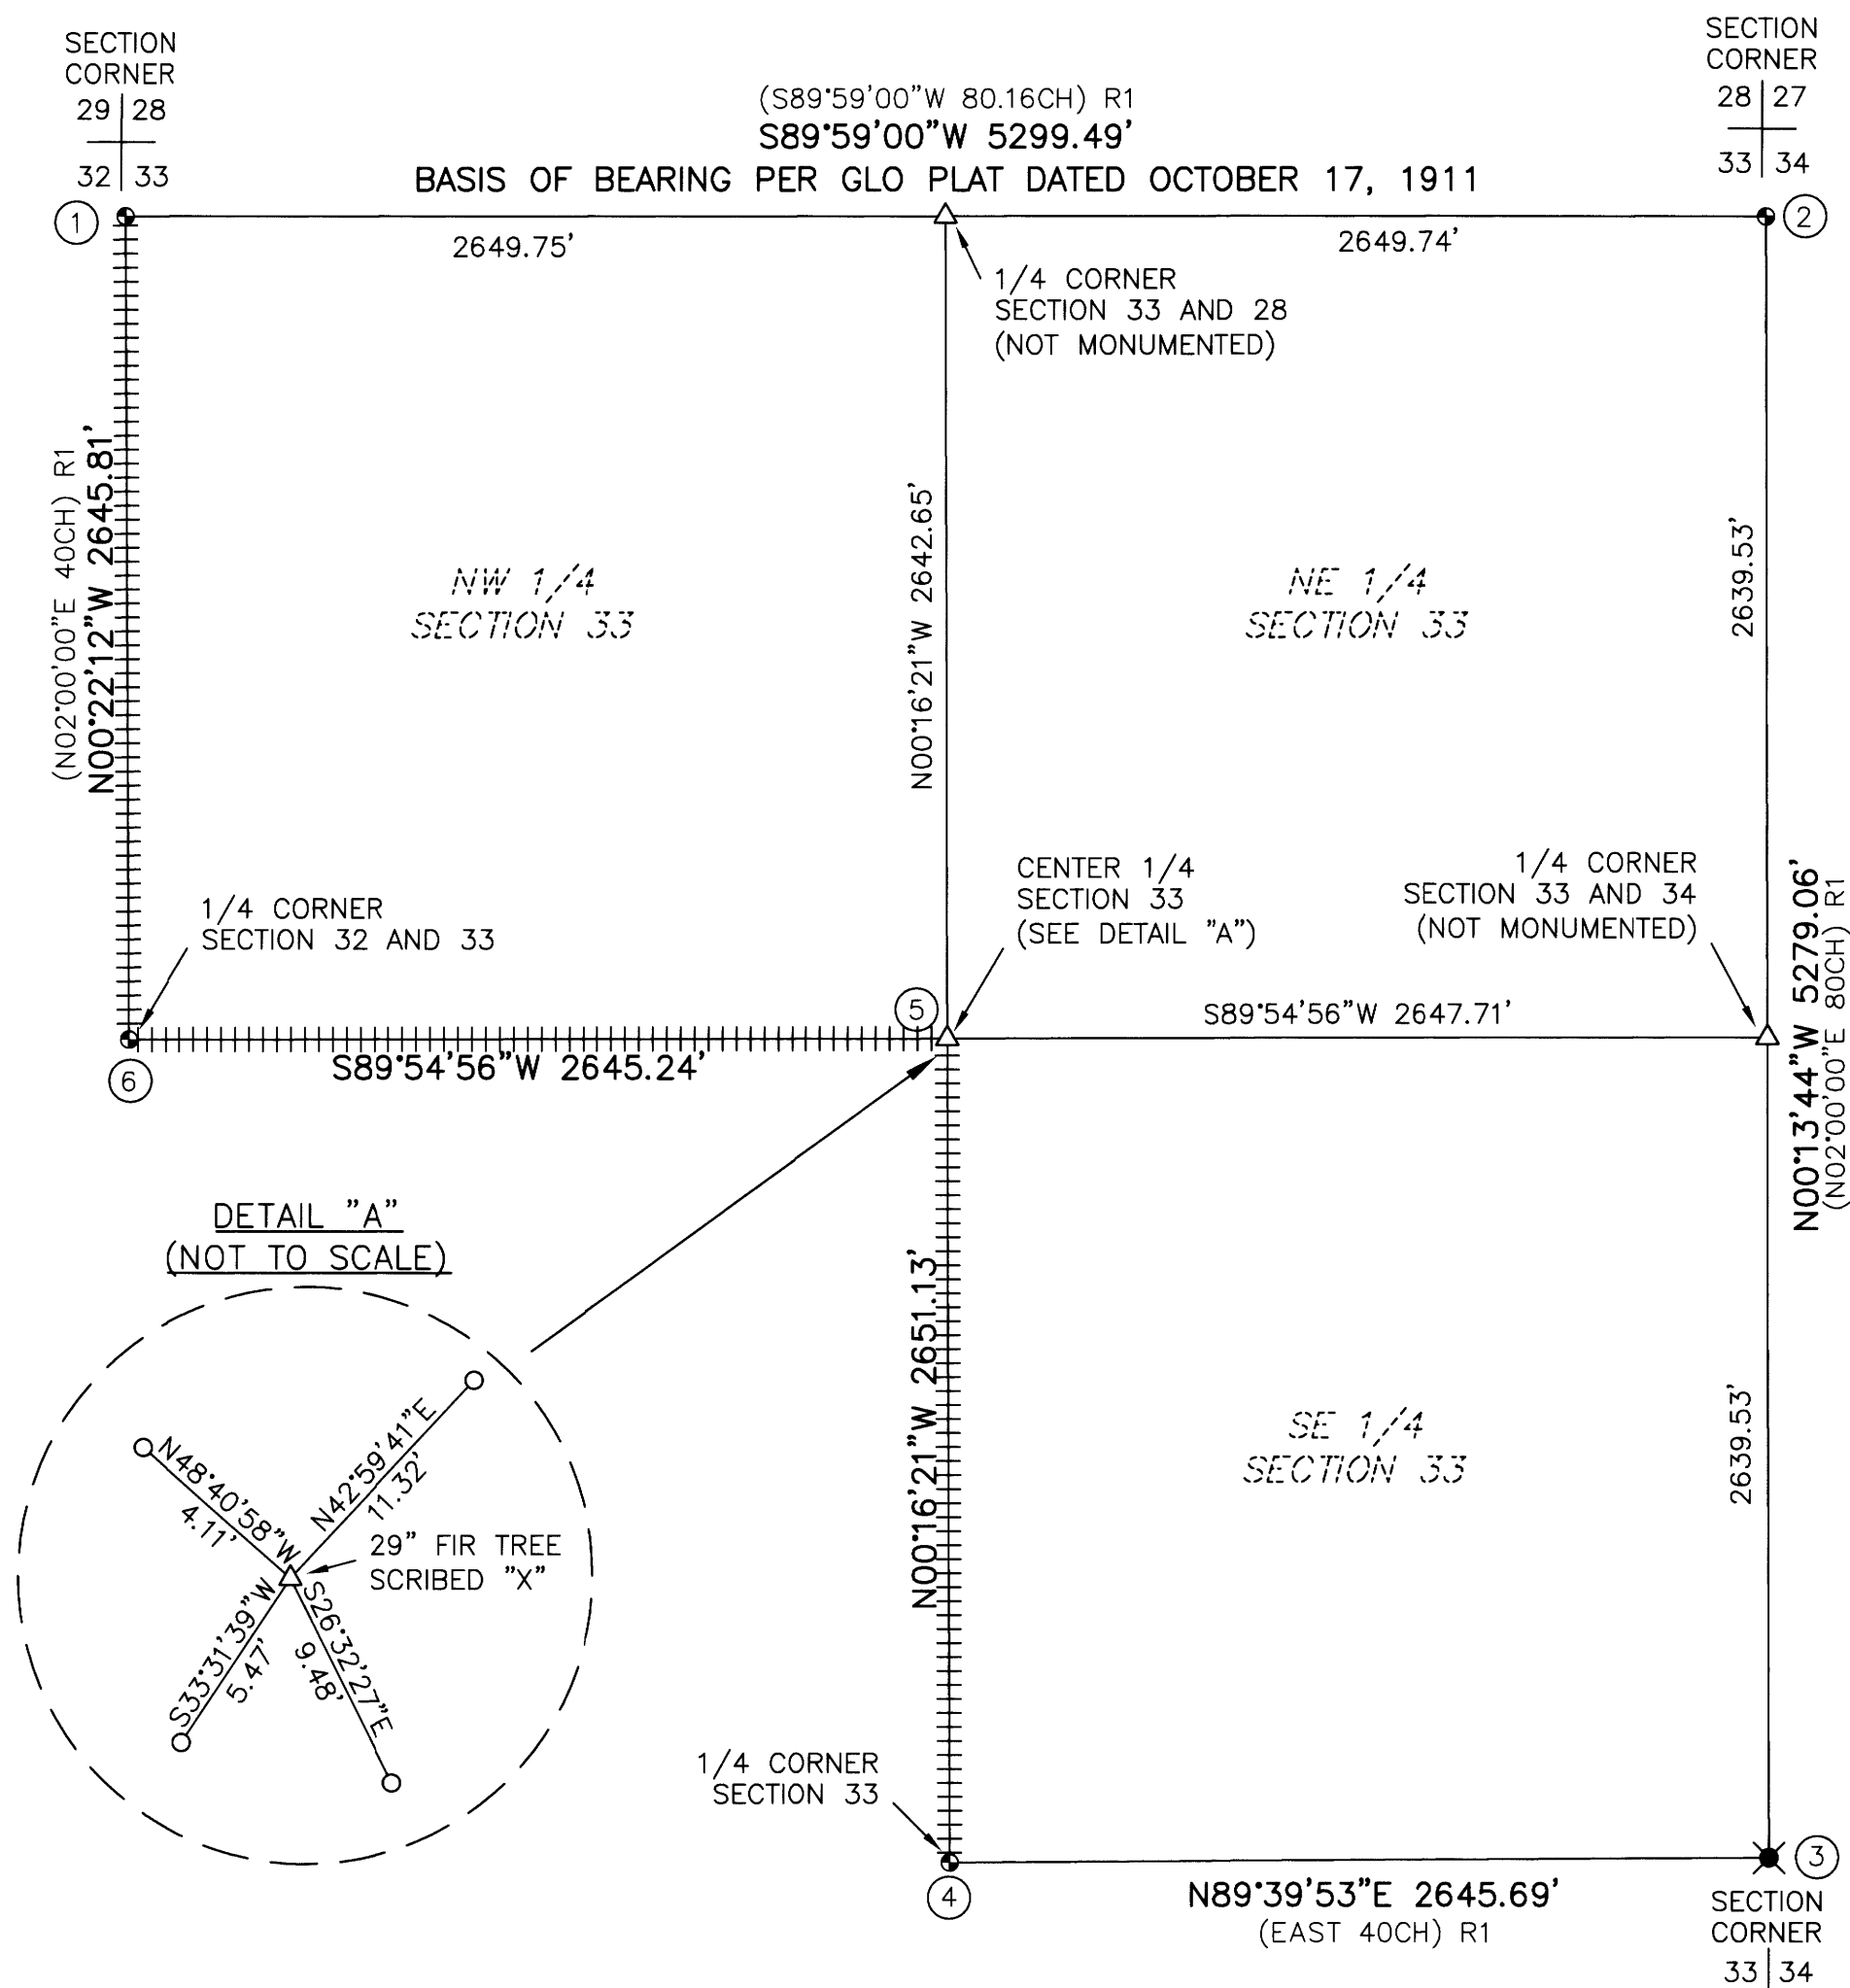

LEGEND

- ⊙ -DENOTES FOUND 3" BRASS CAP AS NOTED
- ✕ -DENOTES FOUND MONUMENT AS NOTED
- △ -DENOTES CALCULATED POINT, UNLESS OTHERWISE NOTED
- -DENOTES SET 5/8" X 30" IRON ROD WITH YELLOW PLASTIC CAP MARKED "I.E. ENGINEERING, INC."
- +++ -DENOTES BLAZED AND FLAGGED LINE
- ()R1 -DENOTES RECORD PER GLO PLAT DATED OCTOBER 17, 1911

FIELD CREW: NOLAN FROMDAHL,
 LEVI HEDDENS &
 JORDAN OGDEN

EQUIPMENT: NIKON TOTAL STATION AND
 SPECTRA DATA COLLECTOR

OFFICE: KENNETH TYNAN

DRAFTING: KENNETH TYNAN

NARRATIVE

THE PURPOSE OF THIS SURVEY IS TO MONUMENT THE CENTER 1/4 CORNER OF SECTION 33, TOWNSHIP 28 SOUTH, RANGE 2 WEST, WILLAMETTE MERIDIAN, AND TO MARK LINES AS SHOWN. THE PROCEDURE WAS AS FOLLOWS:

MONUMENTS OF RECORD WERE TIED AND HELD AS SHOWN. THE SOUTH 1/4 CORNER OF SECTION 33 AND THE CALCULATED MIDPOINT OF THE NORTH LINE OF SECTION 33 WERE HELD TO ESTABLISH THE NORTH-SOUTH CENTERLINE. THE EAST-WEST CENTERLINE WAS ESTABLISHED BY HOLDING THE 1/4 CORNER COMMON TO SECTIONS 32 AND 33 WITH THE CALCULATED 1/4 CORNER OF SECTIONS 33 & 34. THE INTERSECTION POINT OF THESE TWO LINES WAS USED TO ESTABLISH THE POSITION OF THE CENTER 1/4 CORNER. THE TRUE CORNER LANDED IN A 29" DOUGLAS FIR. REFERENCE MONUMENTS WERE SET AS SHOWN.

**REGISTERED
 PROFESSIONAL
 LAND SURVEYOR**

OREGON
 NOVEMBER 10, 2010
 BRENT H. KNAPP
 81116

EXPIRES: 6/30/2023

i.e.
 ENGINEERING

SCALE: 1"=600'

SHEET 1 OF 1
 JOB NO. 3109-01

CLIENT:
 UMPQUA INDIAN FOREST
 MANAGEMENT, LLC
 2371 NE STEPHENS
 ROSEBURG, OR 97470

809 SE Pine Street
 Roseburg, Oregon 97470
 PHONE (541) 673-0166
 FAX (541) 440-9392
 iemail@ieengineering.com

MAP FILE M179-80