

MAP OF SURVEY

SITUATED ALONG THE WEST LINE OF THE SW1/4 OF SEC. 12 AND THE WEST LINE OF SEC. 13, ALL IN T.25S, R.1W., W.M., DOUGLAS COUNTY, OREGON.

FILED
Date: 7-11-2022 By: *GN*
This survey consists of:
Map: M181-9
Narrative:
Corner Rpt:
DOUGLAS COUNTY SURVEYOR

1/4 COR.
FD. 1978 B.L.M. BRASS CAP, 6" ABOVE GROUND GLUED TO ROCK FACE, PER INDEX NO. 600540

FOUND B.T.'S (1960)
6" CEDAR SNAG, NOW ROTTEN STUMP BEARS S89°W, 9.9'

14" CEDAR, NOW STUMP BEARS S38°W, 8.91'
VISIBLE SCRIBE

FOUND B.T. (B.L.M. 1978-1980)
18" CEDAR, NOW 21" BEARS S40°W, 45.54'
HEALED BLAZE

SIERRA PACIFIC

SECTION COR.
FD. 1966 COUNTY SURVEYOR BRASS CAP PER INDEX NO. 600500

FOUND B.T. (1900)
13" D. FIR, NOW 18" STUMP BEARS N88°E, 20.46'
HEALED BLAZE


FOUND B.T. (1960)
30" D. FIR, NOW 39" BEARS N8°W, 43.56'
HEALED BLAZE
REC. = N10°W, 42.0'

FOUND B.T. (1966)
20" CEDAR, NOW 28" BEARS N41°W, 50.16'
HEALED BLAZE
REC. = N40°W, 50.3'

FOUND B.T.'S (B.L.M. 1988)
4" D. FIR, NOW 9" BEARS N45°E, 12.54'
HEALED BLAZE

12" MADRONE, NOW 24" BEARS S46°30'E, 22.44'
HEALED BLAZE

15" D. FIR, NOW 24" BEARS S60°W, 41.58'
HEALED BLAZE

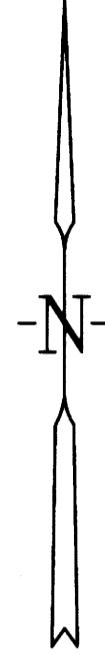

LEGEND

- FOUND MONUMENT AS NOTED.
- () RECORD PER B.L.M. SURVEY OR-0650, DATED NOVEMBER 8, 1991, EXECUTED JULY 7, 1988 AND COMPLETED AUGUST 18, 1988.
- [] RECORD PER M19-46
- { } RECORD PER 1900 GLO SURVEY
- CHS. CHAINS
- LINE MARKED WITH 5 1/2' GALVANIZED METAL POSTS, BLAZES PAINTED RED AND RED RIBBON.
- BEARINGS BASED ON B.L.M. SURVEY OR-0650

NARRATIVE

THE PURPOSE IS TO MARK THE WEST LINE OF THE SOUTHWEST QUARTER OF SECTION 12 AND THE WEST LINE OF SECTION 13, ALL IN TOWNSHIP 25 SOUTH, RANGE 1 WEST, WILLAMETTE MERIDIAN, DOUGLAS COUNTY, OREGON.

I RECOVERED AND HELD TO MONUMENTS SET PER INDEX NO. 600400, INDEX NO. 600440, INDEX NO. 600500, INDEX NO. 600540 AND B.L.M. SURVEY OR-0650, DATED NOVEMBER 8, 1991, EXECUTED JULY 7, 1988 AND COMPLETED AUGUST 18, 1988, WHICH WERE FOUND AS SHOWN ON ANNEXED MAP.

A NIKON NPL-322 TOTAL STATION WAS USED TO EXECUTE THIS SURVEY.

REGISTERED PROFESSIONAL LAND SURVEYOR
Gerald V. Nygren
OREGON
GERALD V. NYGREN
AUGUST 22, 1975
1035
RENEW: 12-31-22

N1/16 COR.
FD. 1988 B.L.M. BRASS CAP PER B.L.M. SURVEY OR-0650

FOUND B.T.'S (B.L.M. 1988)
11" D. FIR, NOW 26" BEARS N23°E, 6.27'
HEALED BLAZE

4" D. FIR, NOW 11" BEARS S70°W, 12.21'
HEALED BLAZE

SIERRA PACIFIC

1/4 COR.
FD. 1966 B.L.M. BRASS CAP PER INDEX NO. 600440

FOUND B.T. (1960)
32" D. FIR, NOW 34" STUMP BEARS N40°E, 21.78'
HEALED BLAZE
REC. = N45°E, 22.0'

FOUND B.T. (1966)
12" D. FIR, NOW 16" STUMP BEARS N4°30'E, 24.09'
VISIBLE SCRIBE
REC. = N5°E, 24.1'

FOUND B.T. (B.L.M. 1988)
4" D. FIR, NOW 12" BEARS N16°30'W, 30.36'
HEALED BLAZE

SECTION COR.
FD. 1966 COUNTY SURVEYOR BRASS CAP PER INDEX NO. 600400

FOUND B.T. (1959)
36" D. FIR, NOW 37" STUMP BEARS N13°30'W, 14.0'
VISIBLE SCRIBE
REC. = N18°W, 15.7'

FOUND B.T.'S (1966)
7" D. FIR, NOW 26" BEARS S27°00'E, 67.7'
HEALED BLAZE
REC. = S26°E, 65.0'

12" D. FIR, NOW 21" BEARS S57°45'W, 47.4'
HEALED BLAZE
REC. = S61°W, 47.9'

FOUND B.T. (2020)
11" D. FIR, BEARS N57°E, 17.3'
VISIBLE SCRIBE

SIERRA PACIFIC

SURVEYED FOR: SIERRA PACIFIC INDUSTRIES 556 NE RIFLE RANGE STREET ROSEBURG, OR 97470	GERALD V. NYGREN 522 BARKER DRIVE MERLIN, OR 97532	DATE: JUNE 16, 2022 SCALE: 1" = 400' JOB NO. 22-15
---	---	--

THIS MAP OF SURVEY WAS PREPARED WITH A HEWLETT-PACKARD DESIGNJET T630 USING HP NO. 3ED62A INKJET INK ON MILANO NO. JPC4M2 POLYESTER FILM.