

☒ School

S 83° 15' W

560 45' E

28' E

547

Tract B.

Spring

N 89° 40' W

N 89° 38' W


N 25° 07' W


N 29° 04' W

N 90° 36' W

N 5° 00' W

line from tract A.

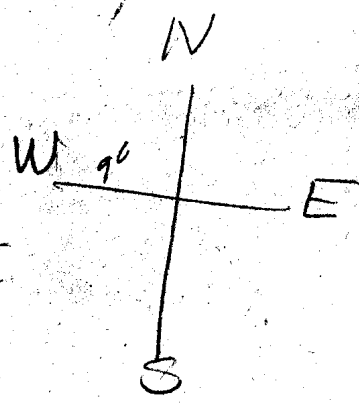
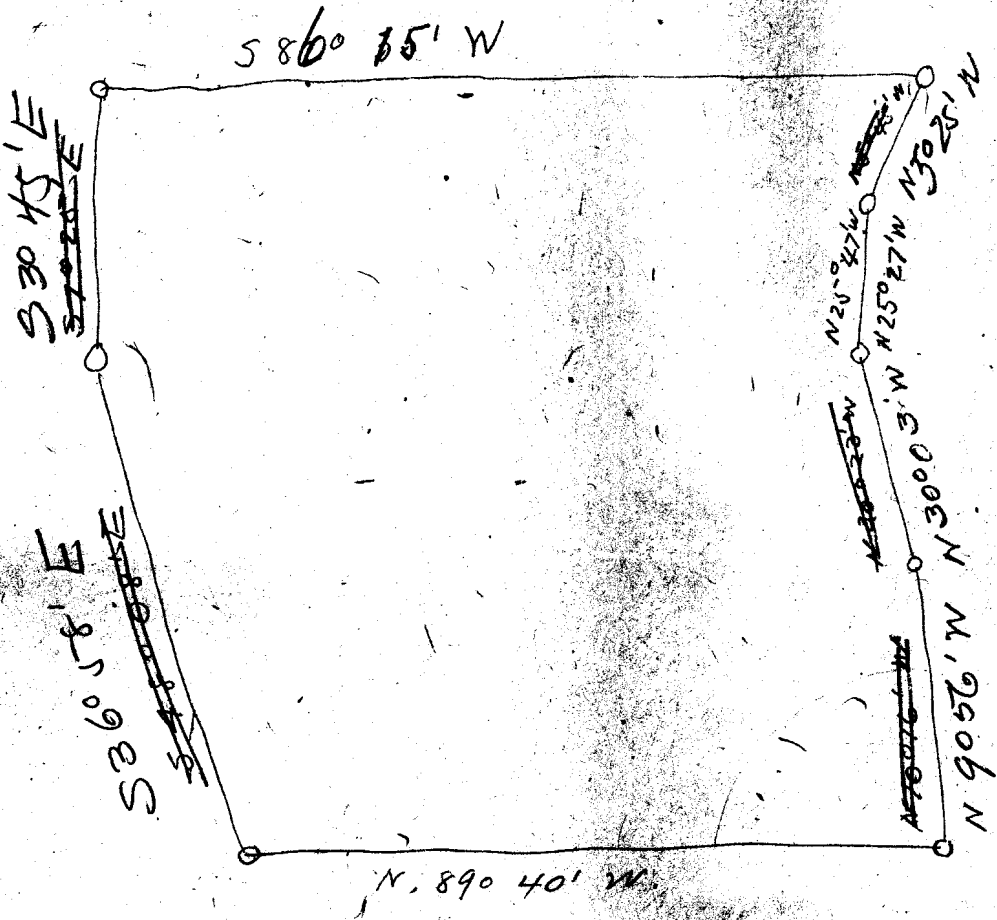
$$\begin{array}{r} 4093 \\ 345 \\ \hline 3658 \end{array}$$


$$\begin{array}{r} 208615 \\ 345 \\ \hline 208960 \end{array}$$

$$\begin{array}{r} 4808 \\ 4210 \\ \hline 9178 \\ 8940 \\ \hline 138 \end{array}$$

$$\begin{array}{r} 9140 \\ 525 \\ \hline 8615 \end{array}$$

$$\begin{array}{r} 63 \\ 30036 \\ \hline 2527 \\ 2002 \\ \hline 525 \end{array}$$

C.S. File No. 2111



CS FILE FOLDER

CONTAINS

MORE

INFORMATION