

FILED

ff

NOV 28 1986

OREGON CORNER RESTORATION FORM

Section 9+10 Township 29S Range 8W

COUNTY SURVEYOR
DOUGLAS COUNTY, ORE.

County Douglas Date 9-26-86

Corner Designation

1/4 Corner To Sec 9+10

- Condition Report Only
- Not Found
- Renewed
- Unrecorded
- Surveyed In
- Referenced Out

Previous Renewals/Surveys, etc.

REN # 133 J.M. POWELL Dec 1966
REN # 27 A. BOYER Oct 1935

Monument(s) & Accessories Found: (Condition and Source)

Found 2 1/2 in BRASS CAP MARKED 1/4 S9/S10, COUNTY SURVEYORS office, T29S, RBW, Dated 1967


ALSO Found The Following Bearing trees

A 30 in Now Stump N 70 1/2° W 55 1/2 FT no visible BLAZE

A 48 in Now Stump S 46° E 37 1/2 FT BLAZED Shows SCAR

Monument Detail

Sketch

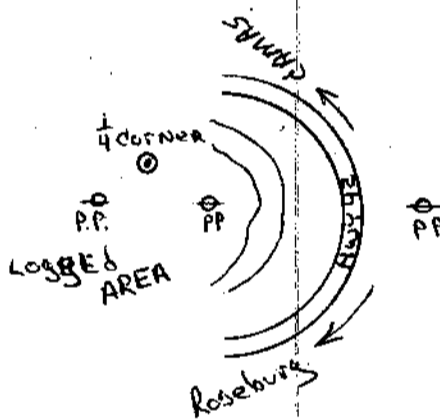

Monument Set (Procedures and Description)

New Accessories

Location & Comments

Surveyor's Seal

MONUMENT ON North Compass Declination _____
Slope of logged Firm/Agency O. D. O. T.
Area Just west _____
of Power line Address 1523 S.E. COBB
Roseburg Ore
 Party Chief L. LATHROP
 Notes R. Small
 Witness R. Wilcox



C.S. File No. 63/9-35