

CORNER REPORT FORM

Section 8 Township 32S Range 4W
Douglas County **Date:** May, 2009

CORNER DESIGNATION:

S 1/16 Sec 8 |

Previous Renewals/Surveys, etc:

C.S. 63/52 narrative survey, and M111-12 by
Baughman Technical Services Inc.
DeGroot - Nov. 1990

____ Condition Report only
____ Not Found
X Renewed
____ Unrecorded
____ Surveyed In
____ Referenced out

Monument(s) & Accessories Found: (Condition and Source)

23" Douglas fir S36W 32.8' Healed face 1990
9" Maple N29W 63.5' Healed face 1990

FILED

Date: 6/22/2009 By: JC


This survey consists of:

Map: _____

Narrative: _____

Corner Rpt: 65/66-32

Monument Detail Sketch:

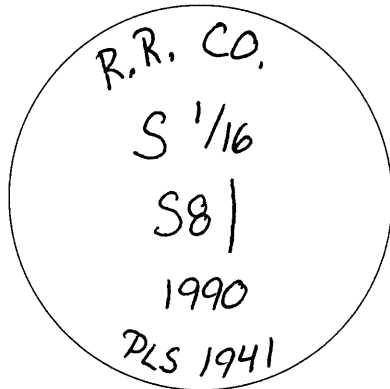

**DOUGLAS COUNTY
SURVEYOR**

Monument Set: (Procedures and Description)

New Accessories:

18" Douglas fir S32E 17.4' measured to a nail in the side-center of stump
(same tree as BT for S 1/16 9 only) healed face

Location & Comments:

Compass Declination: 18°
Firm/Agency: Roseburg Forest Products
Address: PO Box 1088
Roseburg, OR 97470
Party Chief: William Olson
Notes:
Witness: Niel Danko

Surveyor's Seal

REGISTERED
PROFESSIONAL
LAND SURVEYOR

Mark F. Smalley

OREGON
July 26, 1988
MARK F. SMALLEY
2354

RENEWS: 6/10/2010

C.S. File No 65/66-32