

FILED

Date: 7/19/2016 By: JC

This survey consists of:

Map: _____

Narrative: _____

Corner Rpt: CS 65/93-15

CORNER REPORT FORM

Section 26 Township 23S Range 10W
Douglas County Date 8-2016
PLSS Number 500306

DOUGLAS COUNTY
SURVEYOR

CORNER DESIGNATION

See Cor 22/23
27/26



Condition Report only
Not Found
Renewed
Unrecorded
Surveyed In
Referenced out

Previous Renewals/Surveys, etc:


GLD Resurvey 1905 Miller 1983 m 95-29
Gibson ORE. State Board of Forestry 1962 CS 42/422

Monument(s) & Accessories Found: (Condition and Source)

3" BRASS CAP MORTARED INTO SANDSTONE 3'X4'X2'
26" MAPLE N40E 70.1 FT GOOD SCAR
20" FIR SNAG (8' HIGH) S58 1/2 W 96.5 FT (1/2 Scribes)
20' X 15' SANDSTONE FACE N86E 13.4 FT MKD X BO ON WEST FACE
OR. STATE FORESTRY LOCATION TAG ON 20" MAPLE N87E 21.0
4" X 4" X 72" WHITE CEDAR POST 2.6 FT NW

Monument Detail

Sketch

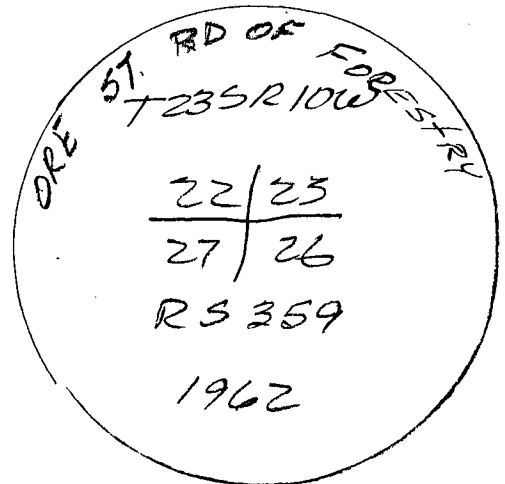

Monument Set (Procedures and Description)

New Accessories



16" Hemlock S86W 12.4 FT scribed T23S R10W S27 BT

Surveyor's Seal

Location & Comments

Compass Declination 16 1/2 E
Firm/Agency: i.e. Engineering, Inc.
Address: 809 SE Pine St., Roseburg, OR 97470

Party Chief: M. From Dahl
Notes:
Witness: J. LEONARD
R. OLSON

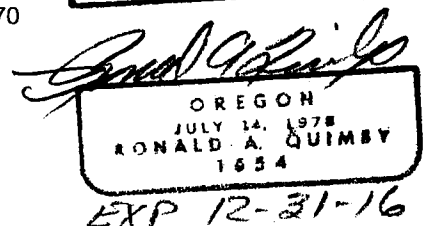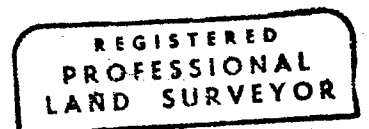

C.S. File 65/93-15