

FILED

Date: 1-12-2017 By: JC

This survey consists of:

Map: _____

Narrative: _____

Corner Rpt: CS 65/95-2

DOUGLAS COUNTY
SURVEYOR

CORNER REPORT FORM

Section 6 Township 32S Range 4W
Douglas County Date 12-2015
PLSS Number 120600

CORNER DESIGNATION

W 1/4 56
57

- Condition Report only
- Not Found
- Renewed
- Unrecorded
- Surveyed In
- Referenced out

Previous Renewals/Surveys, etc:

SET BY BLM 1971


DCSO 2007

Monument(s) & Accessories Found: (Condition and Source)

FD 3 1/4 " BRASS CAP
ROOT Hole N 3W 9.2 FT (PER REC)
23" FIR (REC 22") S 8 E 15.8 FT Healed BLAZE
16" FIR N 4 1/2 E 18.0 FT Vis. Scribes

Monument Detail

Sketch

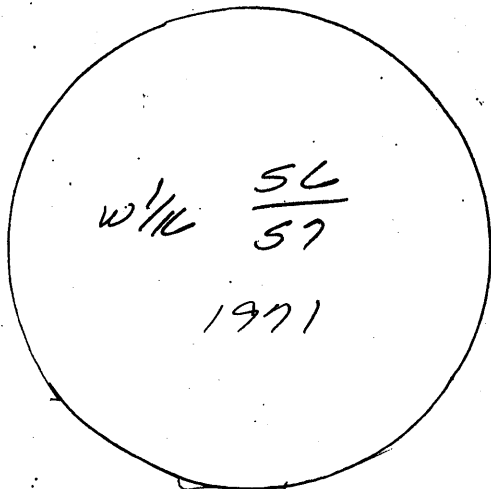

Monument Set (Procedures and Description)

New Accessories

REGISTERED
PROFESSIONAL
LAND SURVEYOR

Surveyor's Seal

Location & Comments

CORNER ON
EAST Slope APPROX
350' EAST OF ROAD

Compass Declination 15 1/2 ° E
Firm/Agency: i.e. Engineering, Inc.
Address: 809 SE Pine St., Roseburg, OR 97470

Party Chief: N FOMIDANL

Notes:

Witness: R. OLSEN

REGISTERED
PROFESSIONAL
LAND SURVEYOR

Ronald A. Quimby
OREGON
JULY 14, 1978
RONALD A. QUIMBY
1954

EXP 12-31-16

C.S. File CS 65/95-2