




# DOUGLAS COUNTY, OREGON

## PLANS FOR PROPOSED PROJECT

### GRADING & SURFACING

# FOWLER STREET

## 1973

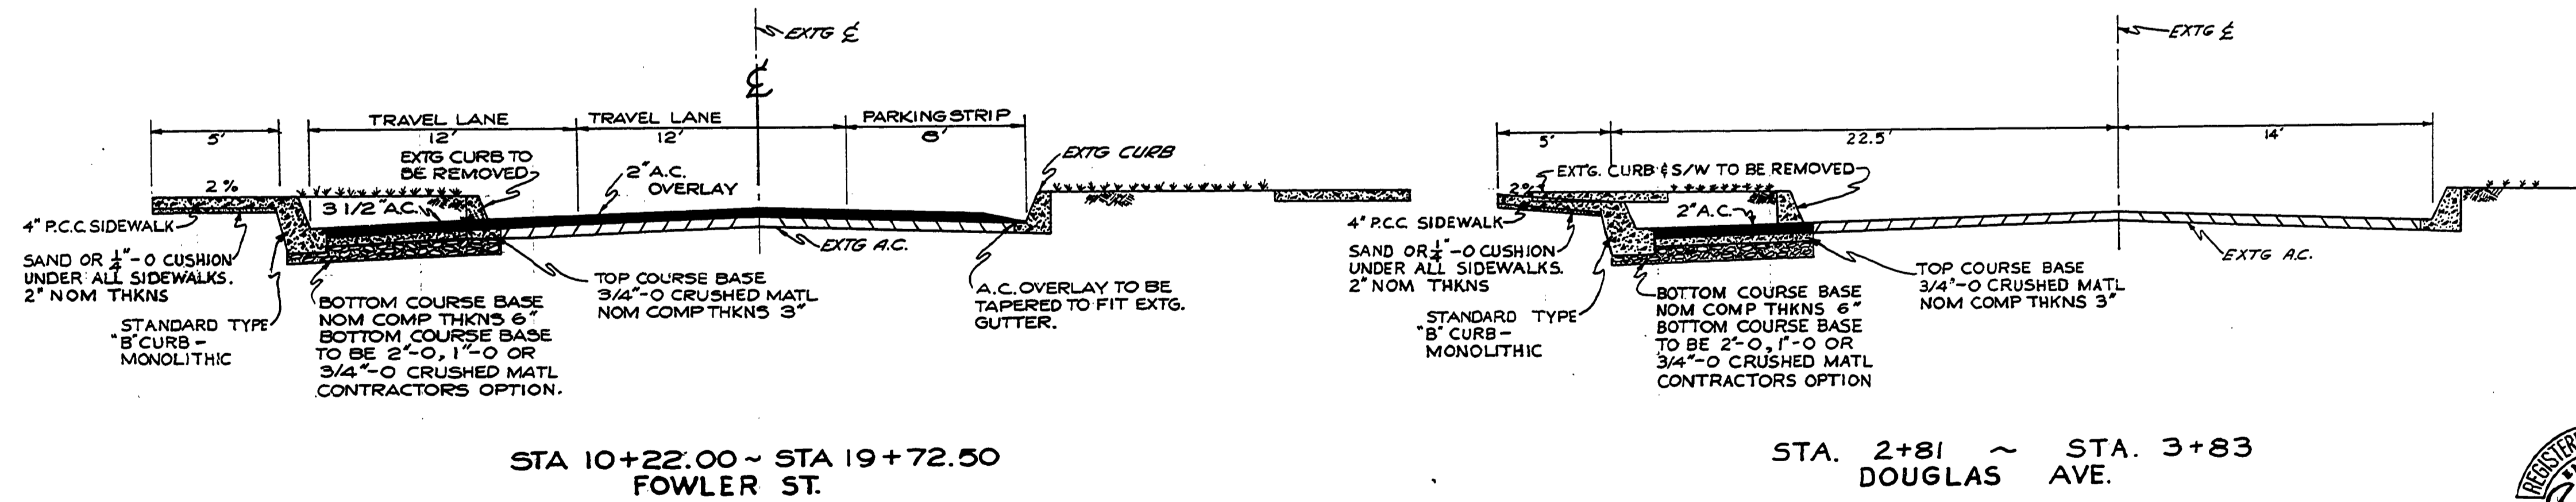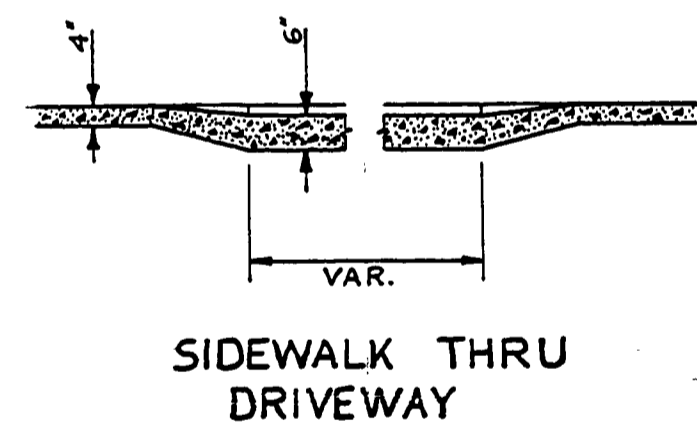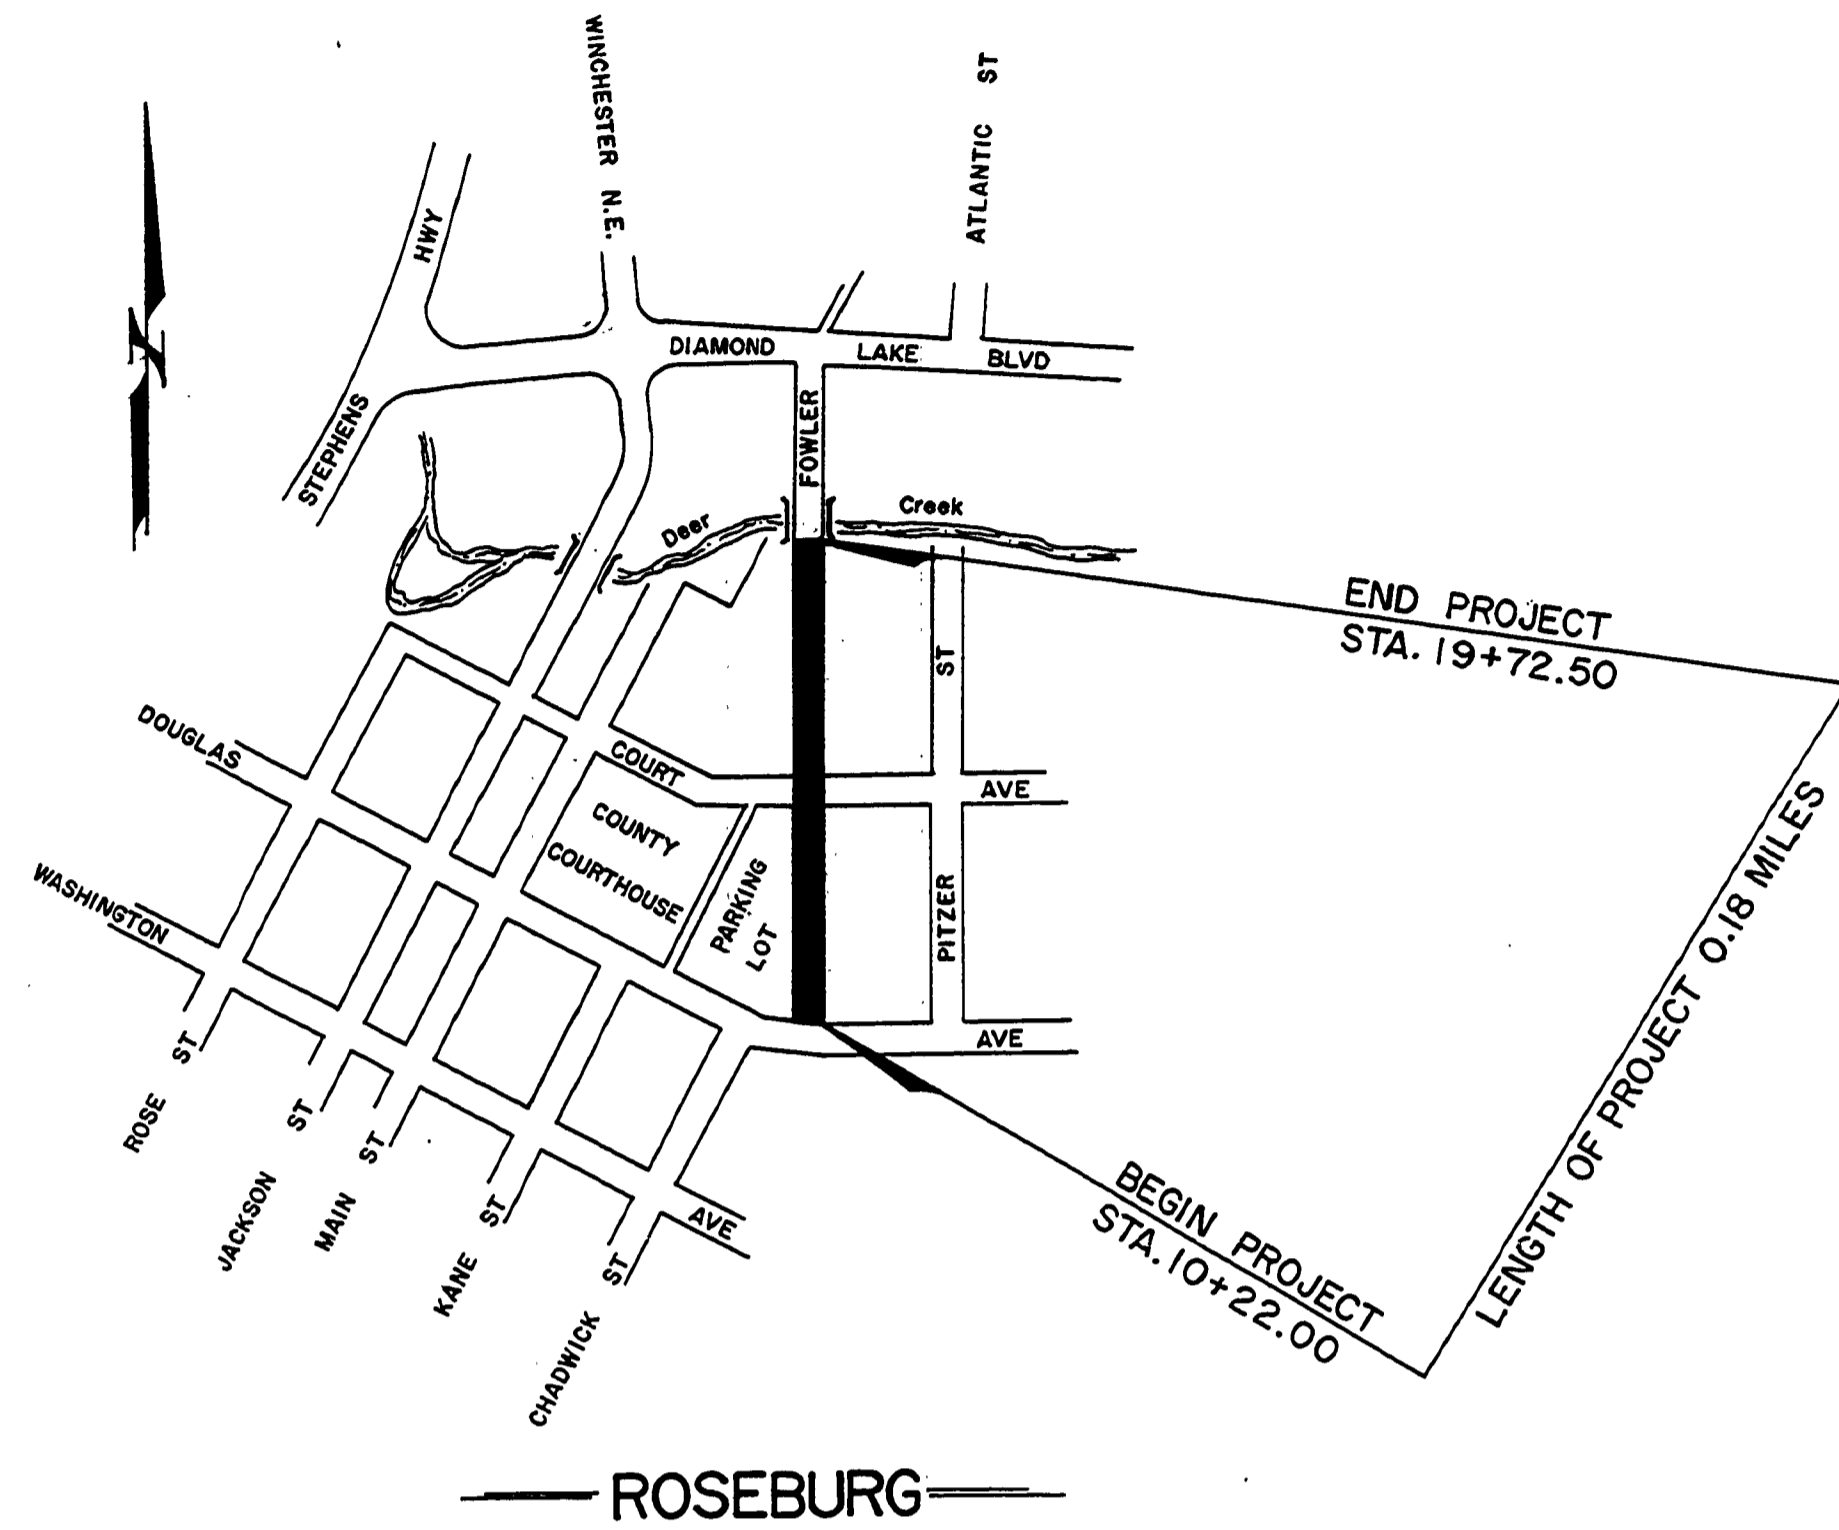

### INDEX OF DRAWINGS

ROAD PLANS	
SHEET NUMBER	
1	TITLE SHEET & TYPICAL SECTIONS
2	QUANTITY SUMMARY
3	PIPE LIST
4	ALIGNMENT
5	STORM SEWER

### STANDARD DRAWINGS 2, 3, 4 & 9

SANITARY SEWER	
SHEET NUMBER	
1	SANITARY SEWER PLANS
SPECIAL STANDARD DRAWINGS	
1, 2 & 3	
TOTAL OF 13 SHEETS	



*8-14-74 FILE DATE  
REVISED AS BUILT P.H.*

DOUGLAS COUNTY ROAD DEPT  
FOWLER STREET  
1973 SHT. 1  
GEORGE E. GRUBB COUNTY ENGR.