



DETAIL A
NO SCALE

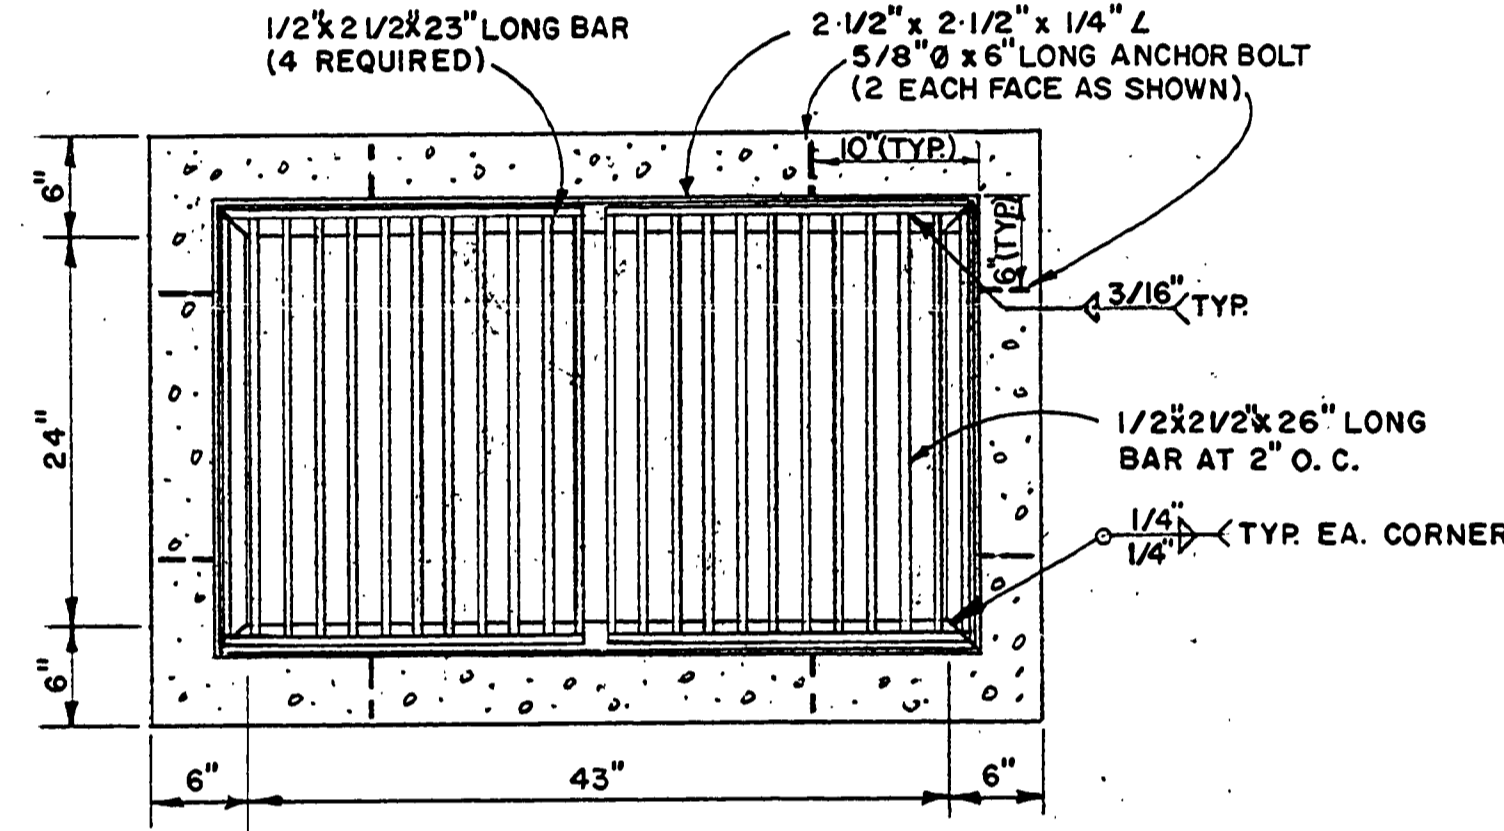

FRAME & GRATE DETAIL
SCALE: 1"=1'-0"

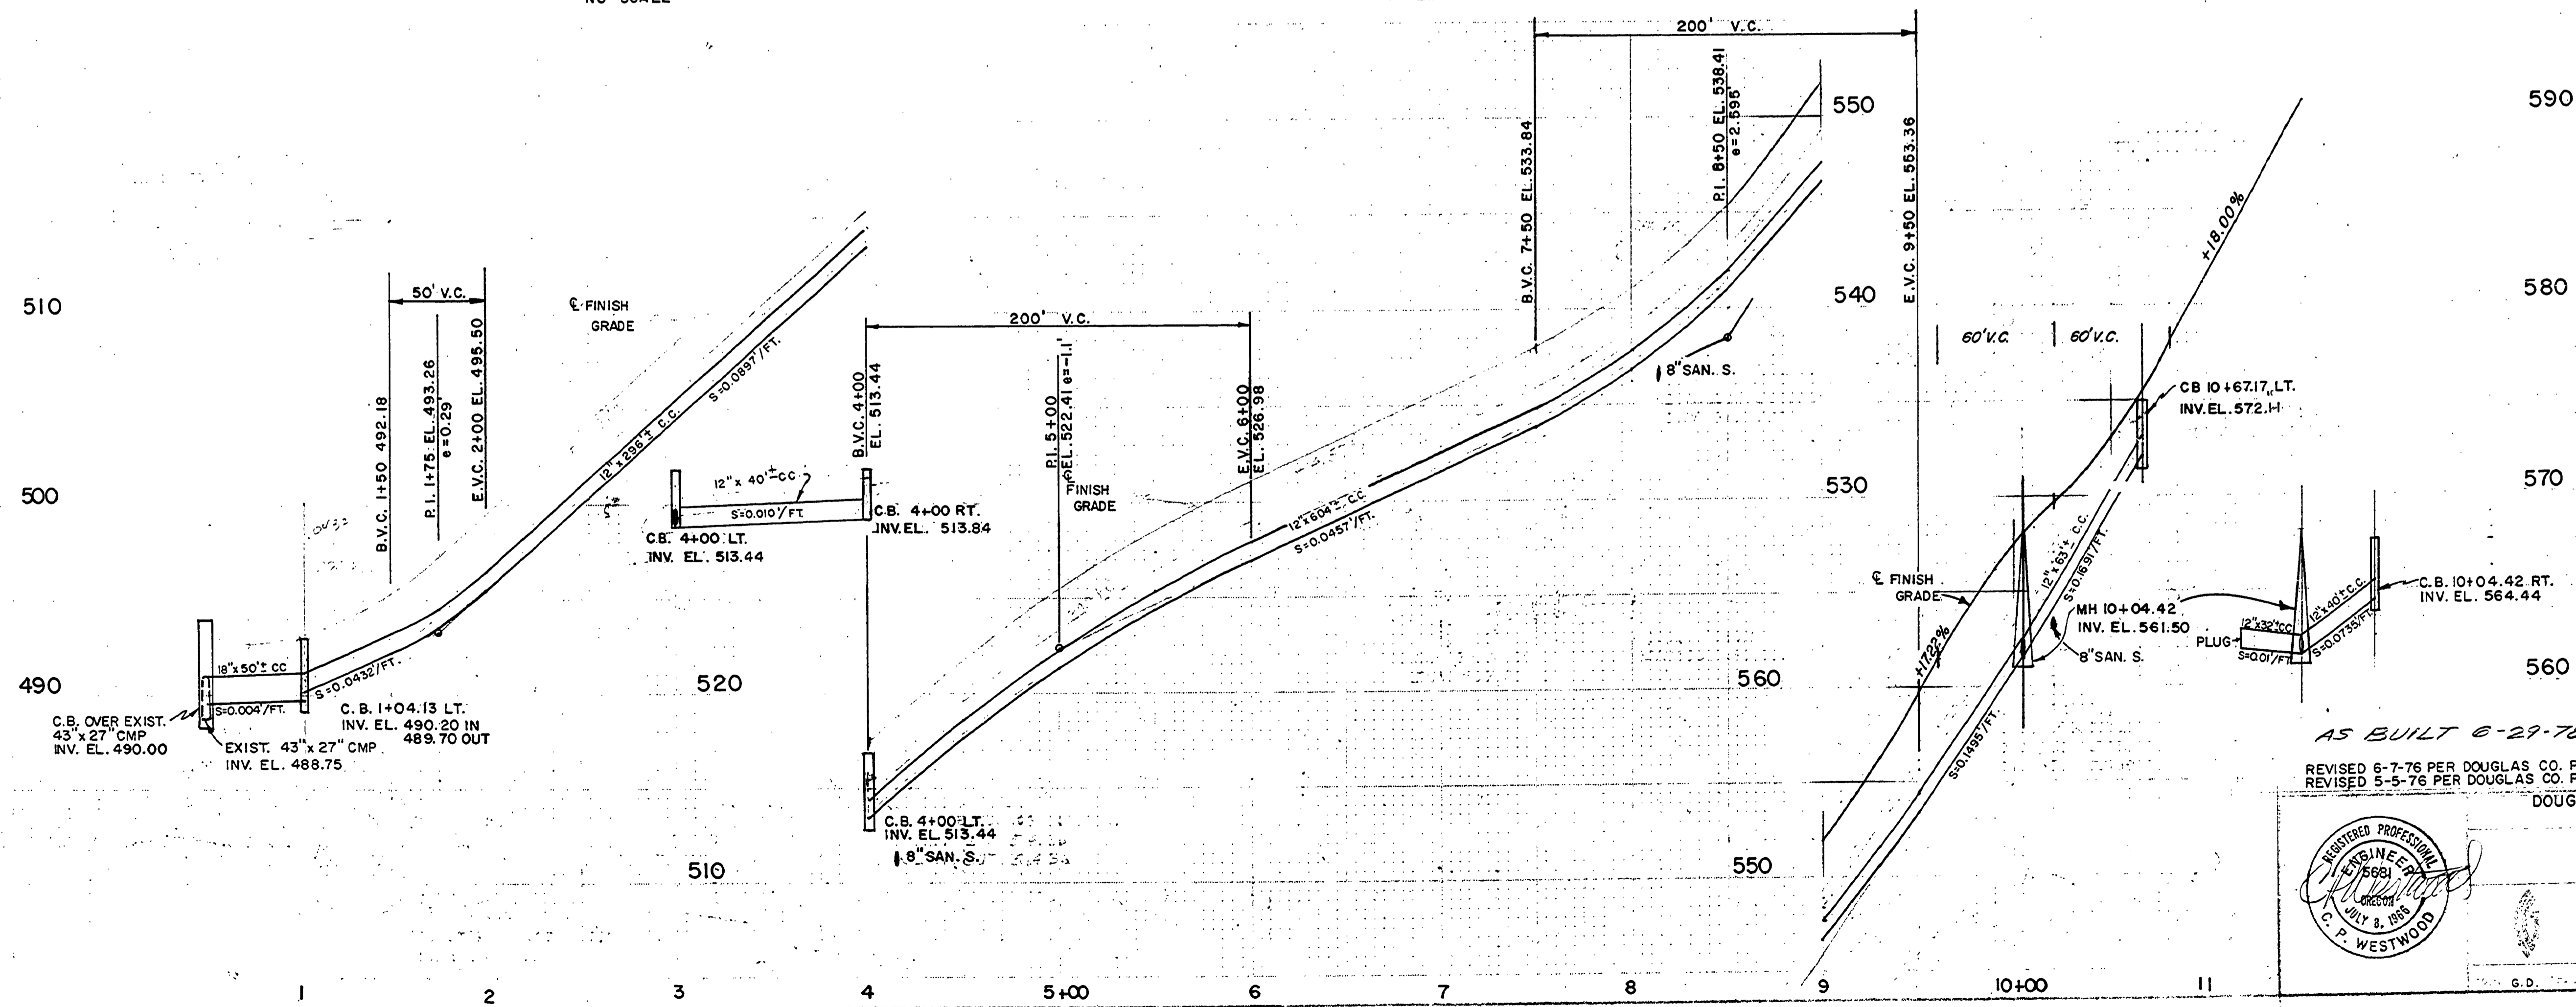

SCALE: HORIZ. 1"=50'
VERT. 1"=5'

AS BUILT 6-29-78 R.U.F.

REVISED 5-7-76 PER DOUGLAS CO. PLAN CHECK OF 6-3-76 piw
REVISED 5-5-76 PER DOUGLAS CO. PLAN CHECK OF 4-27-76 piw

DOUGLAS COUNTY PUBLIC WORKS DEPARTMENT
GEORGE E. GRUBB, DIRECTOR



SUNBERRY DRIVE
STORM SEWER IMPROVEMENTS

C & G ENGINEERING
P.O. BOX 222
ROSEBURG, OREGON

4
36250