






DOUGLAS COUNTY, OREGON
 PLANS FOR PROPOSED PROJECT
 GRADING & SURFACING
GLENHART AVENUE, WINSTON
 HWY. #42 TO COUNTY RD. #107
1975

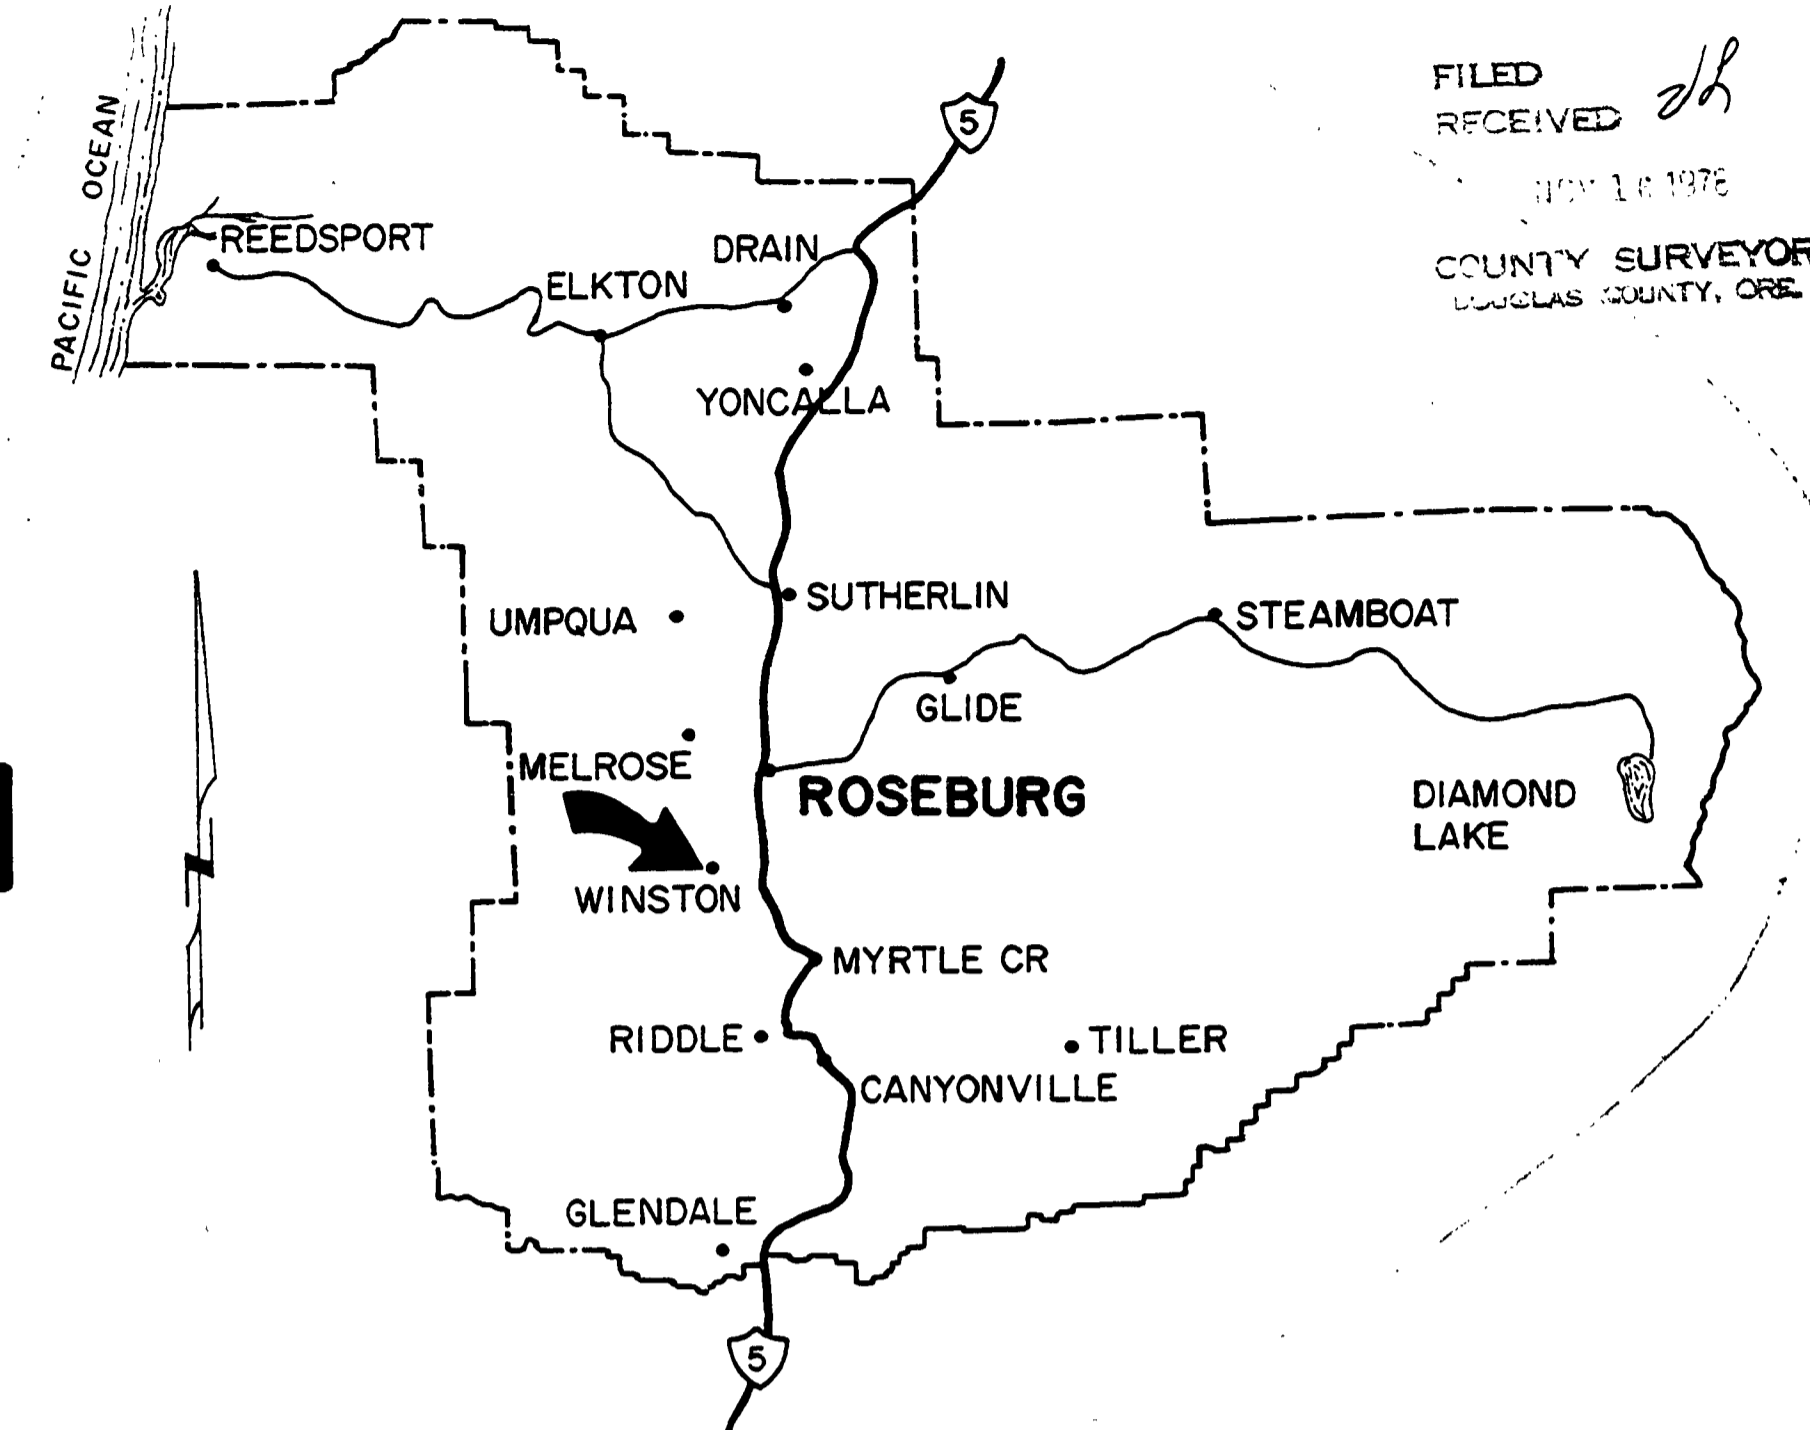

FILED RECEIVED *dh*
 JUN 18 1975
 COUNTY SURVEYOR
 DOUGLAS COUNTY, ORE.

INDEX OF DRAWINGS

SHEET NUMBER	TITLE
1	TITLE SHEET & TYPICALS
2	QUANTITY SUMMARY
3-4	ROAD PLANS
5-6	STORM SEWER PLANS
#1,2,3,4,8,9	STANDARD DRAWINGS
TOTAL OF 11 SHEETS	

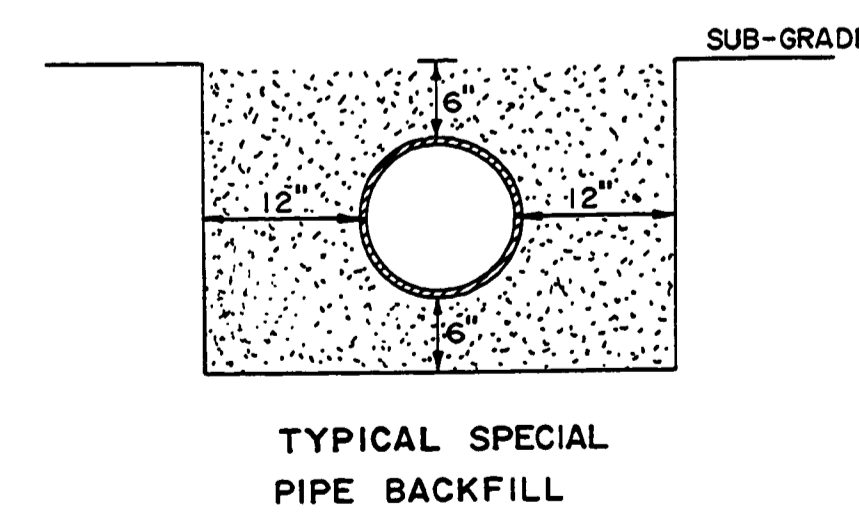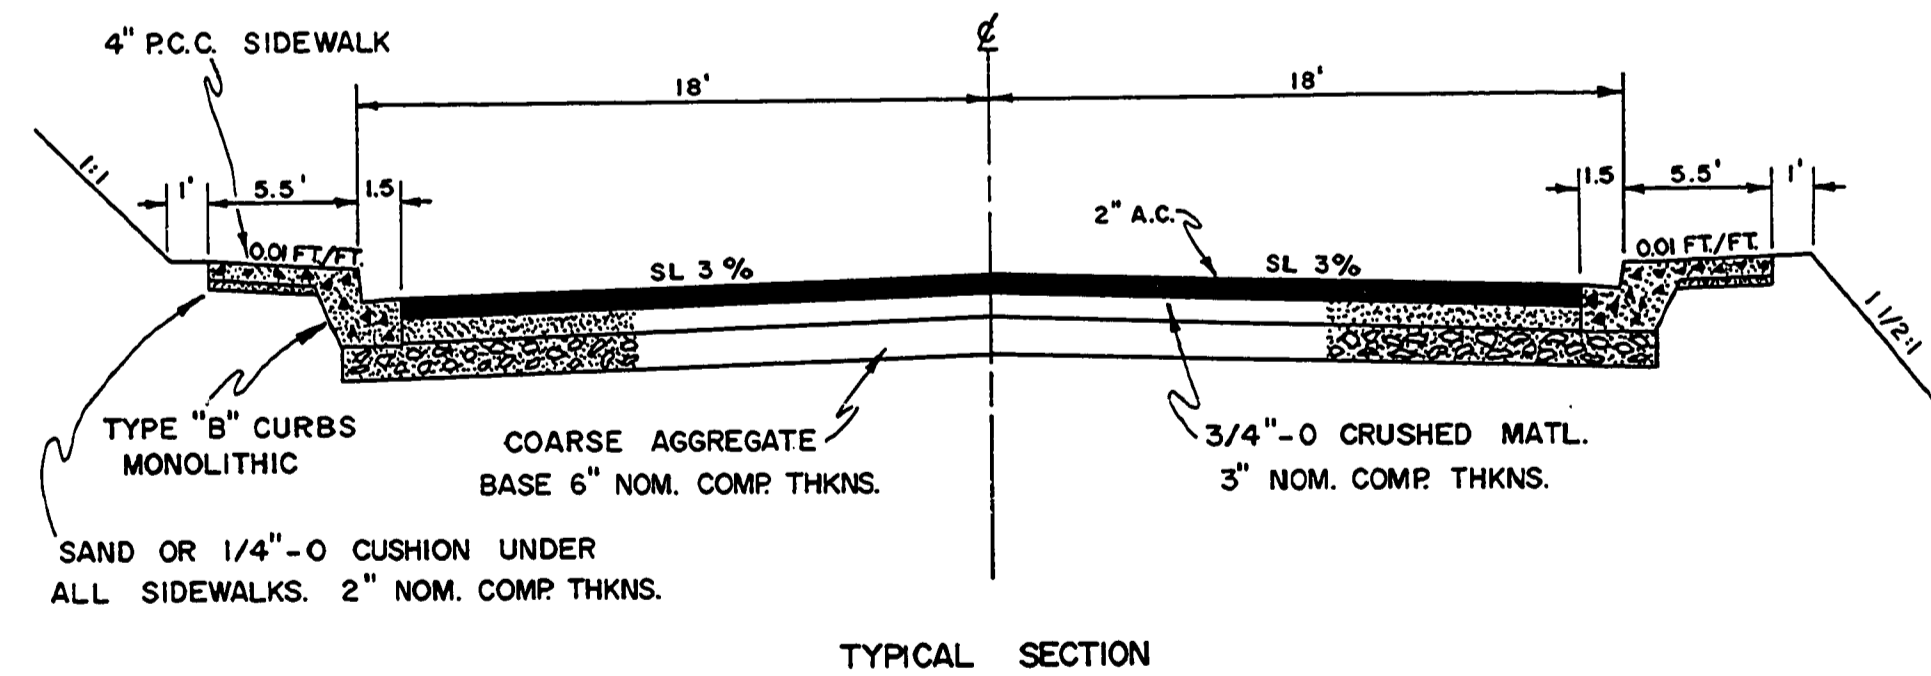

AS BUILT 10-9-78 RUT
 DOUGLAS COUNTY
 PUBLIC WORKS DEPARTMENT
 GLENHART AVENUE, WINSTON
 1975 SHT. 1
 GEORGE E. GRUBB, DIRECTOR