
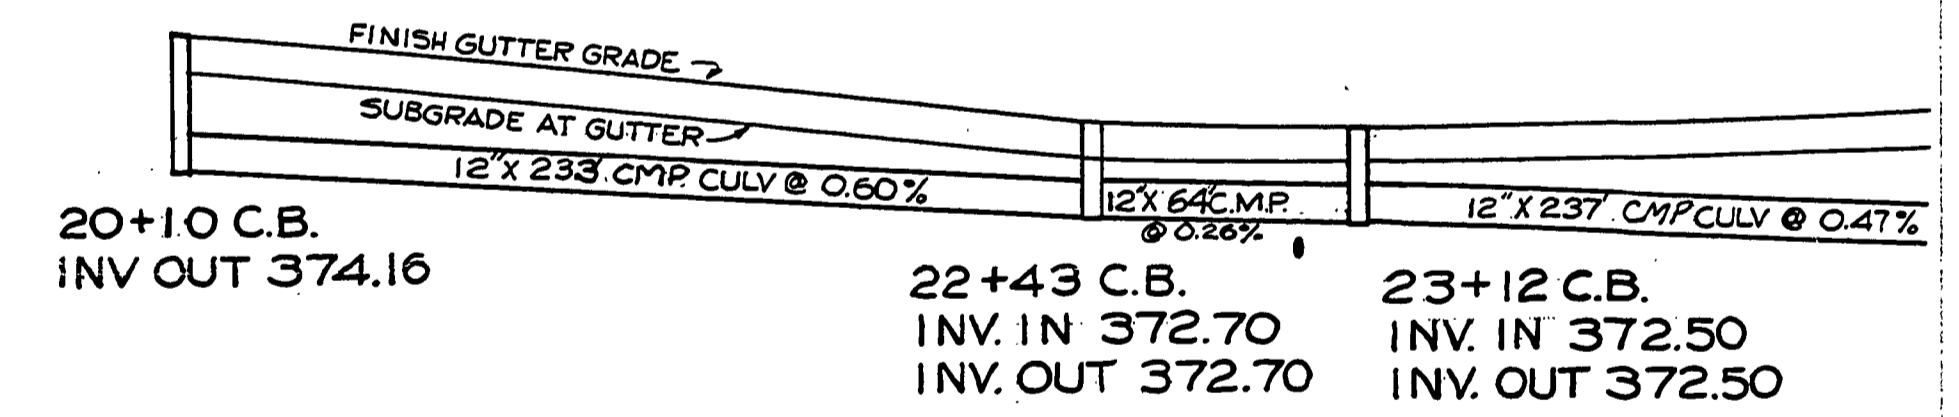
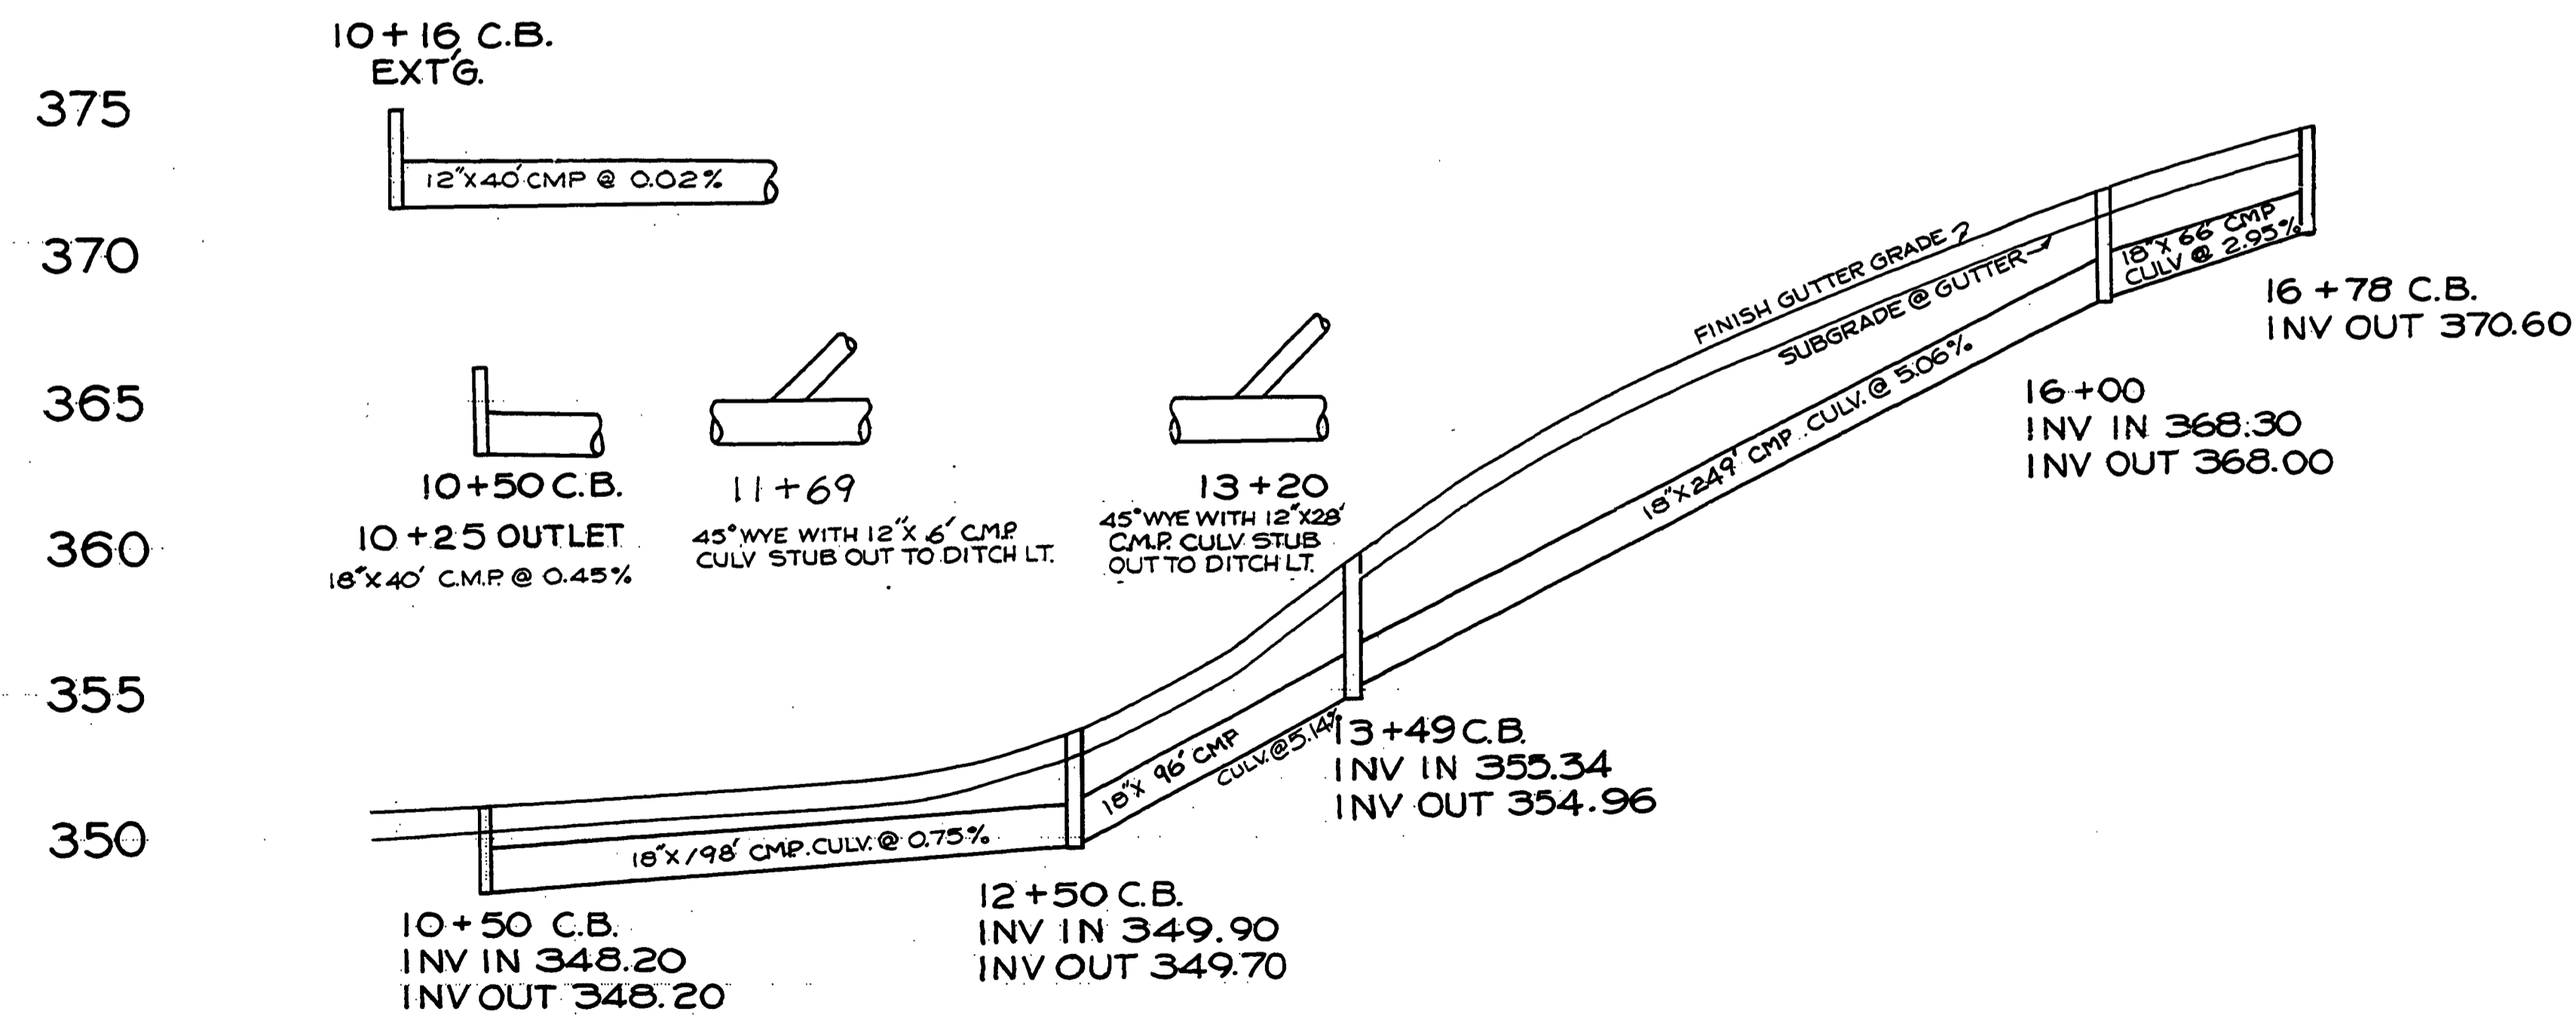


| | | |
|------|----|-------------------|
| DATE | BY | REVISION |
| | | 1. PLAN |
| | | 2. PROFILE |
| | | 3. SANITARY SEWER |
| | | 4. FINISH GRADE |
| | | 5. SUBGRADE |
| | | 6. GUTTER |
| | | 7. CULVERT |
| | | 8. WYE |
| | | 9. OUTLET |
| | | 10. STUB |
| | | 11. DITCH |
| | | 12. LATERAL |
| | | 13. VERIFICATION |
| | | 14. TOP |
| | | 15. LATERAL |
| | | 16. VERIFY |
| | | 17. TOP |
| | | 18. LATERAL |
| | | 19. VERIFY |
| | | |
|------|----|-------------------|
| DATE | BY | REVISION |
| | | 1. PLAN |
| | | 2. PROFILE |
| | | 3. SANITARY SEWER |
| | | 4. FINISH GRADE |
| | | 5. SUBGRADE |
| | | 6. GUTTER |
| | | 7. CULVERT |
| | | 8. WYE |
| | | 9. OUTLET |
| | | 10. STUB |
| | | 11. DITCH |
| | | 12. LATERAL |
| | | 13. VERIFICATION |
| | | 14. TOP |
| | | 15. LATERAL |
| | | 16. VERIFY |
| | | 17. TOP |
| | | 18. LATERAL |
| | | 19. VERIFY |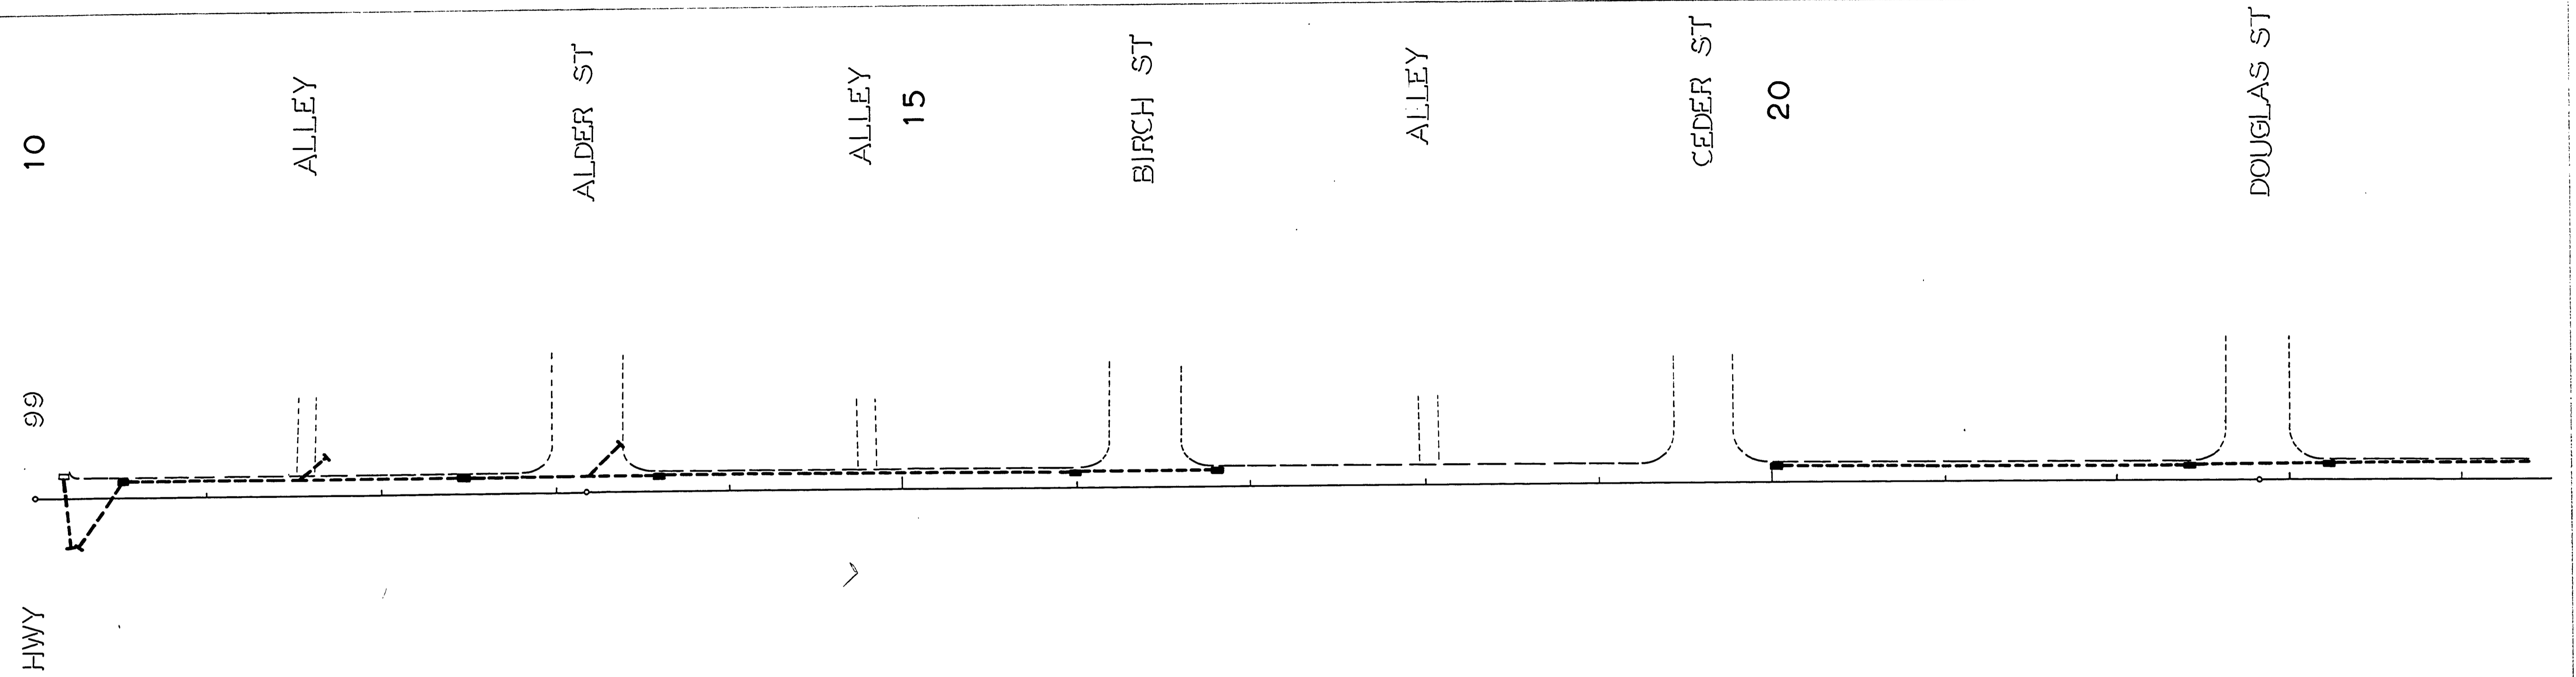
SANITARY SEWER
F.L. ELEV. 371.6
VERIFY TOP LATERAL LT

AS CONSTRUCTED *E.B.A.*
DOUGLAS COUNTY ROAD DEPT
FIRST ST - YONCALLA
MAY 1971 SHT 6
GEORGE E. GRUBB COUNTY ENGR.