

Field Book # 11

FB No 11

Ledger

A B C D E F G H I J K L M N O P Q R S T U V W X Y Z

Adam, Henry, 29-5, 172

4 in day 5.50
 Wed 13 5.30
 Thurs 10 5.30
 5.50
 10.00
 7.50
 22.50

Field Book No. 11

Alphabet Section A-Z Blank

Begin at a point from
bearing $N 88^{\circ} 45' E$ 3390

Survey of Co Road met 21
Geo. K. Zinner and 189 B.

Begin at post on by C.S.

Thence - var - $20^{\circ} E$

$S 33\frac{1}{2}^{\circ} W$ 9,200 8,440
 $S 16\frac{1}{2}^{\circ} W$ 10,800 11,100
 $S 22\frac{3}{4}^{\circ} W$ 1,500
 $S 37^{\circ} W$ 8,640
 $S 47\frac{1}{2}^{\circ} W$ 750 Set

R B. Dixon 73 miles
 G. B. Clayton 59 "
 G. K. Zinner 1 day
 J. A. Brown 1 "
 G. R. Rayston 1 "
 J. R. Cain 2 "
 " 1 " 59 miles

which the S.E. on Dec 27
ch

1910

for chainmen

in center cottons 5 am which -

a B. Oak bears $N 35\frac{1}{2}^{\circ} E$ 134 lines

1,250^{ft} to where C & L

Boons fence


Enter Rayston land

-

post worked R & G from which
 a B. Oak 36 in dia brs $S 51\frac{1}{2}^{\circ} E$ 75 lines

10, 8 730 2 days 800
 10, 590 2 " 800
 chain man

"
 marker
 6 apple
 2 cherry
 2 peach
 3

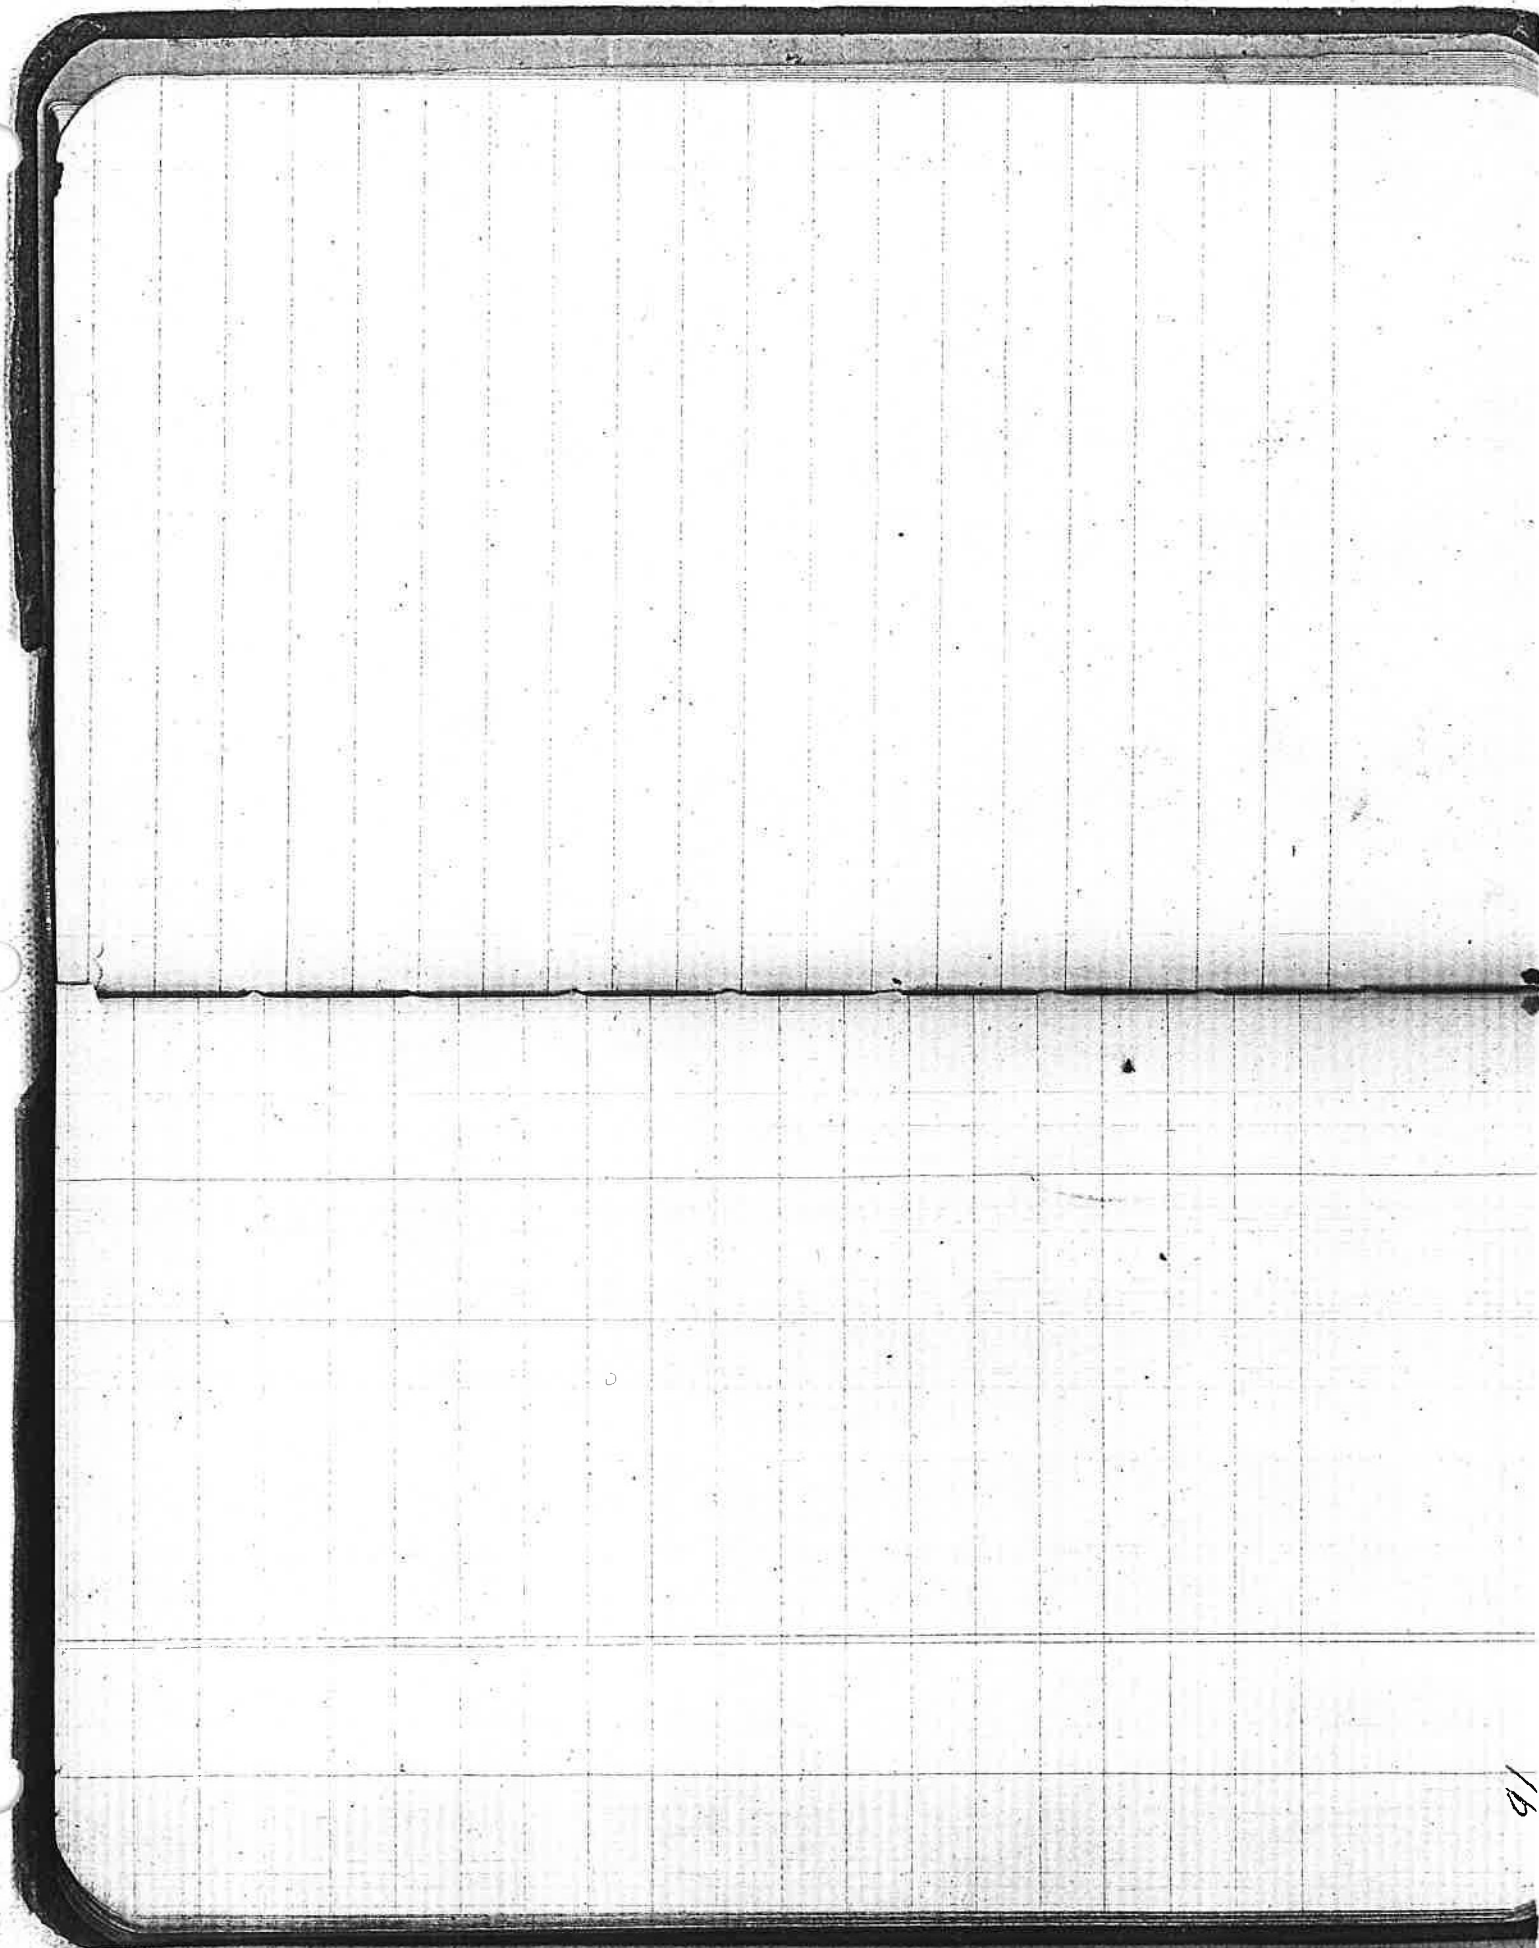

Henry Adams Jr
Survey March 31 - 1910

Beginning at a point in
Center Co Road 20.29 South and
9.58 East of the S.W. cor of Logans
right D.S. # 45, 2p 29-5
thence - var - 20°E

S $83\frac{3}{4}^{\circ}$ W 9.52 ✓

S $73\frac{1}{2}^{\circ}$ E 5.65 ✓

East 22.10 ✓

North 11.32 ✓

West 26.08 to place of beginning
Cont, 30. acres

Henry Adams
Sun mch 30 - 1910

2

Beginning at a point
in center of Co Road

29,70 South and 8,14 East
of the S.W. cor. of Lazarus right
SSB # 45 in Sp 29 - 5 W

Thence - var - 20° E

S $20\frac{3}{4}^{\circ}$ W 173 to rock at bridge

West 6,00 " Black oak tree

N $73\frac{1}{2}^{\circ}$ W 565 " place of beginning

Cont $\frac{48}{100}$ of an acre

3
101

Apr 21 1910

Survey for C. J. Linnwood

Begin in center of line

208

S 53 1/2° E 9.70

S 39° W 12.56

N 31° W 5.12

N 1° W 8.71

N 50° 15' E 3.75

to place of begin

beats N 74 1/2° E 29.50

2nd piece of 5 acres

Beginning at a Pt

Sec 33-34 2p 29 S R 5 W

Thence S 53 1/2° E 40.5 chains

" S 39° W 13.99 "

" N 31° W 3.77 4.05

" N 39° E 2.56 to place

" N 34° W

101

Apr 21 1910

Barney for C. L. Livingston

Begin in center of line

S 53 1/2° E 97.0

S 39° W 13.56

N 31° W 5.12

N 1° W 5.17

N 50° 15' E 3.35 to place of begin

begin N 74 1/2° E 29.50

2nd piece of 5 acres

Beginning at 0 ft

S 33° 34' E 29.50 AS 20

thence S 53 1/2° E 40.5 chains

S 39° W 13.99

N 31° W 5.77 4.05

N 39° E 22.56 to place

N 34° W

Cont 9.48 ac

The 1/4 Sec 20

chain

from which the 1/4 Sec 20

begin N 74 1/2° E 29.50 chain

of the 1/4 Sec 20

Begin at a point from which
addition to town of Biddle

thence N 56° E 9,000 ft

" S 13 3/4° W 4,000 ft

" S 61° E 3,630 ft

" S 49 1/2° W 2,110 ft

" S 29 1/2° W 4,060 ft

" N 32° W 5,310 ft

then

the NE cor of lot 12 in Maple Park
beats S 56° W 9,100 ft

— or 20° E

J B Biddle Mary & Richard
to

Sam and Margaret E. Yates

Apr 23 1910

Off Kake
Road
Survey of change in

Begin in center of Road

thence S 76° or 170' Enter
8,36
9,25 to center

of Kakey Enter Wilson
Road from
S. Road

118
170 on road of Kakey
6,66 1, 4 Wilson

666	118
170	131
3996	118
3330	354
37296	458
	03

S 19 1/2 E 16.00
S 66 1/2 or 117 to base of Kakey

Begin at Kakey 133.34
thence on road 133.34
to 30.0

C. J. H. wingood
Dec 23 1910

9

Begin at NE cor of 5th Street

Thence S 62 1/2° E

11 S 61 1/2° E

11 S 1 1/2° E

11 S 89 1/2° W or 89° 22' 54"

71.31° 3'

339° E

cont 37.97 acres

The 1/4 Sec 11

The 1/4 parcel between 33 1/2° 4 27.20
to N 68° E 27.20

Thence S 62 1/2° E 10.86 + 28 = 114 corners this distance

10.20

place of begin

1036

1035
1036
1037
11 Ape 25 1910

W. Dean Esq.,

Begin at point 300 ch west

North 10,43 var 20°

North 9,00

East 18,60 on South bray of
to East line of

East 26,25 " " "

East 36,79

North 0,90

South 0,70

North 14,25 to water edge

885/21 set South 190 ch

878 1/2 9,50 line in creek

875 1/2 6,50

875 1/2 1,50 100 yds south

884/27 1,62

South 1290 to pure of water

cont 25,04 ams - 57

16,19
13,51
2,68

12 2-600
25-
3679
1860
1819

29,72
3679
1860
1819

of 1/4 the point bet Sec 32-33-30-6

found to be same
J.R. Deans Land 1860 Begin & stop

J.R. Deans also in E. cor. of J.R.D.

in end Creek

thence on course 190 ch South of

8453 9,470.7

1,8962 5,879.5

3755 1,452.2

2,3170 1,612.0

18,4144

724,53

890000

2 2.5 to

Sec 30

Apr 25 1910

In Dean to Giff Lake

Beginning at a point

11.57 East of the $\frac{1}{4}$ sec cor

thence - var 20°E -

East 17.29

North 0.90

East 0.70

North 14.25°

to

cow

Grove

S 85 $\frac{1}{2}$ ° W 9.50S 78 $\frac{1}{2}$ ° W 6.00S 75 $\frac{1}{2}$ ° W 1.50N 84 $\frac{1}{2}$ ° W 1.20

South 12.90

Containing

24.53

acres

to place of beginning

900 ch north and
turn Sec 32 + 33 Twp 30 - 6

Apr 25 1910

J.R. 1799. Dean to Clara

Beginning at a point
East of the $\frac{1}{4}$ Sec post
thence East 40 links

" North 12,90 ch

" West 40 links

" South, 290 ch to
Containing .57 of an acre

900 North and 11.17
Whence Sec 32-33-30-6

piece of beginning

47

South

22,20" to SE cor of Reams Road
South 30,75"

East 8,72

North 30,75"

West 8,12 to piece of be gnt

Cont 74.96 a

W. O. Reams Road
14,25"
12,10"
26,35"

South from Cor. Creek 26,35"

also a piece on west side 1210 x 90 108900

18,10 East + 26,35 West

26,35"
18,10"
44,45"

26,35"
20,80"
47,15"

47,15"
1089

50,78250

19

Apr 26 1910

Survey for aiken

J. B. Dean and G. E. Rhodes chain
begin at 1/4 sec post with
thence from north corner 20° E -

31.61 to aiken SE corner

79.06 to 1/4 sec cor intersects 17

West 850

S. 61 1/2° W 3,000 50 Lts to Green

S. 54 1/2° W 6,000 100 " "

S. 59 1/2° W 5,000 100 " "

S. 45 3/4° W 7,000 60 " "

S. 37° 05' W 10,000 10 " "

S. 21° W 5,000 150 " "

S. 26 1/2° W 5,500 200 " "

S. 23° W 9,250 1,500 " "

S. 13 1/2° W 1,500 75 " "

S. 06° 10' W 1,660 50 " "

29,000

3,161

47,455

62

48,077

run - S. 20° W -

S. 34° 35' W 30-6 R, 6 W

W. E. East

29,000

62

47,455

31,611

48,077

1.10 Wilson Creek

Cont 147, 142

Begin at aising SE Cor. road

N 83 1/2° W "

33 Wilson Creek

35, 25° Intersect & line north of

North 68° W 506 to post on SE Cor. line

Stone

Wilson Creek SE Cor. aising road

Ca. Skinning road

Begin $2\frac{1}{4}$ past betn

" and ran N. 60° W var

500 to fence

$316\frac{3}{4}$ E 18.18 to fence of hay

$316\frac{3}{4}$ E 14.10

East 21.55

$3\frac{1}{2}$ W 11.25

$7.83\frac{3}{4}$ W 2.25

$8.84\frac{1}{4}$ W 3.00 $\times 50$ (835)

$8.85\frac{1}{2}$ W 4.75 $\times 50$

W. 5.00

$8.75\frac{1}{2}$ W 6.25

$8.52\frac{1}{4}$ W 3.75 to place 2.25

$15.98\frac{3}{4}$ $\times 5.97$

24

W. 5.00

86

to place 2.25

$15.98\frac{3}{4}$ $\times 5.97$

33 534 - 29 - J

20.5 East 483 2.50

17.41 5.24

19.91

24

11.25 0.9

2.16

36 2.98

280 6.14

5.00

West.

162 6.03

$575^{\circ}30'W$

2.97

$N53^{\circ}00'W$

16.14 25.88

15.97 25.88

15.97

31.496
 $264\frac{1}{2}$
 31.496

Indian Lake

Began at point

9.00 North and 8.17 East

thence East 18.19 ch

" North 0.90 "

" East 0.70 "

" North 14.25 to

" S 85 1/2° W 9.50

" S 78 1/2° W 6.50

" S 75 1/2° W 1.50

" N 84 1/2° W 1.62

South 1.290 to be

see if beginning com 26.68-a

7 1/4 be post but do 32 185.30-d

and, given

12924
5160

J.A. Dean and his wife

Beginning at

8.17 East of 1/4 Sec 30

Thence East 40 links

" North 13.86 ch

" N 84 1/2 W 40 "

" South 12.90 "

cont. 51 a

J.A. Dean to in Dean

a point 900 north and

West Sec 3.2 + 33 26 30 - 6

to piece of beginning

Begin at a point

off $\frac{1}{4}$ Sec cor her Sec 32

Thence

South 22.25'

" West 7.65'

South 8.50

East 15.24

North 30.25'

West 7.59 to the

cont. 29.84 acres

containing 52.50

15,828 ac and 900 North
33 2p 30.6

if begin

see

9th 1/2 Sec 12 - 30 - 1
containing 0.9 acres

Field Book No. 11

**Pages 31 through end of book blank
EXCEPT last 3 pages (NOT SCANNED)**

~~J. S. Morrison~~ ad to myrtle Creek
J. S. Morrison and B. M. Morrison

his wife

J. S. Morrison and E. M. Morrison

his wife,

Point of beginning is 17' 6" W
South of stone in road

Beq, Lk stone 12x10x6 red quartz
from Kelley, 2x4

See Bayless, to Morrison

on south 4 acres 2 or 3
black

84'
14.81
688
20
6181
18.60
36.79

3430-6

North But 34 + 35 - var 17° 30'

9.08 Stream 16 lks wide

40.00 1/4 Sec post

o r o a r 16 in S. 60° E 3 1/4 lks

" " " 12 " N. 81° W 4 5/8 "

80.00 Cor Secs 26, 27, 34 + 35

o r o a r 18 in N 11° W 3 1/2

" " " 21 " N 28° E 4 1/8

" " " 28 " S 17° W 1007

no tree near S.E.

North But 26 + 27

40.00 1/4 Sec

o r o a r 18 in S 13° W 232

" r o a r 6 " S 10° E 187

1421
96
1517

1290
1521
231

