

AARON ROSE
DON. CL. 39

DEER CREEK

MAIN ST.
ST.

2ND RAILROAD
ADD


T. 27 S. R. 5 W. W.M.
T. 27 S. R. 6 W. W.M.

Beg. of Trestle 1267+10
Beg. of Fence 1267+00
(Fence 2.B.W-2.B.Polizc-d)

AIKEN'S
800 OD. Girder Br.
15 OD. Pole Trestle
Trespass Sign

E. SECOND AVE.
SOUTH
E. FIRST AVE.
SOUTH
E. THIRD AVE.
SOUTH
E. COMMERCIAL ST.
SOUTH
E. FOURTH ST.
SOUTH
E. FIFTH ST.
SOUTH
E. SIXTH ST.
SOUTH
E. SEVENTH ST.
SOUTH
E. EIGHTH ST.
SOUTH
E. NINTH ST.
SOUTH
E. TENTH ST.
SOUTH
E. ELEVENTH ST.
SOUTH
E. TWELFTH ST.
SOUTH
E. THIRTEENTH ST.
SOUTH
E. FOURTEENTH ST.
SOUTH
E. FIFTEENTH ST.
SOUTH
E. SIXTEENTH ST.
SOUTH
E. SEVENTEENTH ST.
SOUTH
E. EIGHTEENTH ST.
SOUTH
E. NINETEENTH ST.
SOUTH
E. TWENTIETH ST.
SOUTH
E. TWENTY-FIRST ST.
SOUTH
E. TWENTY-SECOND ST.
SOUTH
E. TWENTY-THIRD ST.
SOUTH
E. TWENTY-FOURTH ST.
SOUTH
E. TWENTY-FIFTH ST.
SOUTH
E. TWENTY-SIXTH ST.
SOUTH
E. TWENTY-SEVENTH ST.
SOUTH
E. TWENTY-EIGHTH ST.
SOUTH
E. TWENTY-NINTH ST.
SOUTH
E. THIRTIETH ST.
SOUTH

JACKSON ST.
WINCHESTER ST.
PARK ST.
PROSPECT ST.
NORTH
BELLVIEW ST.
W. FIRST AVE.
WEST NORTH
BEACON ST.
ST.

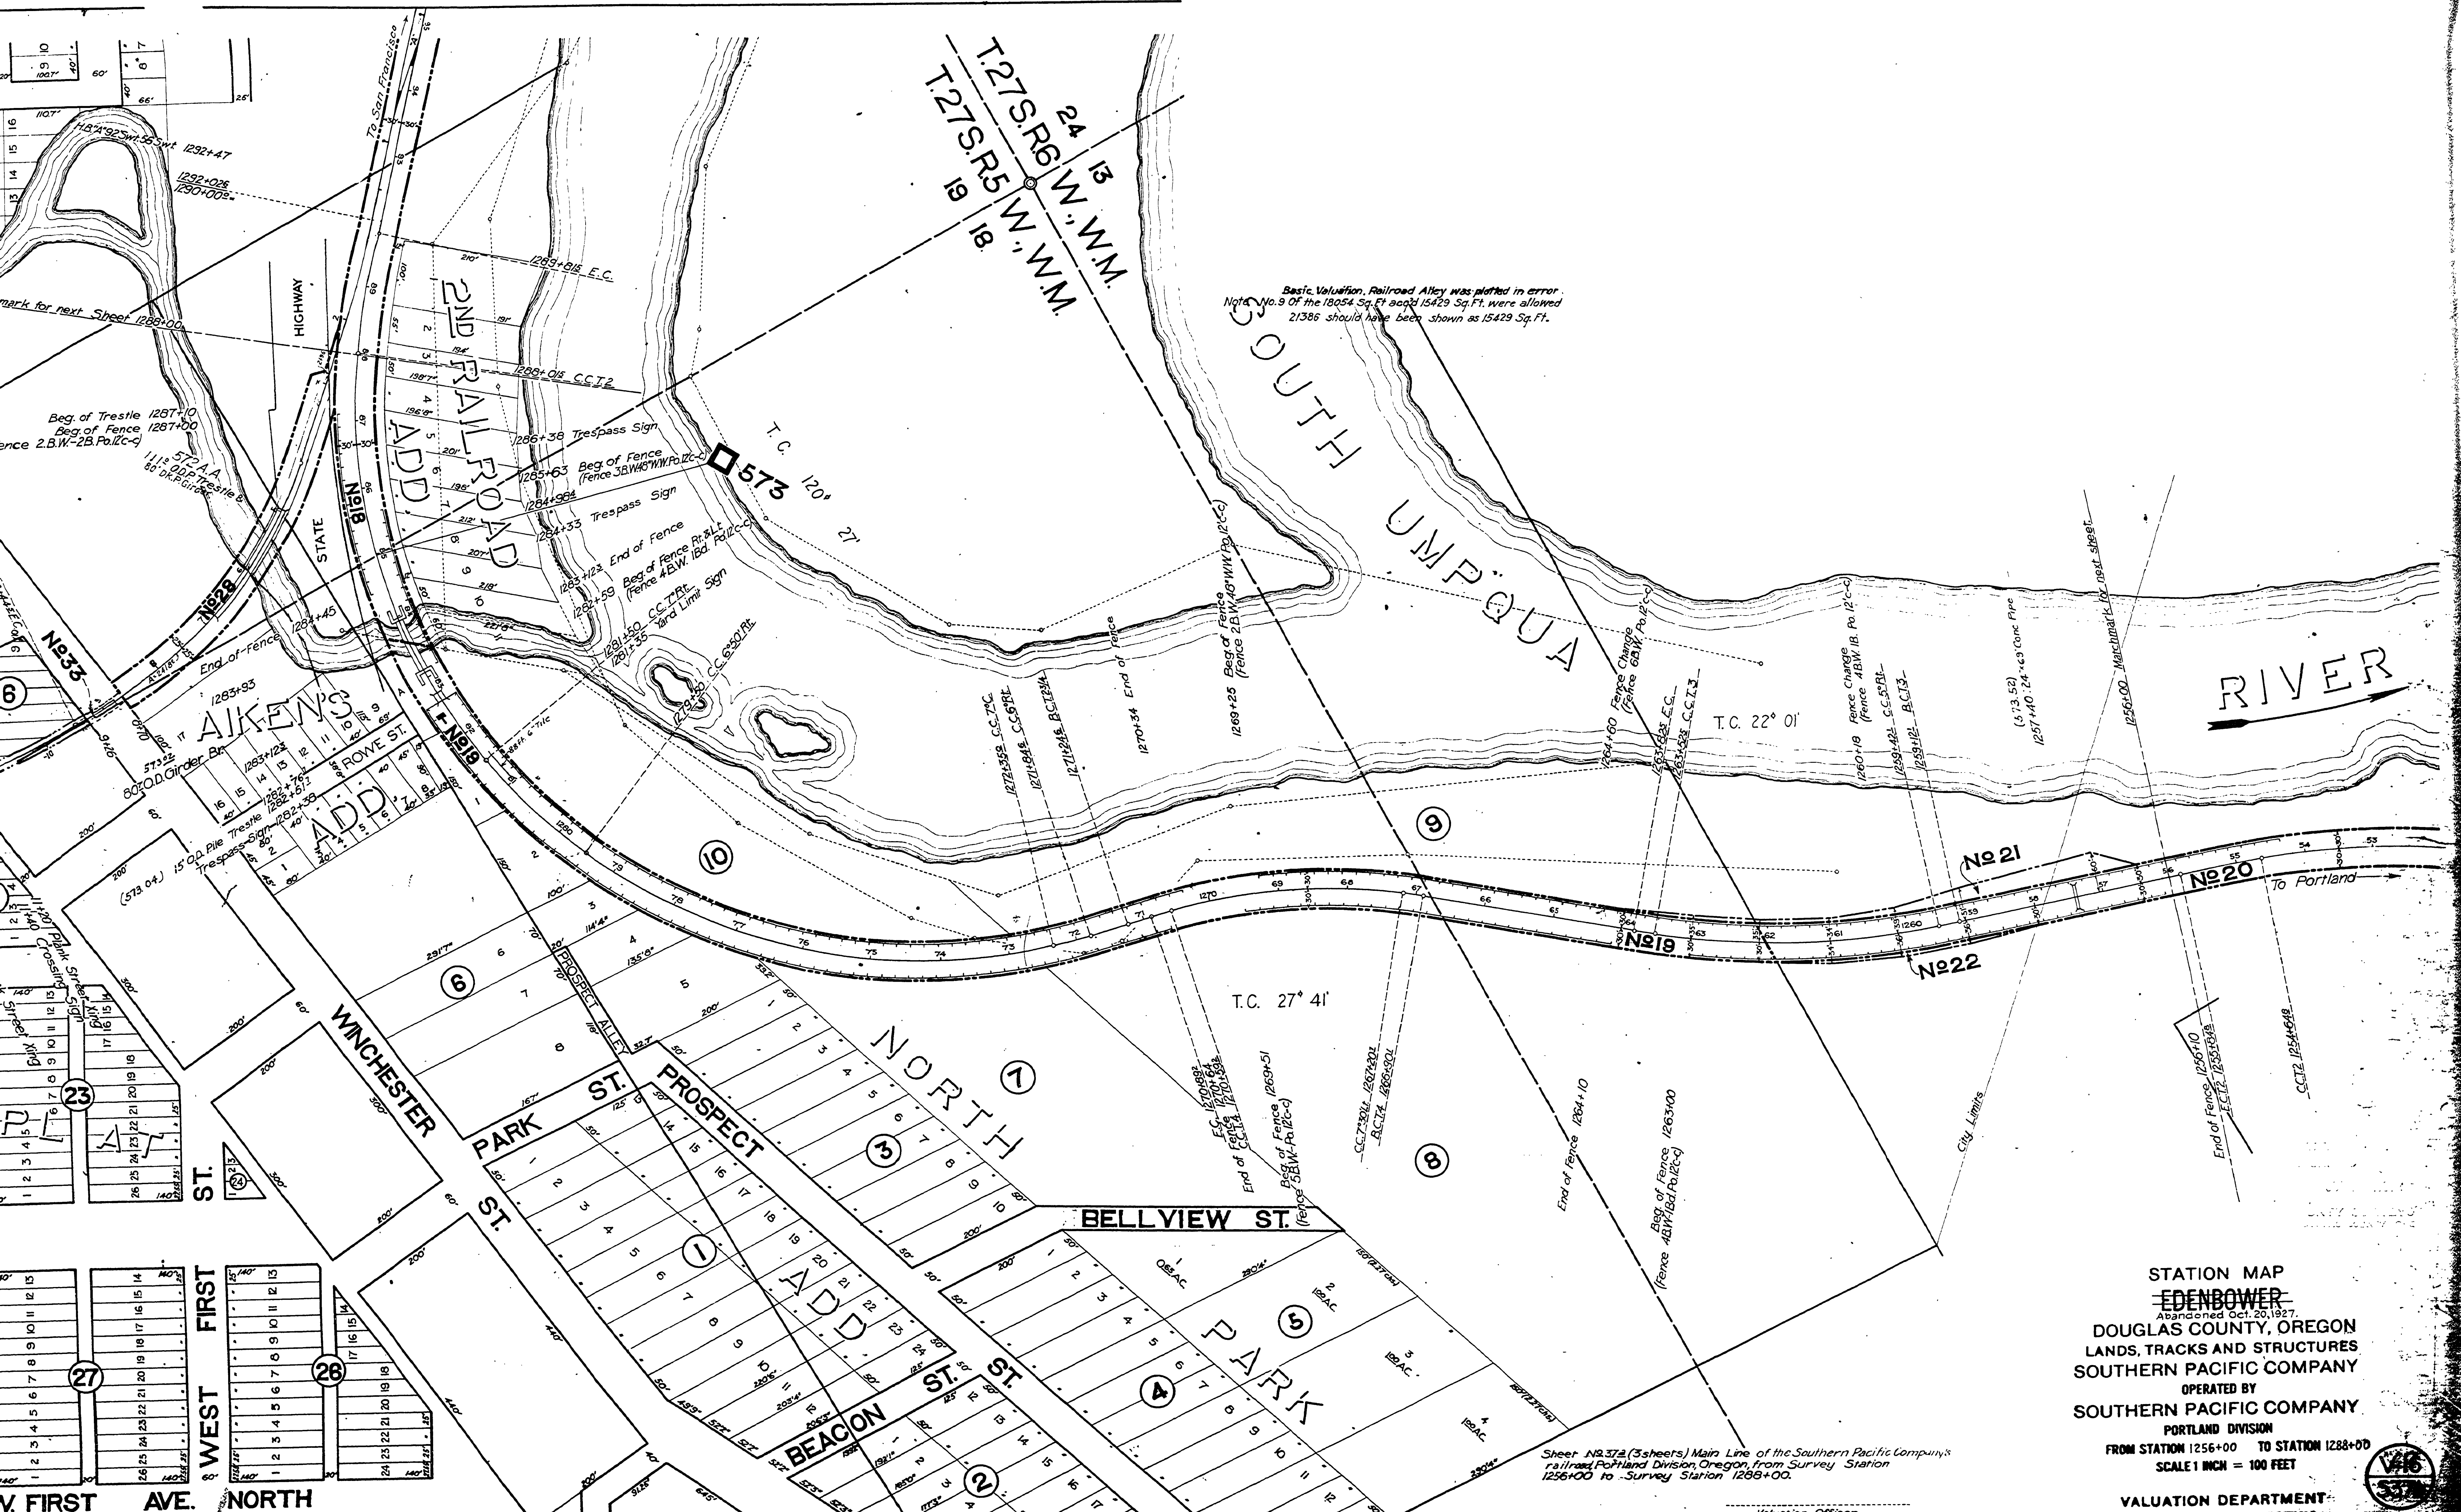

Basic Valuation. Railroad Alley was plotted in error.
 Note: No. 9 of the 18054 Sq. Ft. and 15429 Sq. Ft. were allowed
 21386 should have been shown as 15429 Sq. Ft.

STATION MAP
 EDENBOWER
 Abstracted Oct. 20, 1927.
 DOUGLAS COUNTY, OREGON
 LANDS, TRACKS AND STRUCTURES
 SOUTHERN PACIFIC COMPANY
 OPERATED BY
 SOUTHERN PACIFIC COMPANY
 PORTLAND DIVISION

FROM STATION 1256+00 TO STATION 1288+00
 SCALE 1 INCH = 100 FEET

VALUATION DEPARTMENT
 SAN FRANCISCO, CALIFORNIA

Sheet No. 37a (3 sheets) Main Line of the Southern Pacific Company's
 railroad, Portland Division, Oregon, from Survey Station
 1256+00 to Survey Station 1288+00.

Valuation Officer

