


DOUGLAS COUNTY OREGON  
**MEDLEYS-ELKHEAD RD. C50**  
 SECTION 32-T.23S-R.4W.  
 F.C. FREAR CO. ENGR.  
 1932  
 SHEET 5

SCALE 1" = 10' VERT.  
 1" = 100' HOR.

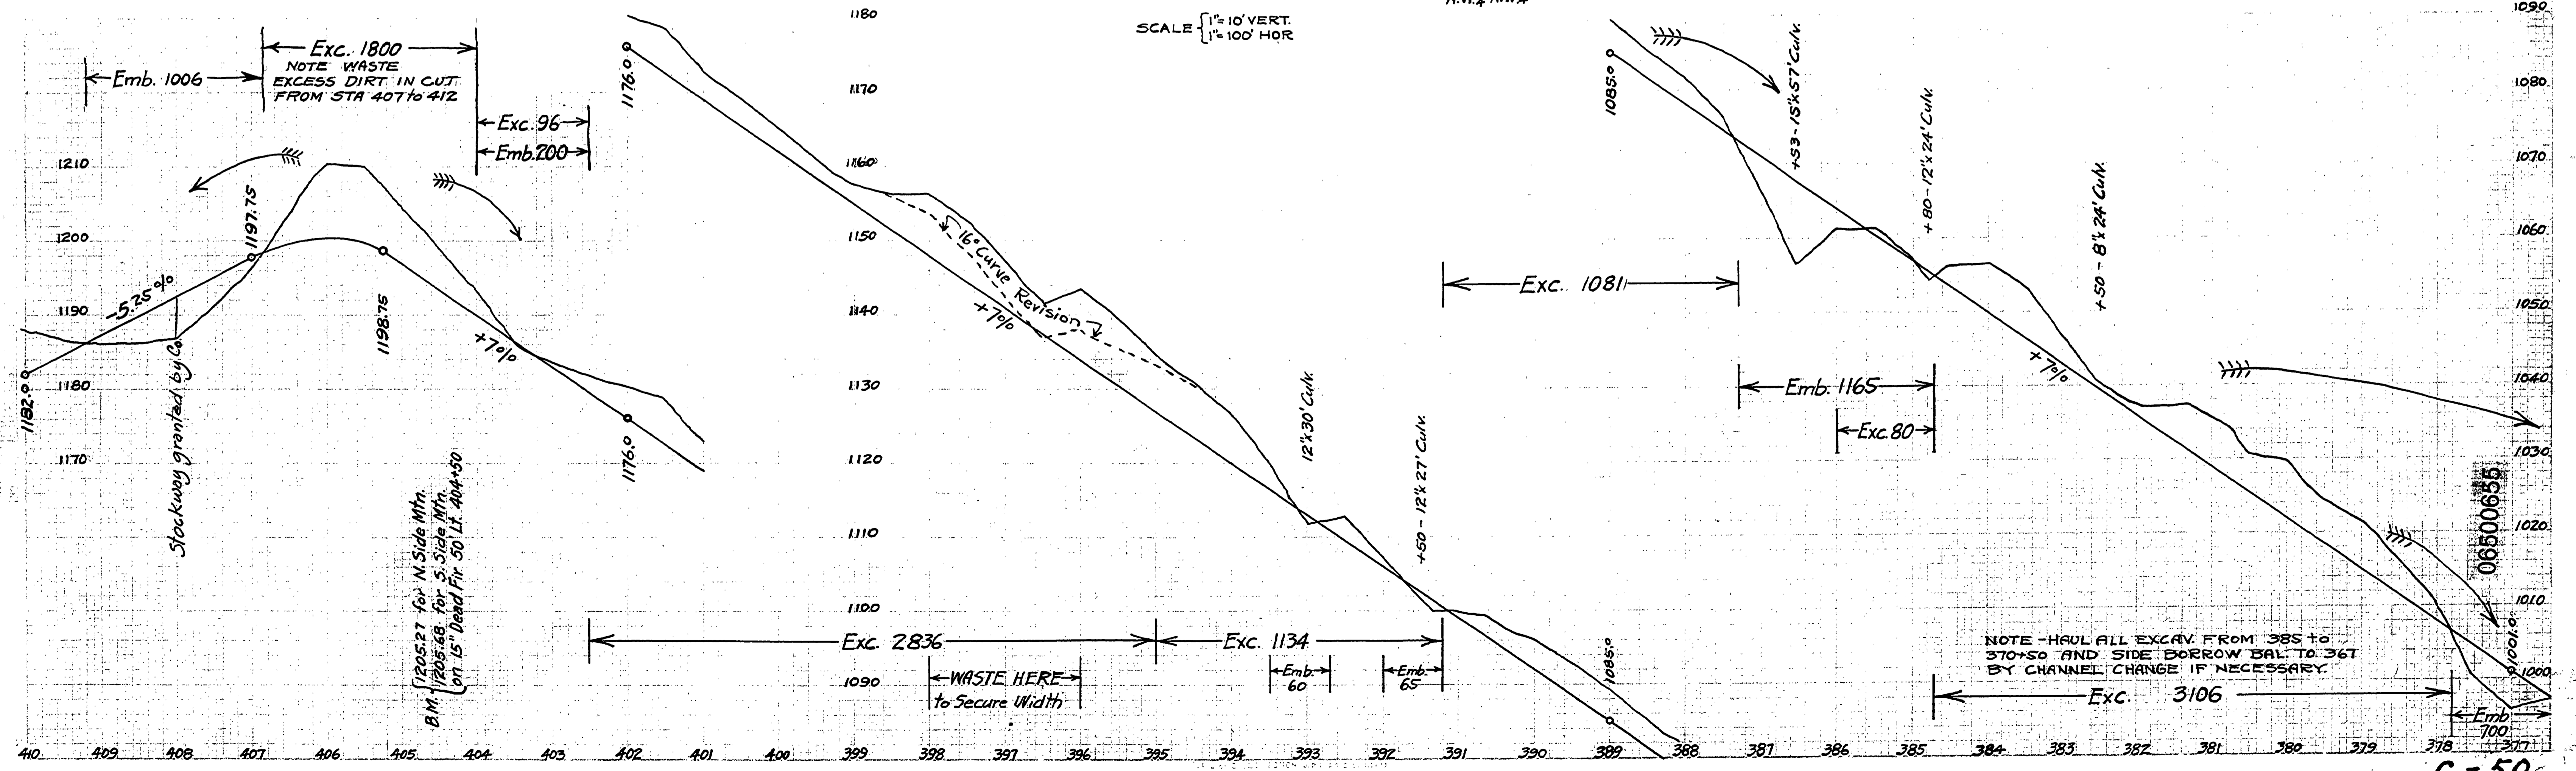

NOTE - HAUL ALL EXCAV. FROM 385 TO 370+50 AND SIDE BORROW BAL. TO 367 BY CHANNEL CHANGE IF NECESSARY.

C-50

~ M.P. 6.50

T.23S-4 SEC. 32-1932-SHT 5 OF 7