

FILED
Date 3/19/2006 By: JP
This survey consists of:
Map _____
Native _____
Corner Rot. _____
DOUGLAS COUNTY
SURVEYOR

HATCH KEY
PHASE 1A

TL 900
LUTHER, TODD & JENNIFER
224 FISK LANE
ROSEBURG, OR 97470

TL 102
HELLENTHAL, ERIK
10190 N UMPQUA HWY.
ROSEBURG, OR 97470

TL 101
MCJUNKINS, JIMMY & CAROL
4542 SW STELLA
ROSEBURG, OR 97470

TL 3800
AMES, HAROLD & VERA
4508 STELLA ST.
ROSEBURG, OR 97470

TL 3600
HELLENTHAL, ERIK
10190 N UMPQUA HWY.
ROSEBURG, OR 97470

TL 100
BODFIELD, ARLENE
2548 SW LANDERS LN.
ROSEBURG, OR 97470

TL 4800
CALKINS, GARY & KATHRYN
14229 SPANAWAY LOOP RD.
TACOMA, WA 98444

TL 201
DOUGLAS COUNTY SCHOOL DIST.#4
1419 NW VALLEY VIEW DRIVE
ROSEBURG, OR 97470


TL 301
DOUGLAS COUNTY SCHOOL DIST.#4
1419 NW VALLEY VIEW DRIVE
ROSEBURG, OR 97470

CALL BEFORE YOU DIG I
ONE CALL: (800) 332-2344
OAR 952-001-0010 THROUGH
OAR 952-001-0090

TL 401
DOUGLAS COUNTY SCHOOL DIST.#4
1419 NW VALLEY VIEW DRIVE
ROSEBURG, OR 97470

i.e.
ENGINEERING
505 SE Main Street
Roseburg, Oregon 97470
PHONE (541) 673-0166
FAX (541) 440-9392
Email: iemail@ieengineering.com
Project Name:

0' 50' 100' 200'
SCALE: 1"=100'

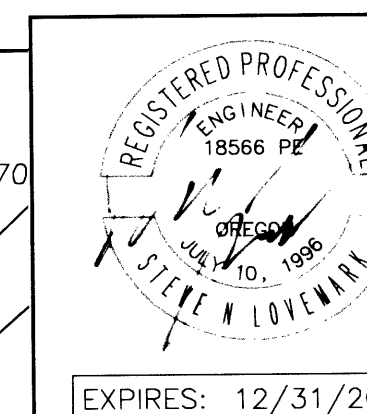

Rev.	Date	Dwg	Description
1	7/1/05	JDL	AGENCY REVIEW
2	4/13/06	JDL	AS-BUILT PHASE 1A
3	8/9/06	NRJ	AS-BUILT PHASE 1B

RIVER CREST ESTATES 2 PHASE 1	
Title:	PHASE 1, 2, & 3 EXISTING TOPOGRAPHY
DES DMA	PROJECT NO. 1944-0312
DWG JDL	DATE: MAY 20, 2005
CHK SNL	SCALE: AS SHOWN
APP SNL	SHEET: 2 OF 18

C. RA # 366, 375J, 375N, 375O, .88B, 288C, 288D

EXIST. TOPOGRAPHY CO. RDS. 366 375J 375N
375O 288B 288C 288D

DO NOT DUPLICATE

375288TP