


FILED
 Date: 9/7/2006 By: JC
 This study consists of:
 Map: Sheet 2/9
 Number of:
 Corner: 9 Sheets
 DOUGLAS COUNTY
 SURVEYOR

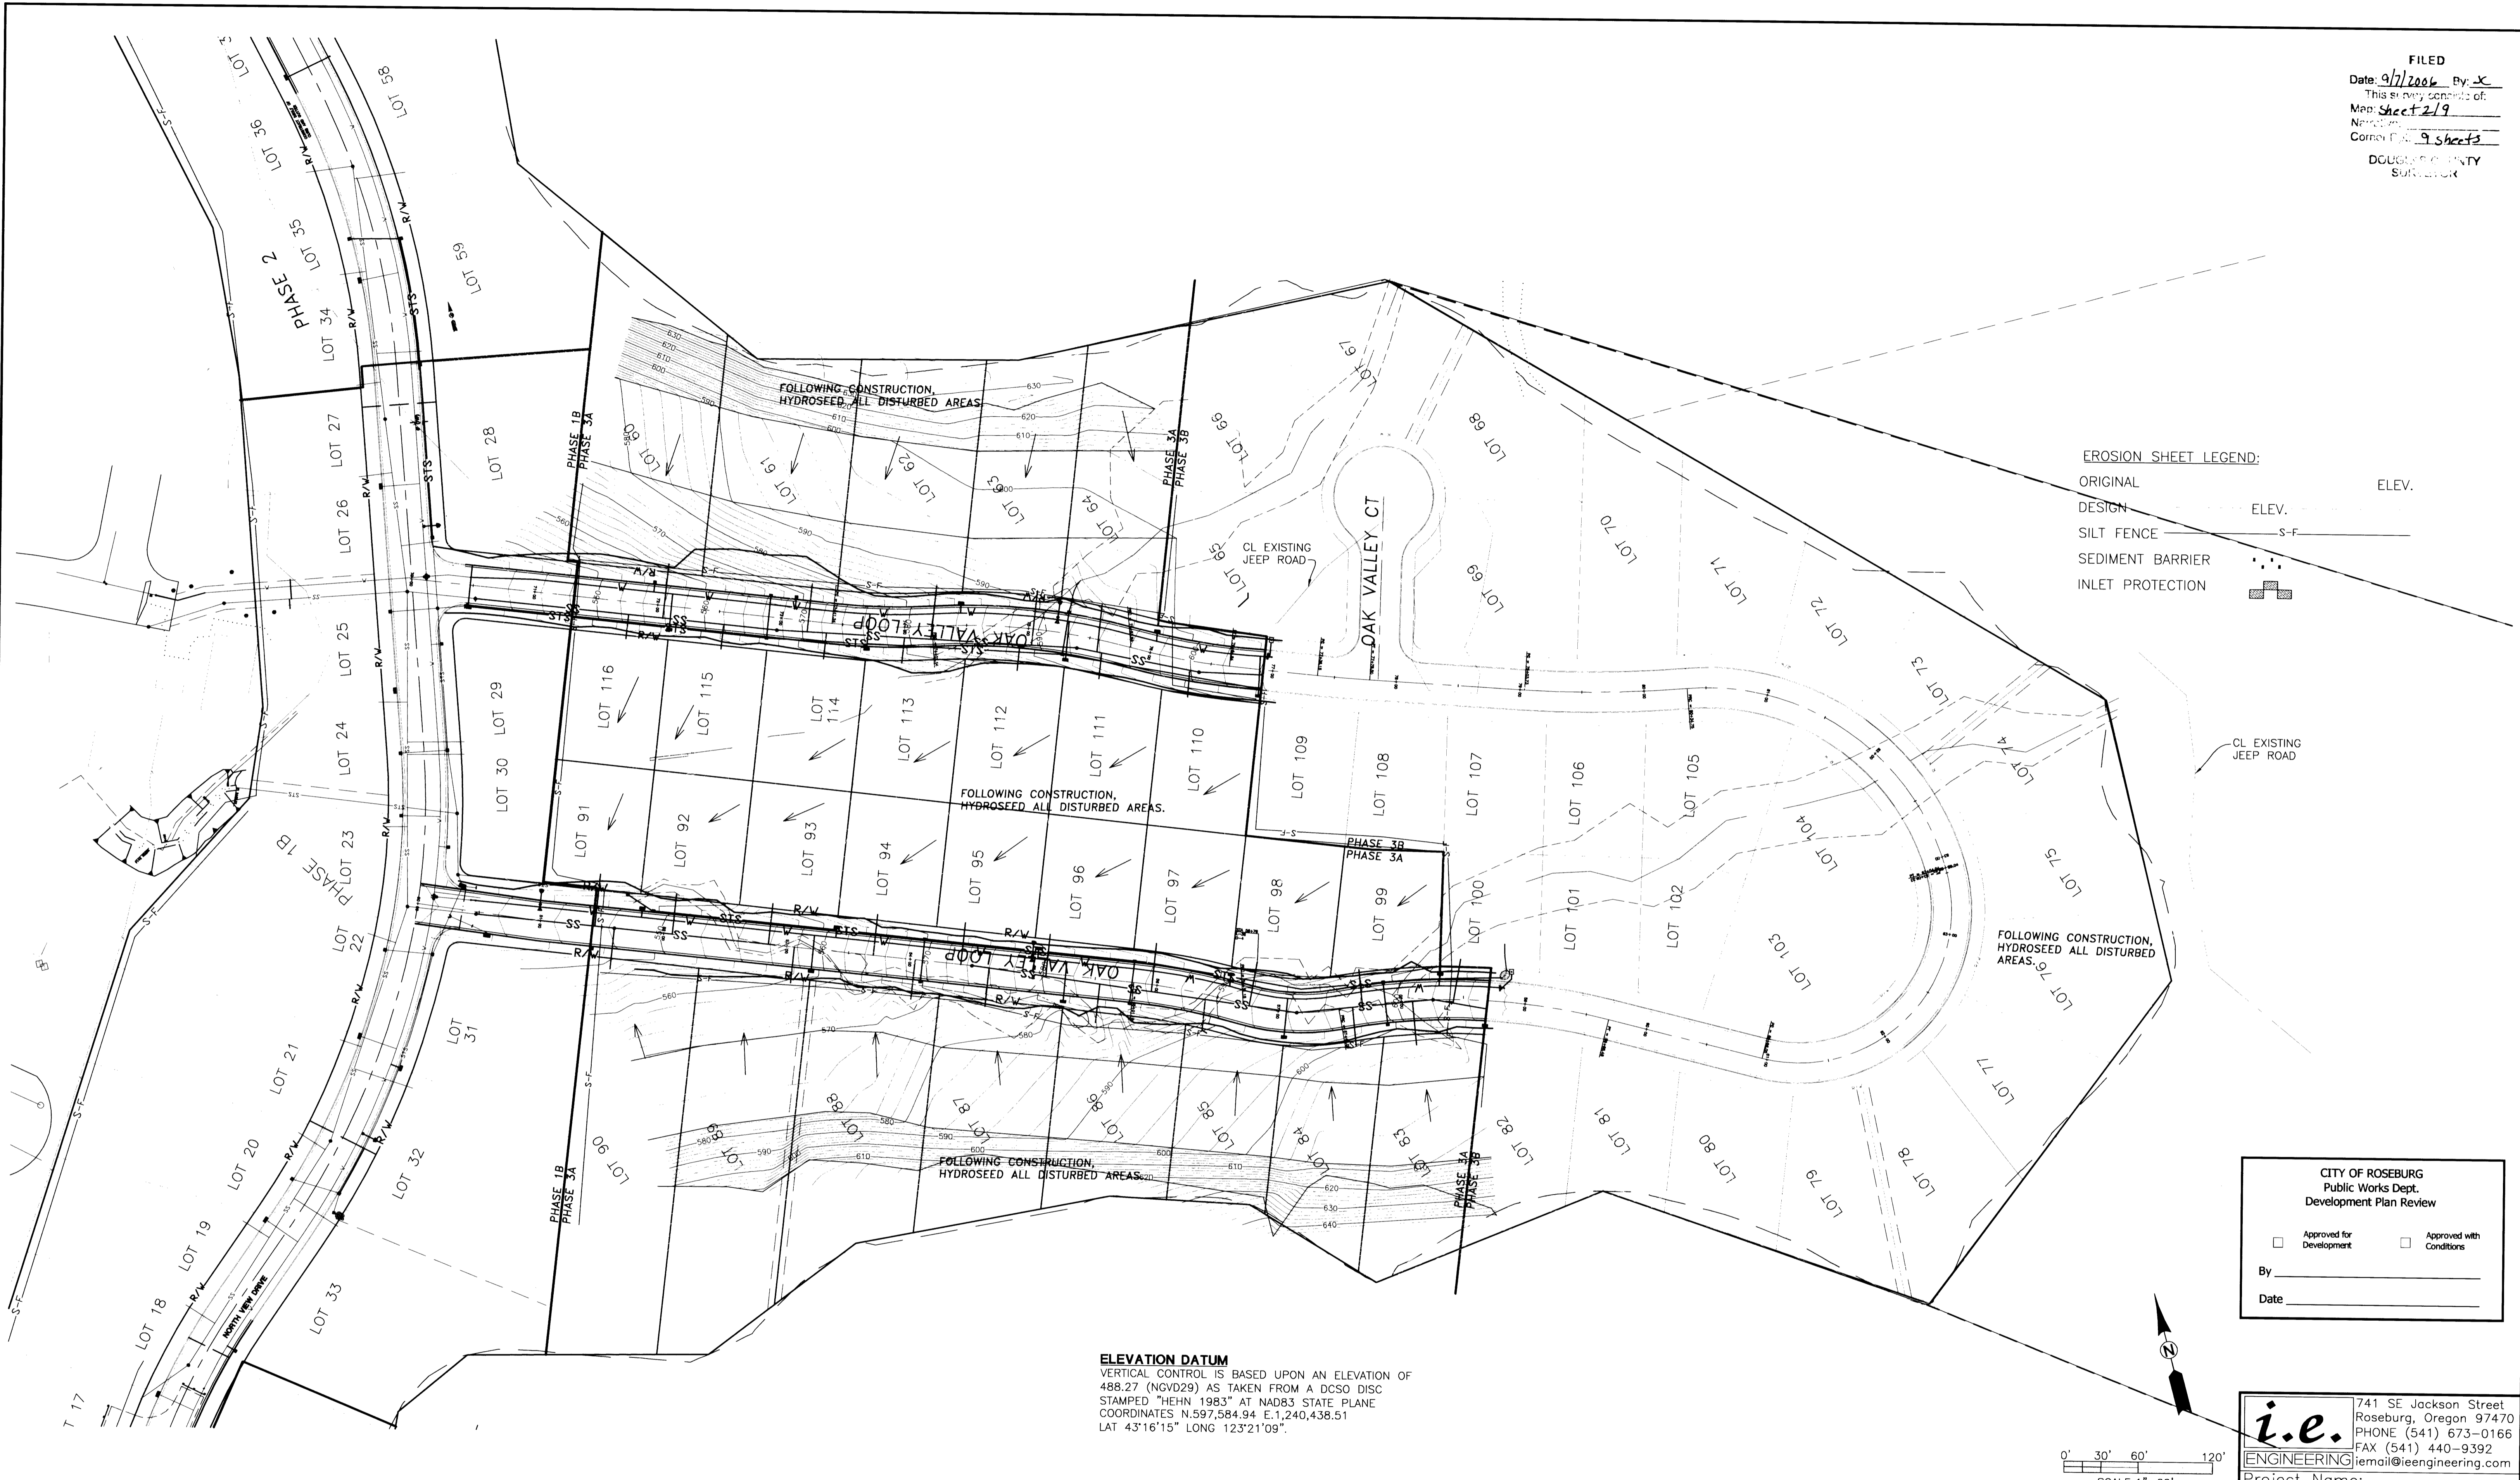

EROSION SHEET LEGEND:
 ORIGINAL DESIGN ELEV. _____
 SILT FENCE S-F _____
 SEDIMENT BARRIER _____
 INLET PROTECTION _____


FOLLOWING CONSTRUCTION, HYDROSEED ALL DISTURBED AREAS.

FOLLOWING CONSTRUCTION, HYDROSEED ALL DISTURBED AREAS.

ELEVATION DATUM
 VERTICAL CONTROL IS BASED UPON AN ELEVATION OF 488.27 (NGVD29) AS TAKEN FROM A DCSO DISC STAMPED "HEHN 1983" AT NAD83 STATE PLANE COORDINATES N.597,584.94 E.1,240,438.51 LAT 43°16'15" LONG 123°21'09".

CITY OF ROSEBURG
 Public Works Dept.
 Development Plan Review
 Approved for Development
 Approved with Conditions
 By: _____
 Date: _____

i.e. ENGINEERING
 741 SE Jackson Street
 Roseburg, Oregon 97470
 PHONE (541) 673-0166
 FAX (541) 440-9392
 Email: iemail@ieengineering.com
 Project Name: _____

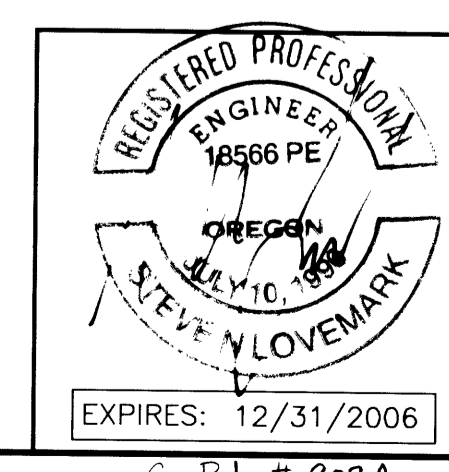

Rev.	Date	Dwg	Description
3	1/06/05	NRJ	AS-BUILTS

TAFT HEIGHTS PHASE 3A
 Title: OAK VALLEY LOOP OVERALL & EROSION CONTROL
 DES DMA PROJECT NO. 1733-06
 DWG BWC DATE: MAY 26, 2004
 CHK SNL SCALE: AS SHOWN
 APP SNL SHEET: 2 OF 9

Co. Rd. # 908A

CO RD #908A

R908EROS