


# SURVEY FOR DEED DESCRIPTIONS

PORTIONS of SECTIONS 31 & 32, T. 24 S., R. 7 W., W. M

Surveyed for B.N. Glanville  
 November 1970  
 Scale: 1" = 100'

Bress. Cap. f. BT's  
 South 1/4 Con. Sec. 32

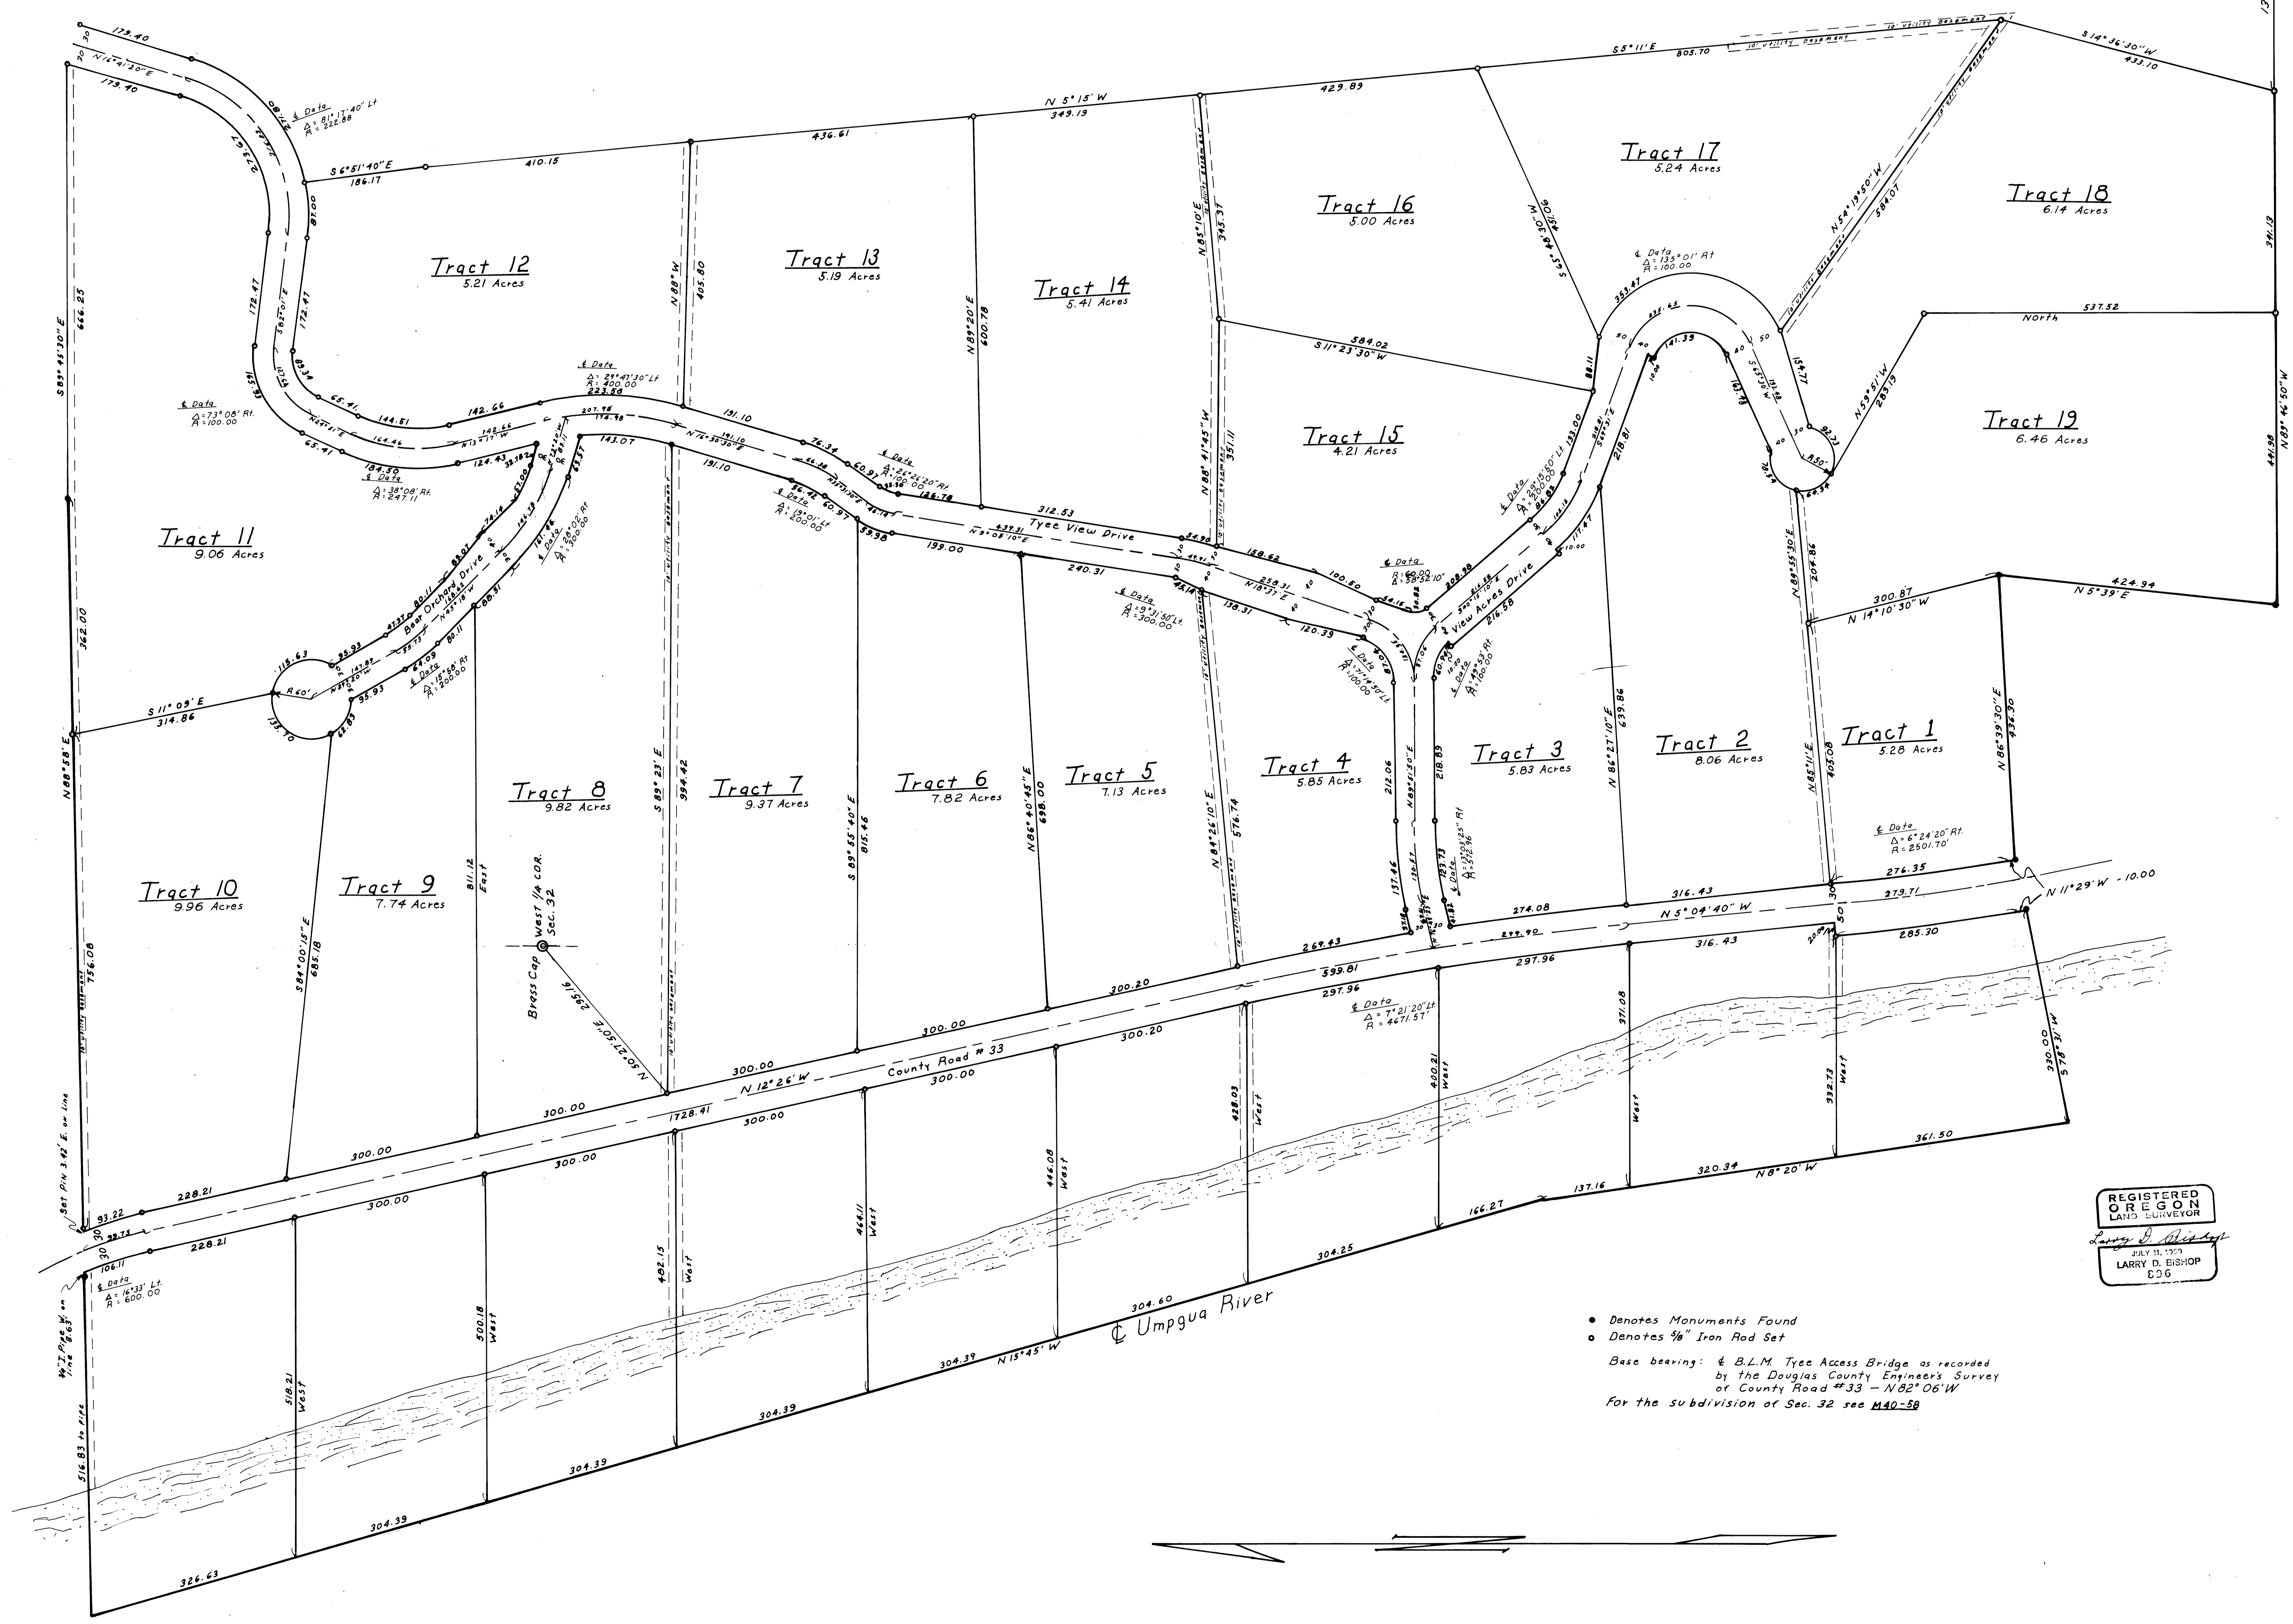

REGISTERED  
 OREGON  
 LAND SURVEYOR  
 LARRY D. BISHOP  
 606

• Denotes Monuments Found  
 ○ Denotes 1/2" Iron Rod Set  
 Base bearing:  $\frac{1}{2}$  B.L.M. Tree Access Bridge as recorded by the Douglas County Engineer's Survey of County Road # 33 - N 02° 06' W  
 For the subdivision of Sec. 32 see M 40-58

