


Basis of bearings is
the line from the
S 1/4 to the C 1/4

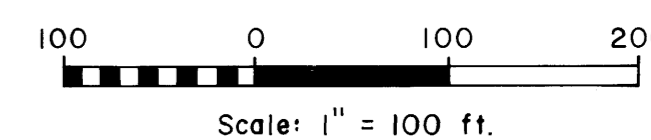

LEGEND

- Corner found, brass cap unless noted ⊙
- Corner found, 5/8" iron rod unless noted ○
- Corner set, 5/8" x 30" iron rod with aluminum cap mkd. "Shaner Engr. RLS 430" ●
- Corner computed, not set ◦
- Property line —

NARRATIVE

The purpose of the survey was to mark the property corners & lines as shown hereon. The following surveys, on file at the Douglas County Surveyor's Office were referred to:

Ref. No. (R)	Map File No	Surveyor	Date
1	M83-63	H. Johnstone	1980
2	M 15-40	J. W. Byron	1959
3	RM2-35	V. McLind	1972
4	USGLO (DLC)		1863
5	USGLO		1855
6	USGLO		1928

The survey was done in June, 1998, using a Jena 0°00'01" theodolite and a Mac II electronic distance meter.

PROPERTY LINE SURVEYS
in the SE 1/4 of Section 29, T29S, R7W, W.M.,
Douglas County, Oregon

For: David West
174 W. Tanager Street
Roseburg, Oregon 97470
B Seneca Timber Co.
P.O. Box 851
Eugene, Oregon 97440

By: Shaner Engineering, Inc.
P.O. Box 1430
Roseburg, Oregon 97470

June 6, 1998

REGISTERED
PROFESSIONAL
LAND SURVEYOR
Bruce A. Shaner
OREGON
001-3788
BRUCE A. SHANER
430
Renews June 30, 1998

