


3" Crushed Stone Base Course, Class 2, Grading D-1  
 6" Crushed Stone Base Course, Class 2, Grading B-1  
 3" Crushed Stone Base Course, Class 2, Grading D-1  
 1 1/2" Class "A" Surface Treatment - (AT-126)

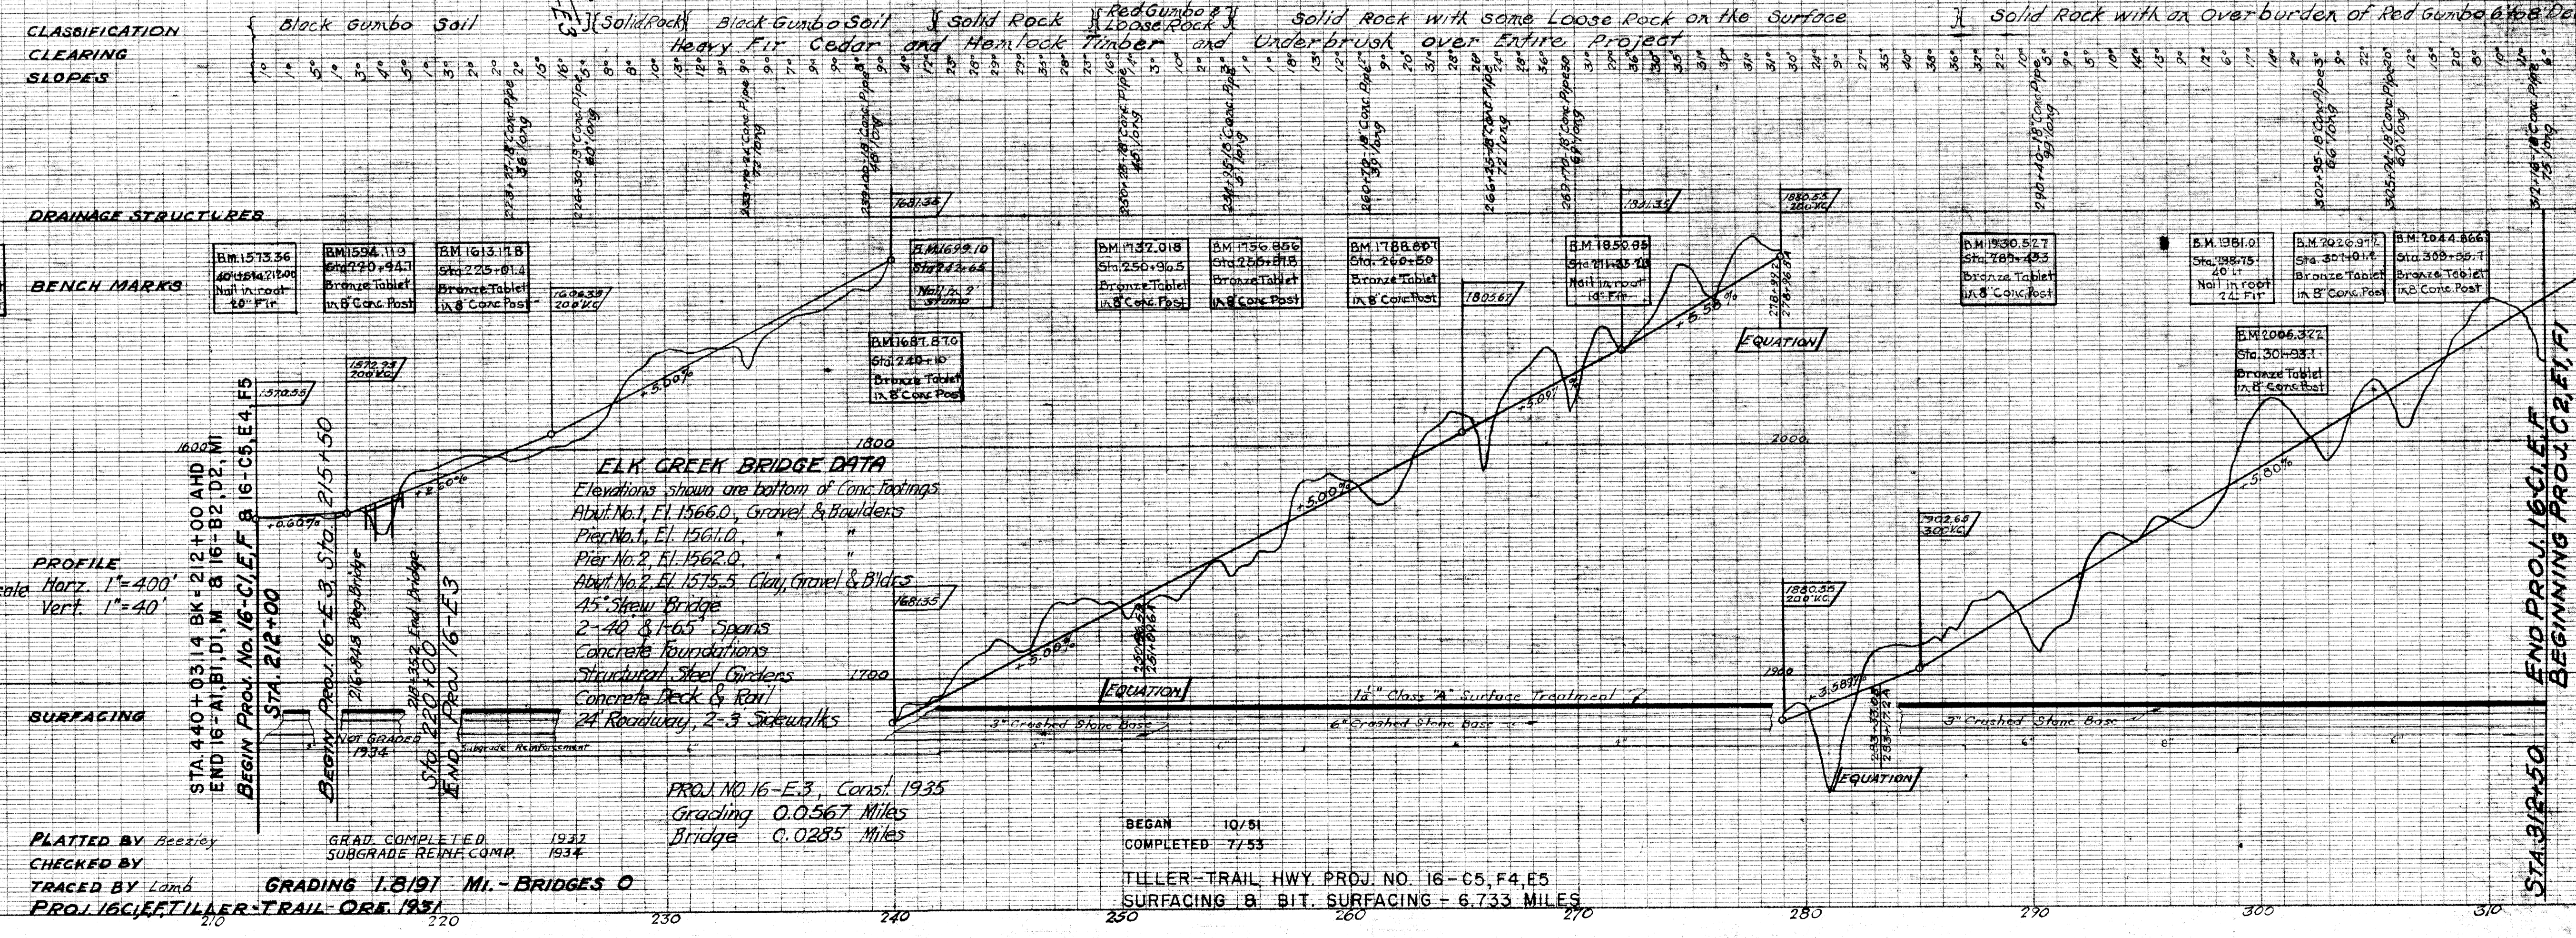

**ELK CREEK BRIDGE DATA**  
 Elevations shown are bottom of Conc. Footings  
 Abut. No. 1, El. 1566.0, Gravel & Boulders  
 Pier No. 1, El. 1561.0  
 Pier No. 2, El. 1562.0  
 Abut. No. 2, El. 1575.5, Clay, Gravel & B'ldgs  
 45' Spaw Bridge  
 2-40 & 1-65 Spans  
 Concrete Foundations  
 Structural Steel Girders  
 Concrete Deck & Rail  
 24' Roadway, 2-3 Sidewalks

PLATTED BY Beezley  
 CHECKED BY Lamb  
 TRACED BY Lamb

GRAD. COMPLETED 1932  
 SUBGRADE REINF. COMP. 1934

PROJ. NO. 16-E.3, Const. 1935  
 Grading 0.0567 Miles  
 Bridge 0.0285 Miles

BEGAN 10/31  
 COMPLETED 7/53

TILLER-TRAIL HWY. PROJ. NO. 16-C5, F4, E5  
 SURFACING 8.817 MILES  
 SURFACING - 6.733 MILES

END PROJ. 16-C1, E, F  
 BEGINNING PROJ. 16, F, I  
 STA. 312+50