

NARRATIVE:


The north line of Section 16 was surveyed for the purpose of establishing a timber cutting line. The original USGLO 1/4 corner was gone so I set a new one by proportional measurement. The survey was done in June, 1994, using a Jena 0°00'01" theodolite and a Mac II electronic distance meter.

See corner restoration forms filed in CS File _____.

LEGEND

- Corner found, brass cap ⊙
 - Corner set, 2 1/2" brass cap on a 1" x 30" iron pipe ●
- (See CS File)

**COUNTY SURVEYORS FILE DATA
DO NOT REMOVE FROM OFFICE**

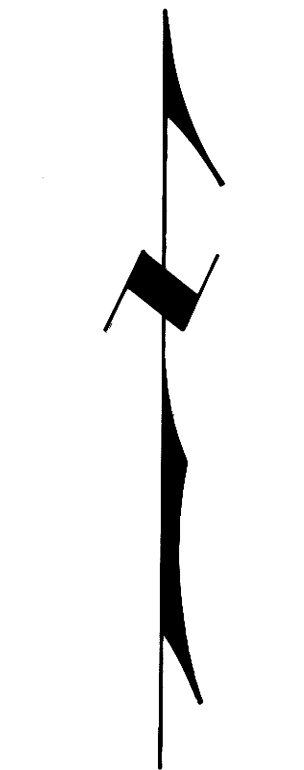

Basis of bearings is the USGLO record of due West on the section line



Scale: 1" = 400 ft.

**REGISTERED
PROFESSIONAL
LAND SURVEYOR**

Bruce A. Shaner

OREGON
OCT. 4, 1957
BRUCE A. SHANER
430

Expires Dec. 31, 1994

**PROPERTY LINE SURVEY
of the north line of Section 16, T32S, R8W, W.M.,
Douglas County, Oregon**

For: Superior Lumber Co.
P. O. Box 250
Glendale, Oregon 97442

By: Shaner Engineering, Inc.
P. O. Box 1430
Roseburg, Oregon 97470

June 30, 1994

FILED

Date: 7-11-94 By: AP
This survey consists of:
Map: M120-31
Narrative: _____
Corner Rpt: C.S. 63/154

**DOUGLAS COUNTY
SURVEYOR**

C.S. File No. 63/154
MAP FILE M120-31

C.S. File No. 63/154
MAP FILE M120-31

M 120-31

FILED

Date: 7-11-94 By: JP
This survey consists of:
Map: M 120-31
Narrative: _____
Corner lpts: C.S. 63/154

OREGON CORNER RESTORATION FORM

Section 16 Township 32S Range 8W

County Douglas Date June 30, '94

DOUGLAS COUNTY
SURVEYOR

Corner Designation

9 | 10
16 | 15

- Condition Report Only
- Not Found
- Renewed
- Unrecorded
- Surveyed In
- Referenced Out

Previous Renewals/Surveys, etc.

Douglas County Surveyor, 1968 (Powell)

Monument(s) & Accessories Found: (Condition and Source)

Found 2 1/2" Brass Cap on a 1" Galv. Iron Pipe, from which a:

40" D. Fir BT, scribes visible, bears S28°W, 34.3 feet.


10" Madrone BT, face overgrown, bears N53°W, 27.8 feet
(record 28.8 feet).

16" Pine BT (record 8"), bears N88°E, 34.2 feet (record 35.7 ft.)
(face overgrown.)

5" Pine BT, bearing East, 33.0 feet, Now Gone.

Monument Detail

Sketch

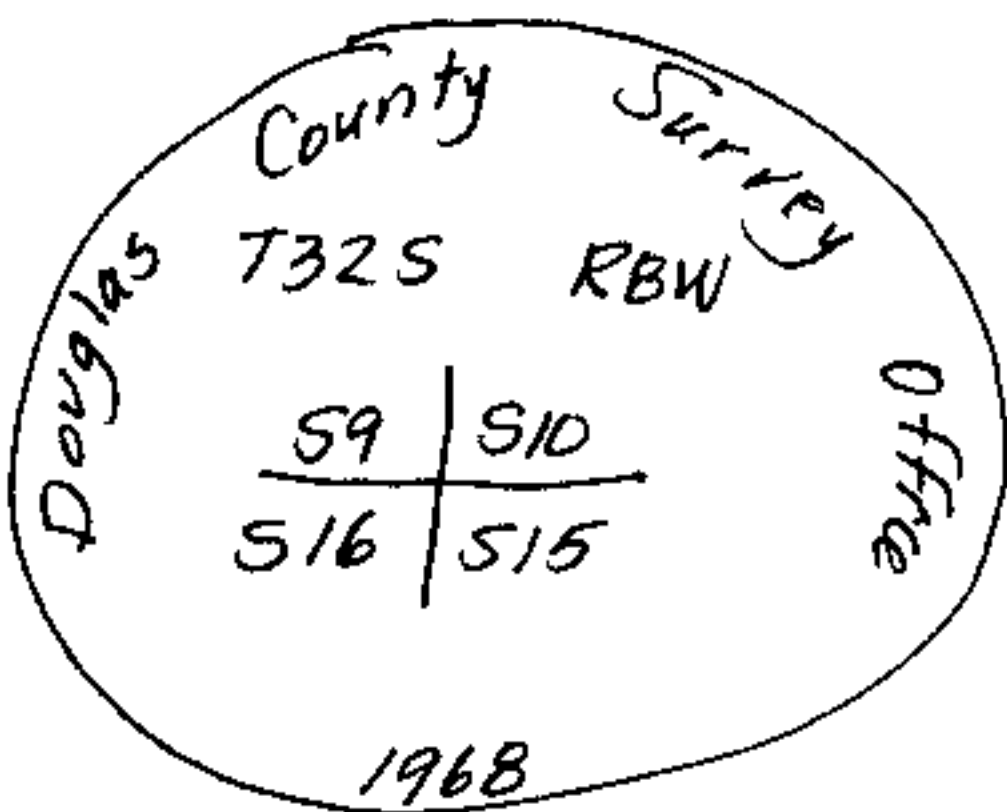

Monument Set (Procedures and Description)

None.

New Accessories

6" D. Fir BT, I scribed "515 T32S RBW BT"
bears S51°E, 11.4 feet.

Location & Comments

Corner lies 500 feet Compass Declination 20°E
above & westerly of Firm/Agency Shaner
U.S. B.L.M. Road Engineering, Inc.
No. 32-8-15, Address P.O. Box 1430
at timber corner. Roseburg, Oregon 97470

Party Chief Shaner

Notes "

Witness Jack Wright

Surveyor's Seal

REGISTERED
PROFESSIONAL
LAND SURVEYOR

Bruce A Shaner

OREGON
OCT. 4, 1957
BRUCE A. SHANER
430

Expires Dec. 31, '94

C.S. File No. 63/154 ①