

NARRATIVE

THE PURPOSE OF THIS SURVEY WAS TO MONUMENT THE PROPERTY LINES (BLAZED, PAINTED & POSTED) FOR SWANSON SUPERIOR FOREST PRODUCTS AND SENECA JONES TIMBER CO.



ALL CORNERS SET IN THIS SURVEY WERE SET IN ACCORDANCE WITH THE BLM MANUAL OF SURVEYING INSTRUCTIONS 1973 SURVEYING INSTRUCTIONS 1973. A BOUNDARY LINE AGREEMENT TO THE FENCE IN WEST 1/2 OF SECTION 4 AND IN NE 1/4 OF SECTION 3 WAS MADE WITH THE ADJACENT LAND OWNERS.

BASIS OF BEARING FOR THIS SURVEY IS FROM A SOLAR OBSERVATION TAKEN IN THE NW CORNER OF SECTION 35.

THIS SURVEY WAS PERFORMED USING A NIKON A20LG DTM TOTAL STATION TO MEASURE ANGLES AND DISTANCES BEARING TREES REFERENCED ON THIS SURVEY WERE MEASURED WITH A 50' DIAMETER TAPE TO THE SIDE CENTER OF THE TREE AND HAND COMPASS TO THE CENTER.

SURVEY FOR
SWANSON SUPERIOR FOREST PRODUCTS
SECTION 34, TOWNSHIP 24 SOUTH, RANGE 4 WEST, W.M..
SECTIONS 3 AND 4, TOWNSHIP 25 SOUTH, RANGE 4 WEST, W.M..
DOUGLAS COUNTY, OREGON
DECEMBER 15, 1995

DOUGLAS COUNTY SURVEYOR

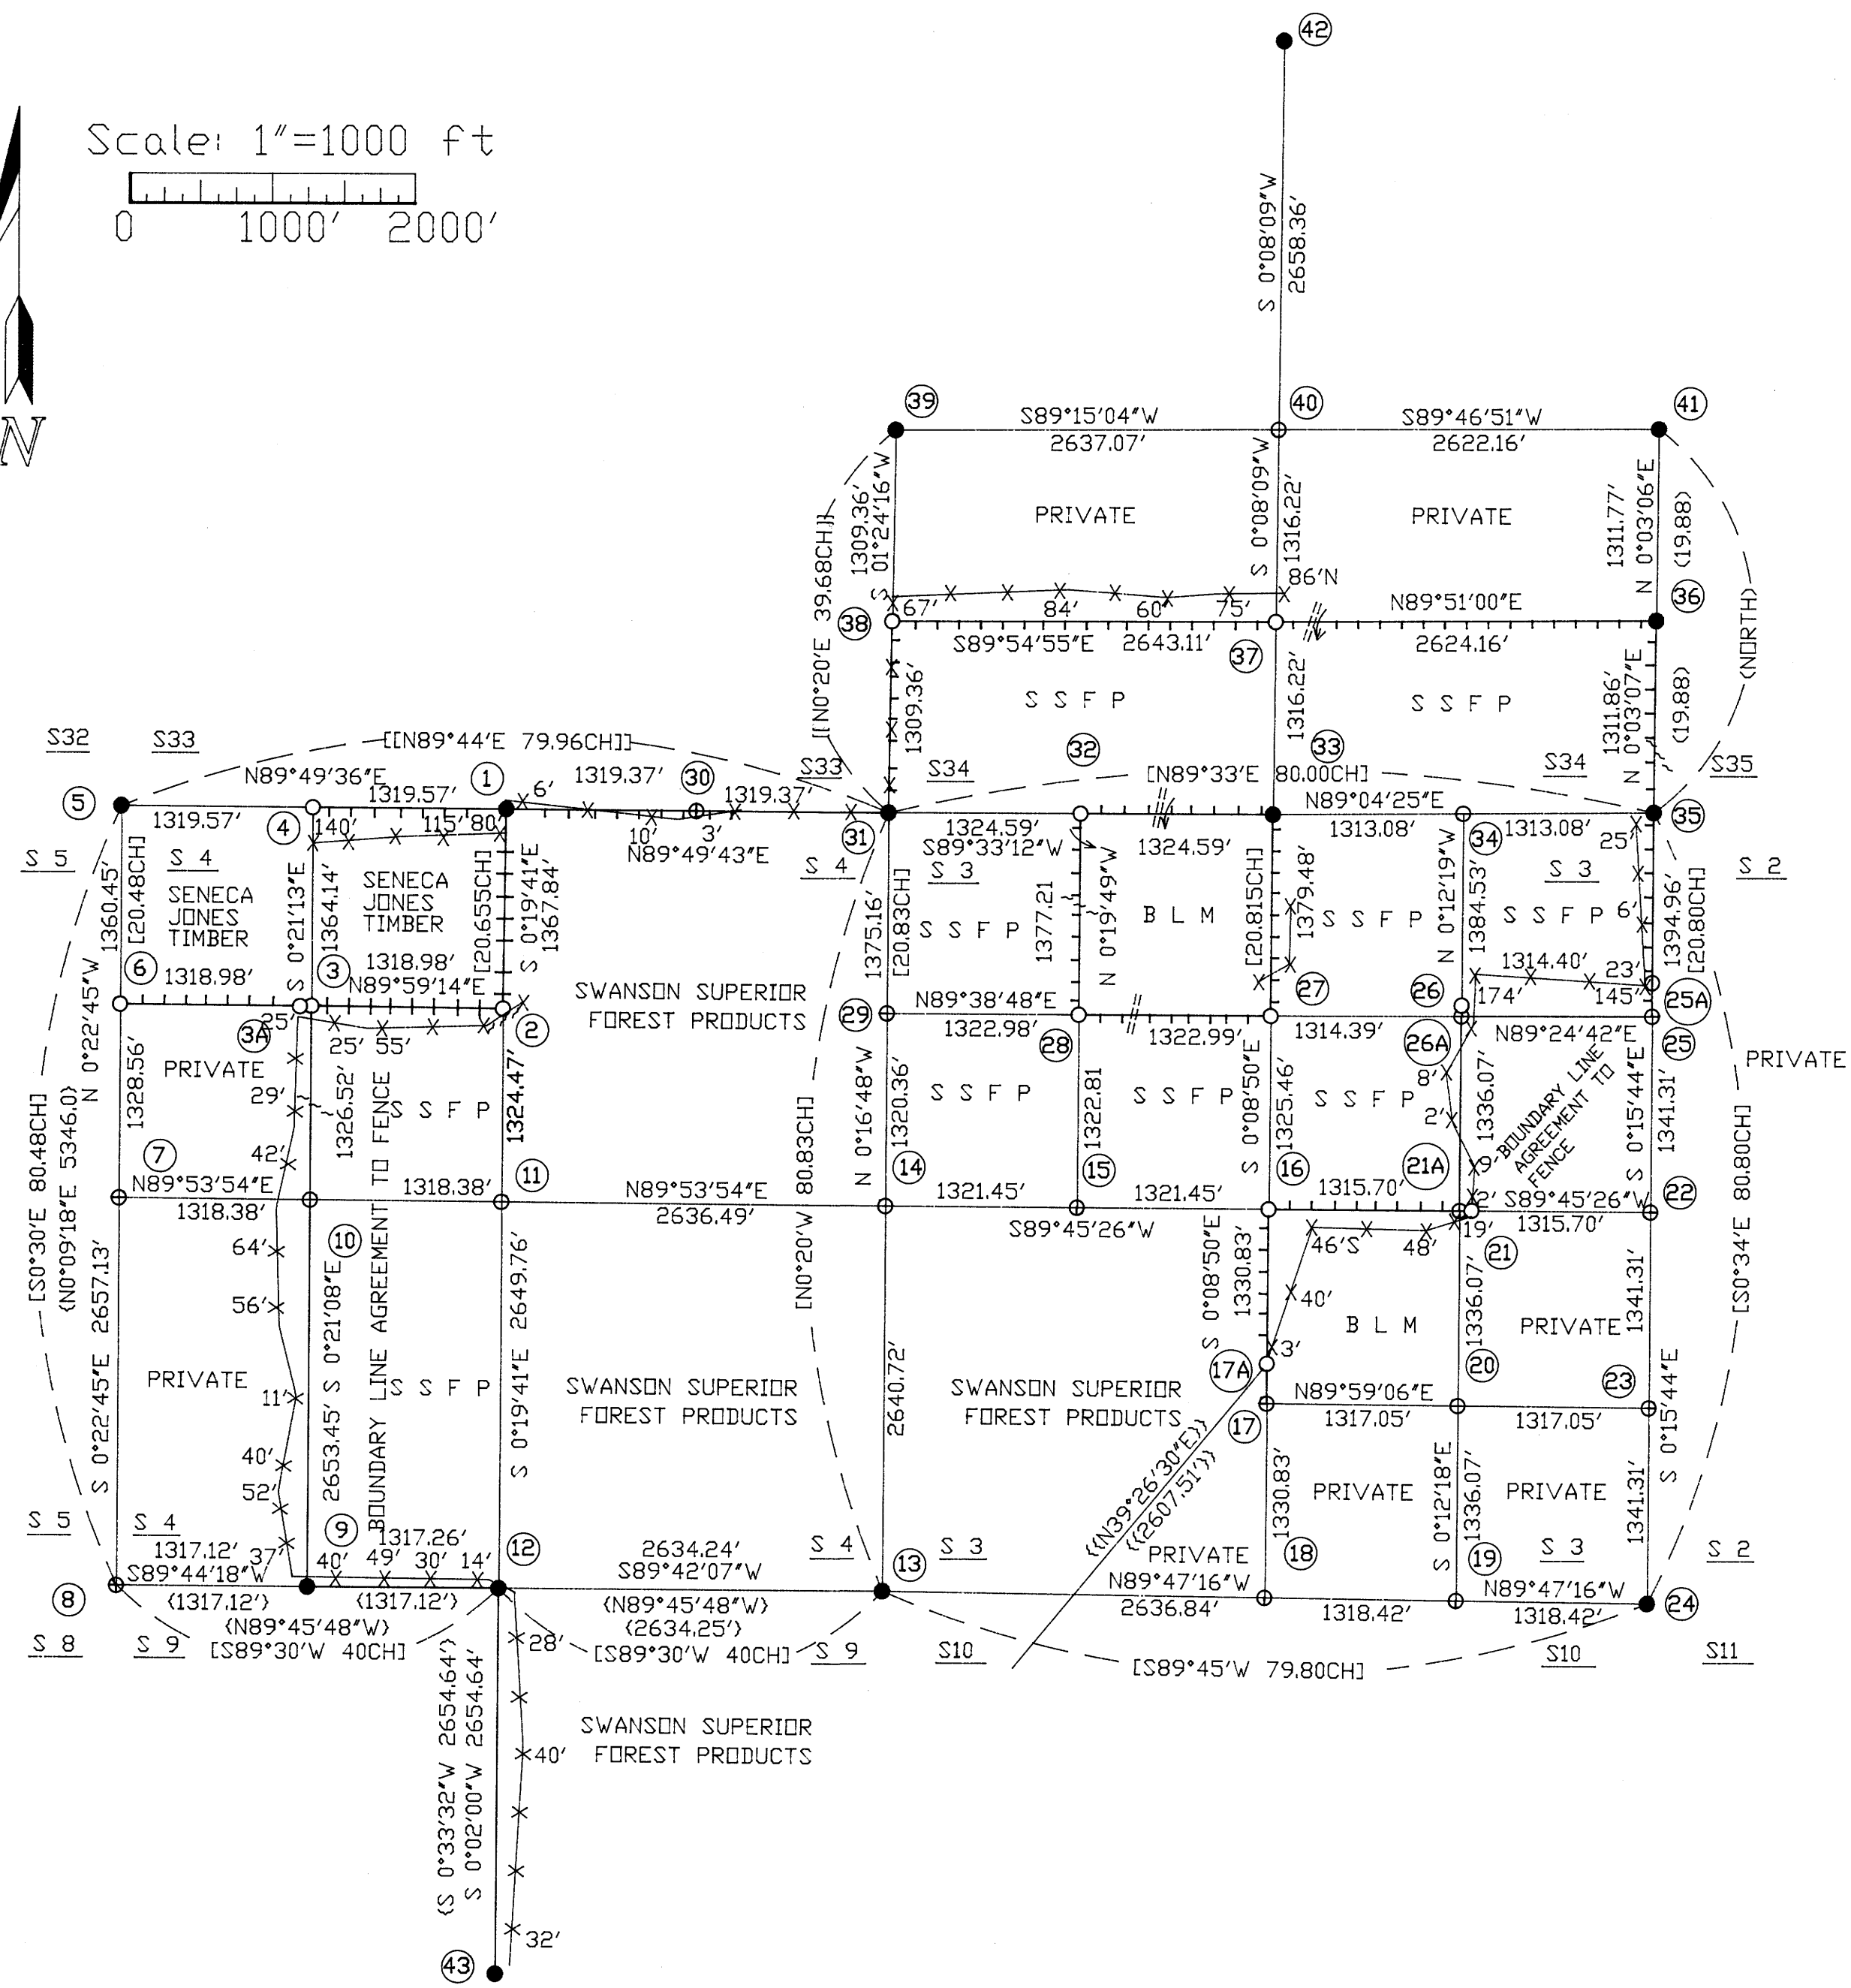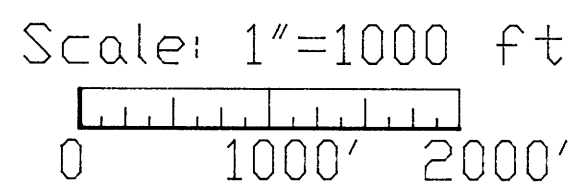

- LEGEND
- = SET 5/8" x 30" REBAR /W YPC 'LS 2603'
 - = CORNERS FOUND AS NOTED
 - ⊙ = CORNER POSITION ONLY, NO MONUMENT SET.
 - = PROPERTY BOUNDARY BLAZES
RED /W RED RIBBON AND FENCE POSTS
 - X-X = FENCE LINES (NTS)
 - === = ROADS
 - = RIDGES
 - ~ ~ ~ = CREEKS
 - D C S D = DOUGLAS COUNTY SURVEY OFFICE
 - P C = PROPERTY CORNER

REFERENCE MEASUREMENTS OF RECORD AS NOTED

- [] = 1856 GLO SURVEY
- () = BLM GROUP # 1233
- < > = M115-62
- << >> = M48-11
- [[]] = BLM GROUP # 1178

REGISTERED
PROFESSIONAL
LAND SURVEYOR

Harvey M. Christensen
OREGON
MARCH 16, 1993
HARVEY M. CHRISTENSEN
2603








LICENSE RENEWAL DATE DECEMBER 31, 1997





NORTHWEST TIMBERLAND CONSULTING, INC.
4680 BRIARS - EUGENE, OR 97404-1113
PHONE (541) 461-4076

CORNER NOTES




- (1) 1/4 CORNER SECTION 33/4 FOUND: 1979 B L M 3" B.C. BTS: 18" D. FIR S52°E, 26.5 FT. HEALED FACE BTS: 26" D. FIR N21°E, 4.1 FT. (2) CN 1/16 SECTION 4 SET: 5/8" X 30" RE-BAR W/YPC "L.S. 2603" 4" ABOVE GROUND BTS: 17" D. FIR S09°E, 6.2 FT. BLAZED & SCRIBED "CN 1/16 S4 BT" 20" D. FIR N63°W, 31.7 FT. (3) NW 1/16 SECTION 4 SET: 5/8" X 30" REBAR W/YPC "L.S. 2603" 4" ABOVE GROUND. BTS: 24" D. FIR S01°W, 36.8 FT. BLAZED & SCRIBED "NW 1/16 S4 BT" 9" D. FIR N81°E, 48.5 FT. SET 5' FIBERGLASS POST 1 FT. EAST (3A) P C 0.01 SDUTH, 26.67 WEST OF NW 1/16 SECTION 4 @ FENCE INTERSECTION SET: 5/8" X 30" RE-BAR W/YPC "L.S. 2603" 4" ABOVE GROUND BTS: 9" D. FIR S81°E, 54.9 FT. BLAZED & SCRIBED "PC BT" SET 5' STEEL POST 1 FT. SOUTH (4) W 1/16 SECTION 33/4 SET: 5/8" X 30" REBAR W/YPC "L.S. 2603" 4" ABOVE GROUND. BTS: 15" D. FIR N24°W, 49.8 FT. BLAZED & SCRIBED "W 1/16 S3 BT" 18" D. FIR S76°E, 27.1 FT. SET 5' FIBERGLASS POST 1 FT. EAST (5) SECTION CORNER 32-33/5-4 FOUND: 1963 D C S D 2.5" B.C. /W 1" AXLE ALONG SIDE BTS: AS PER CS M115-62 (1992) (6) N 1/16 SECTION 5-4 SET: 5/8" X 30" REBAR W/YPC "L.S. 2603" 4" ABOVE GROUND. BTS: 20" D. FIR N57°E, 16.8 FT. BLAZED & SCRIBED "N 1/16 S4 BT" 20" D. FIR S50°W, 6.6 FT. SET 5' STEEL POST 1 FT. EAST (7) 1/4 CORNER SECTION 5-4 CALCULATED POSITION ONLY, NO MONUMENT SET (8) SECTION CORNER 5-4/8-9 CALCULATED POSITION ONLY, NO MONUMENT SET (9) W 1/16 SECTION 4/9 FOUND: 1992 PLS 752 2 1/2" B.C. BTS: 21" D. FIR N55°W 27.8 FT. SCRIBING VISIBLE 21" D. FIR S44°W 44.6 FT. SCRIBING VISIBLE (10) CW 1/16 SECTION 4 CALCULATED POSITION ONLY, NO MONUMENT SET (11) C 1/4 SECTION 4 CALCULATED POSITION ONLY, NO MONUMENT SET (12) 1/4 CORNER SECTION 4/9 BTS: AS PER CS M115-62 (1992) (13) SECTION CORNER 4-3/9-10 FOUND: 1957 BLM 3" B.C. W/1" D.D. & 3/4" I.D. I. PIPE BTS: 29" I. CEDAR STUMP S31°E, 180.8 FT. HEALED FACE 16" D. FIR STUMP S59°W, 36.3 FT. HEALED FACE 24" D. FIR STUMP N81°E, 39.8 FT. HEALED FACE 21" D. FIR STUMP N09°W, 36.1 FT. HEALED FACE (14) 1/4 SECTION 4-3 CALCULATED POSITION ONLY, NO MONUMENT SET (15) CW 1/16 SECTION 3 CALCULATED POSITION ONLY, NO MONUMENT SET (16) C 1/4 SECTION 3 SET: 5/8" X 30" REBAR W/YPC "L.S. 2603" 4" ABOVE GROUND. BTS: 13" D. FIR N33°E, 39.0 FT. BLAZED & SCRIBED "C 1/4 S3 BT" 11" D. FIR S62°E, 33.8 FT. BLAZED & SCRIBED "C 1/4 S3 BT" 13" D. FIR S47°W, 21.8 FT. BLAZED & SCRIBED "C 1/4 S3 BT" 11" D. FIR N56°W, 32.1 FT. BLAZED & SCRIBED "C 1/4 S3 BT" SET 5' STEEL POST 1 FT. SOUTH (17) CS 1/16 SECTION 3 CALCULATED POSITION ONLY, NO MONUMENT SET FOUND: 5/8" REBAR CS M48-11 17.38' NORTH, 7.39' EAST @ FENCE CORNER (17A) PC 257.1' NORTH, 0.68' WEST OF CS 1/16 CORNER SECTION 3 SET: 5/8" X 30" REBAR W/YPC "L.S. 2603" 4" ABOVE GROUND. BTS: 39" D. FIR N78°E 21.2 FT. BLAZED & SCRIBED "PC BT" 22" CEDAR S19°E, 15.0 FT. SET 5' STEEL POST 1 FT. NORTH FOUND: 5/8" REBAR CS M48-11 10.51' NORTH, 8.54' EAST @ FENCE CORNER (18) 1/4 SECTION 3/10 CALCULATED POSITION ONLY, NO MONUMENT SET (19) E 1/16 SECTION 3/10 CALCULATED POSITION ONLY, NO MONUMENT SET (20) SE 1/16 SECTION 3 CALCULATED POSITION ONLY, NO MONUMENT SET (21) CE 1/16 SECTION 3 CALCULATED POSITION ONLY, NO MONUMENT SET

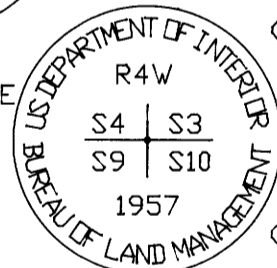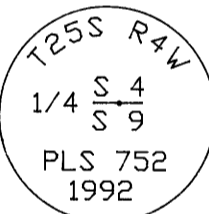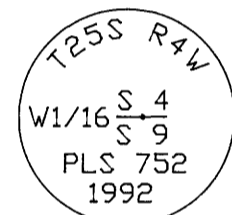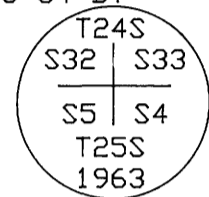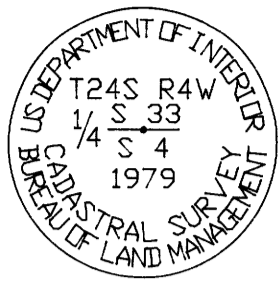

- (21A) PC 9.78' NORTH, 0.00' EAST OF CE 1/16 CORNER SECTION 3 BTS: 9" D. FIR S79°W 24.1 FT. BLAZED & SCRIBED "PC BT" 30" D. FIR S14°W 34.4 FT. SET 5' STEEL POST 1 FT. NORTH (22) 1/4 CORNER SECTION 3-2 CALCULATED POSITION ONLY, NO MONUMENT SET (23) S 1/16 SECTION 3-2 CALCULATED POSITION ONLY, NO MONUMENT SET (24) SECTION CORNER 3-2/10-11 FOUND: 1957 GLO 3" B.C. 14" BELOW GROUND BTS: 17" W. OAK S82°W, 198.2 FT. HEALED FACE /W TAG 54" D. FIR N57°W, 107.2 FT. BARK SCRIBING VISIBLE /W TAG 39" D. FIR STUMP N9°E, 143.3 FT. NO VISIBLE MARKS 13" W. OAK N20°E, 213.4 FT. HEALED FACE /W TAG 24" W. OAK S71°E, 416.8 FT. HEALED FACE 26" W. OAK S13°W, 557.8 FT. HEALED FACE 14" W. OAK N82°W, 129.4 FT. HEALED FACE (25) N 1/16 SECTION 3-2 CALCULATED POSITION ONLY, NO MONUMENT SET (25A) PC ON SECTION LINE 143.88' NORTH OF N 1/16 CORNER SECTION 3-2 SET: 5/8" X 30" REBAR W/YPC "L.S. 2603" 4" ABOVE GROUND. BTS: 14" W. OAK S86°E, 66.4 FT. BLAZED & SCRIBED "PC BT" 42" D. FIR S85°E, 9.00 CHAINS(RECORD) ORIGINAL-BURNED STUMP SET 5' STEEL POST 1 FT. NORTH (26) NE 1/16 SECTION 3 CALCULATED POSITION ONLY, NO MONUMENT SET (26A) PC 4.05' NORTH, 0.06' EAST OF NE 1/16 CORNER SECTION 3 SET: 5/8" X 30" REBAR W/YPC "L.S. 2603" 4" ABOVE GROUND. BTS: 8" D. FIR N57°W, 0.7 FT. BLAZED & SCRIBED "PC BT" 17" D. FIR S30°E, 25.6 FT. BLAZED & SCRIBED "PC BT" SET 5' STEEL POST 1 FT. NORTH (27) CN 1/16 SECTION 3 SET: 5/8" X 30" RE-BAR W/YPC "L.S. 2603" 4" ABOVE GROUND BTS: 14" D. FIR N76°W 13.0 FT. BLAZED & SCRIBED "CN 1/16 S3 BT" 14" D. FIR S33°E 7.8 FT. SET 5 1/2' STEEL POST 1 FT. SOUTH (28) NW 1/16 SECTION 3 SET: 5/8" X 30" REBAR W/YPC "L.S. 2603" 4" ABOVE GROUND. BTS: 10" D. FIR N55°E 48.9 FT. BLAZED & SCRIBED "NW 1/16 S3 BT" 13" D. FIR S29°W, 1.9 FT. SET 5' STEEL POST 1 FT. NORTH (29) N 1/16 SECTION 4-3 CALCULATED POSITION ONLY, NO MONUMENT SET (30) E 1/16 SECTION 33/4 CALCULATED POSITION ONLY, NO MONUMENT SET (31) SECTION CORNER 33-34/4-3 FOUND: 1961 D C S D 2.5" B.C. BTS: NOTE NO BTS TIED (32) W 1/16 SECTION 34/3 SET: 5/8" X 30" REBAR W/YPC "L.S. 2603" 4" ABOVE GROUND. BTS: 10" D. FIR S62°E, 30.1 FT. BLAZED & SCRIBED "W1/16 S3 BT" 10" D. FIR S34°W, 11.9 FT. SET 5' STEEL POST 1 FT. SOUTH (33) 1/4 CORNER SECTION 34/3 FOUND: 1961 D C S D 2.5" B.C. BTS: 19" D. FIR S40°W, 4.3 FT. HEALED FACE W/TAG 27" D. FIR N43°E, 3.4 FT. HEALED FACE W/TAG 44" D. FIR S11°E, 168.9 FT. HEALED FACE W/TAG (34) E 1/16 SECTION 34/3 CALCULATED POSITION ONLY, NO MONUMENT SET. (35) SECTION CORNER 34-35/3-2 FOUND: 1963 DOUGLAS COUNTY 2 1/2" B.C. BTS: 43" I. CEDAR N51°W, 30.5 FT. HEALED FACE W/TAG 20" W. OAK S48°E, 63.8 FT. HEALED FACE W/TAG 33" D. FIR S76°W, 65.4 FT. HEALED FACE W/TAG 22" W. OAK S8.5°E, 436.0.8 FT. OPEN FACE, SCRIBING VISIBLE /W TAG 21" W. OAK S13°W, 199.1 FT. 27" W. OAK "N02°E 282.0 FT. "

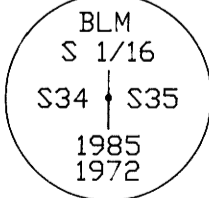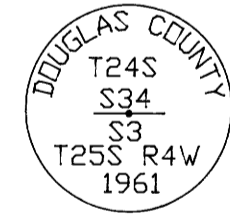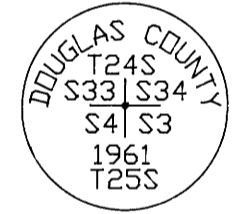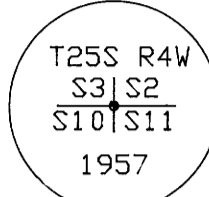

- (38) S 1/16 SECTION 33-34 SET: 5/8" X 30" REBAR W/YPC 4" ABOVE GROUND BTS: 40" D. FIR S32°W, 20.6 FT. BLAZED & SCRIBED "S 1/16 S38 BT" 22" D. FIR N87°E, 9.3 FT. BLAZED & SCRIBED "S 1/16 S34 BT" SET 5 1/2' STEEL POST 1 FT. EAST (39) 1/4 CORNER SECTION 33-34 FOUND: 1963 D C S D 2.5" B.C. BTS: 30" D. FIR STUMP S26°E, 26.0 FT. HEALED FACE W/TAG 28" D. FIR STUMP S29°W, 38.4 FT. W/TAG (40) C 1/4 CORNER SECTION 34 SET: 5/8" X 30" REBAR W/YPC "L.S. 2603" 4" ABOVE GROUND. BTS: 11" D. FIR S75°W, 60.3 FT. BLAZED & SCRIBED "C1/4 S34 BT" 8" D. FIR N41°W, 67.3 FT. 9" D. FIR N19°E, 89.4 FT. 9" D. FIR S23°E, 60.7 FT. SET 5' STEEL POST 1 FT. SOUTH (41) 1/4 CORNER SECTION 34-35 FOUND: 1972 1985 U.S. DEPT. OF THE INTERIOR BLM 3 1/4" B.C. BTS: 32" D. FIR STUMP N76°W 33.7 FT. NO VISIBLE SCRIBING 16" ASH N61°E 43.2 FT. SCRIBING VISIBLE 5" D. FIR S38°E 42.2 FT. 13" MAPLE N53.25°W 100.4 FT. 7" X S5°E 66.3 FT. CHISLED IN TOP OF NORTH WEST CORNER OF CONCRETE CATTLE GUARD STRUCTURE (42) 1/4 CORNER SECTION 27/34 FOUND: 1963 D C S D 2.5" B.C. BTS: 6" MADRONE S82°W, 21.0 FT. NO VISIBLE SCRIBING 12" D. FIR S35°W, 15.2 FT. HEALED FACE 23" D. FIR N33°E, 21.6 FT. HEALED FACE SET 5 1/2' STEEL POST 1 FT. WEST (43) CENTER 1/4 CORNER SECTION 9 FOUND: 2.0' PIPE DISTURBED (BENT) W/O B C BTS: NOT TIED

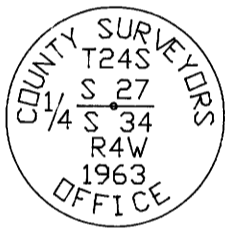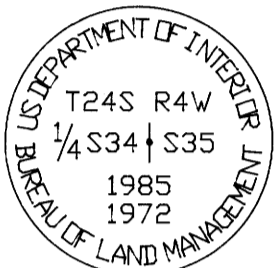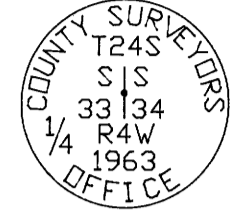

SURVEY FOR SWANSON SUPERIOR FOREST PRODUCTS SECTION 34, TOWNSHIP 24 SOUTH, RANGE 4 WEST, W.M.. SECTIONS 3 AND 4, TOWNSHIP 25 SOUTH, RANGE 4 WEST, W.M. DOUGLAS COUNTY, OREGON DECEMBER 15, 1995

REGISTERED PROFESSIONAL LAND SURVEYOR

Harvey M. Christensen

OREGON MARCH 16, 1993 HARVEY M. CHRISTENSEN 2603



LICENSE RENEWAL DATE DECEMBER 31, 1997

NORTHWEST TIMBERLAND CONSULTING, INC. 4680 BRIARS - EUGENE, OR 97404-1113 PHONE (503) 461-4076