


MAP FILE M169-31

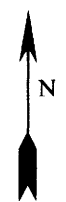


RECORD OF SURVEY
FOR: ROME CREEK TIMBER 1 LLC
SW1/4, SE1/4, SECTION 26, T.23 S., R.8 W., W.M.
DOUGLAS COUNTY, OREGON
9 MARCH 2015

FILED
DATE: 5/15/2015 BY: JC
THIS SURVEY CONSISTS OF:
MAP: M169-31
NARRATIVE:
CORNER RPT:
DOUGLAS COUNTY
SURVEYOR

SECTION CORNER SECTIONS 26,27,34,35
FOUND ALUMINUM CAP DATED 2015
WITH ACCESSORIES PER CSF M169-7
STEEL POST ADJACENT TO CORNER

1/4 CORNER SECTIONS 26,35
FOUND 1984 BLM BRASS CAP WITH THE FOLLOWING ACCESSORIES:
13" W. FIR BEARS N 79-3/4° E 50.8' - HEALED FACE
15" D. FIR BEARS S 89° W 89.8' - HEALED FACE
NEW BEARING TREES THIS SURVEY
10" D. FIR BEARS S 86° E 20.1' - BLAZED, SCRIBED X BT
12" D. FIR BEAR N 74° W 41.8' - BLAZED, SCRIBED 1/4 S26 BT
STEEL POST ADJACENT TO CORNER

E1/16 CORNER SECTIONS 26,35
FOUND BLM BRASS CAP DATED 1984
WITH ACCESSORIES CSF M169-6
STEEL POST ADJACENT TO CORNER

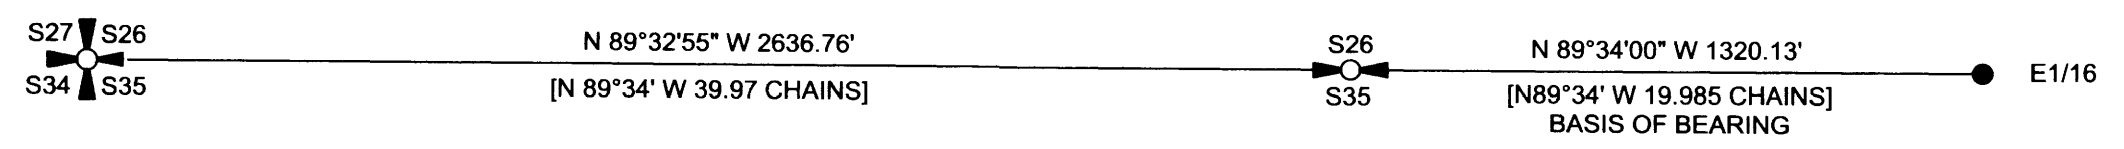

NARRATIVE:

THE PURPOSE OF THIS SURVEY IS TO DOCUMENT THE MARKING OF TRUE LINE BETWEEN EXISTING CORNERS OF SECTION 26, TOWNSHIP 23 SOUTH, RANGE 8 WEST, WILLAMETTE MERIDIAN.

EXISTING CORNERS WERE TIED BY GROUND TRAVERSE FOR CONTROL AND HELD IN THEIR AS TIED POSITIONS FOR THE MARKING OF TRUE LINE.

TRUE LINE WAS MARKED WITH RED PAINTED BLAZES, RED FLAGGING AND 5 -1/2' GALVANIZED STEEL POSTS SET AT AN AVERAGE INTERVAL OF 200'

THE BASIS OF BEARING FOR THIS SURVEY WAS THE 1987 BUREAU OF LAND MANAGEMENT DEPENDENT RESURVEY AND SUBDIVISION OF SECTION 35, TOWNSHIP 23 SOUTH, RANGE 8 WEST, WILLAMETTE MERIDIAN.

THIS SURVEY WAS PERFORMED USING A NIKON TOTAL STATION.

LEGEND

- FOUND 1/4 CORNER AS NOTED
- FOUND SECTION CORNER AS NOTED
- [] BUREAU OF LAND MANAGEMENT 1987 DEPENDENT RESURVEY RECORD DATA
- FOUND 1/16 CORNER AS NOTED
- BLM BUREAU OF LAND MANAGEMENT
- CSF COUNTY SURVEY FILE

REGISTERED PROFESSIONAL LAND SURVEYOR
Ronald L. Rice
OREGON
JULY 9, 2002
RONALD L. RICE
54633LS

EXPIRATION DATE: 12-31-2016

Northwest Land Surveying, Inc.
P. O. Box 2827
FLORENCE, OR 97439 541-997-9201

FILE NAME		
15-35		
SCALE	DATE	DRAWN BY
400 Ft/in	3-9-2015	RLR
JOB	REVISION	SHEET
WAGGONER 26		1/1

This map drawn with TRAVERSE PC Software

MAP FILE M169-31