


THIS MAP WAS PREPARED FOR
ASSESSMENT PURPOSE ONLY.

SECTION 33 T.20S. R. 6 W. W.M.
DOUGLAS COUNTY

20 6 33

1" = 400'

SEE MAP 20 6

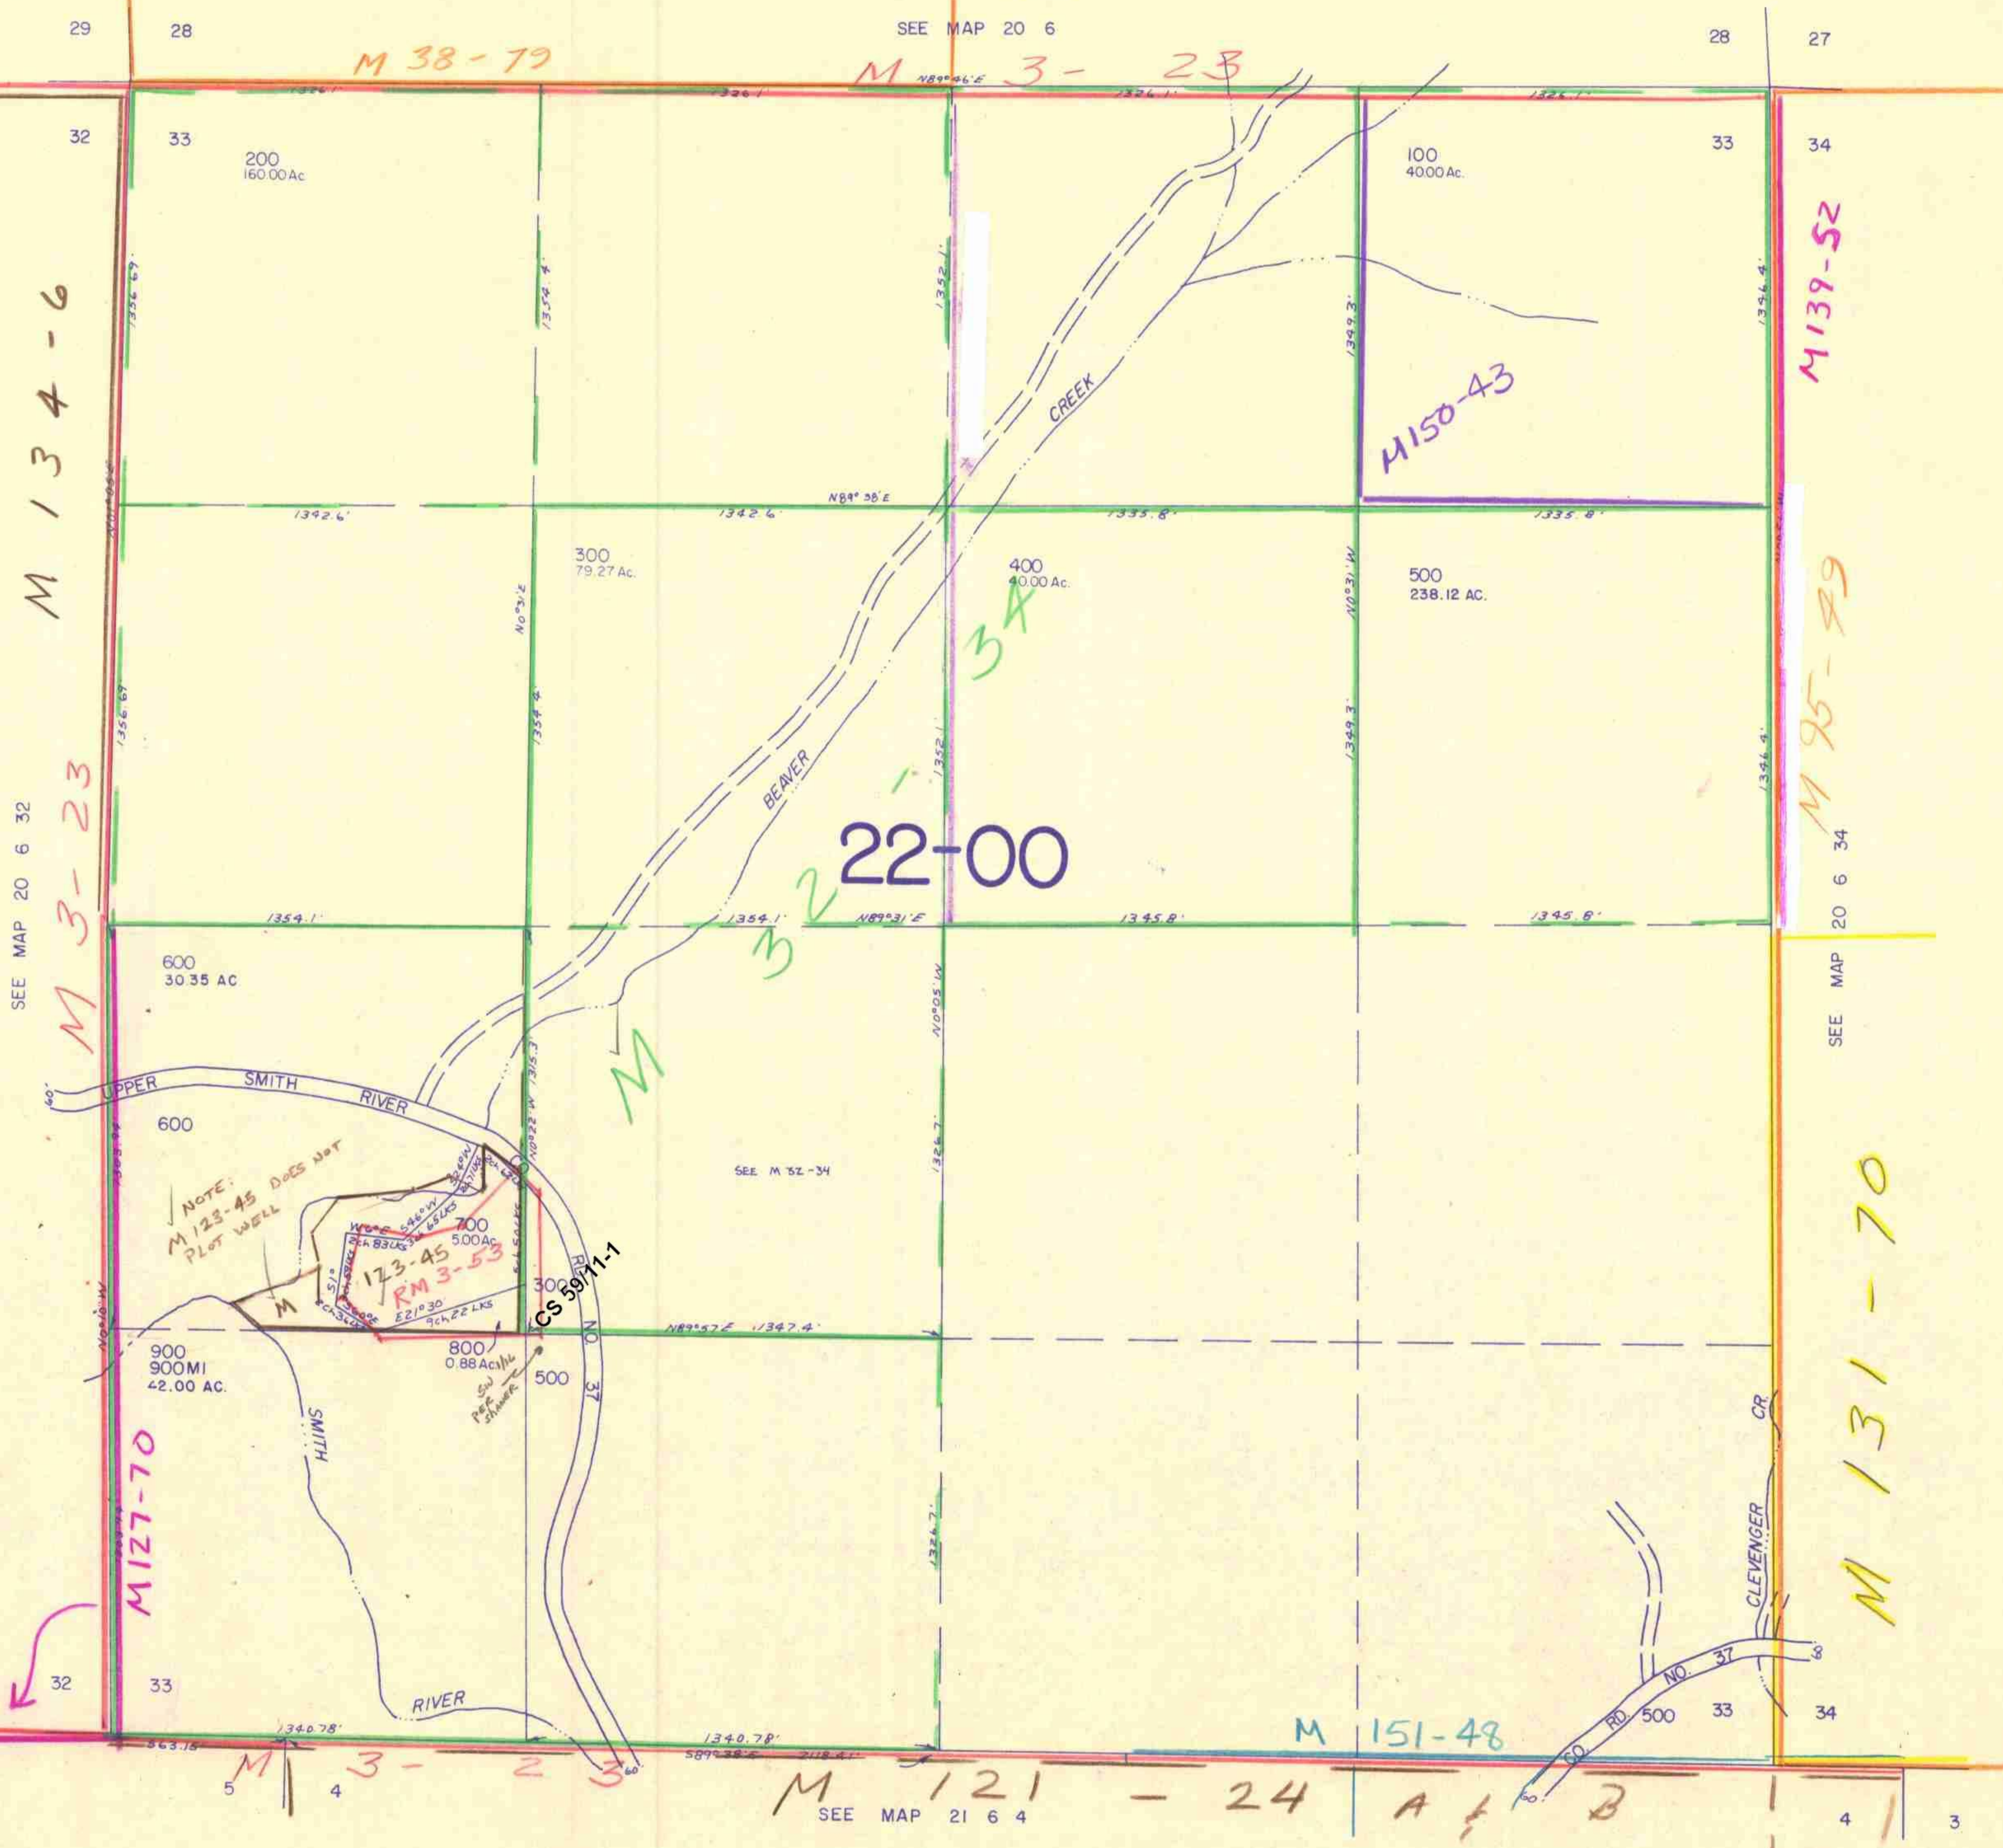

20 6 33

6/23/21