


THIS MAP WAS PREPARED FOR
ASSESSMENT PURPOSE ONLY.

SECTION 34 T.20S. R. 6 W. W.M.
DOUGLAS COUNTY

20 6 34

1" = 400'

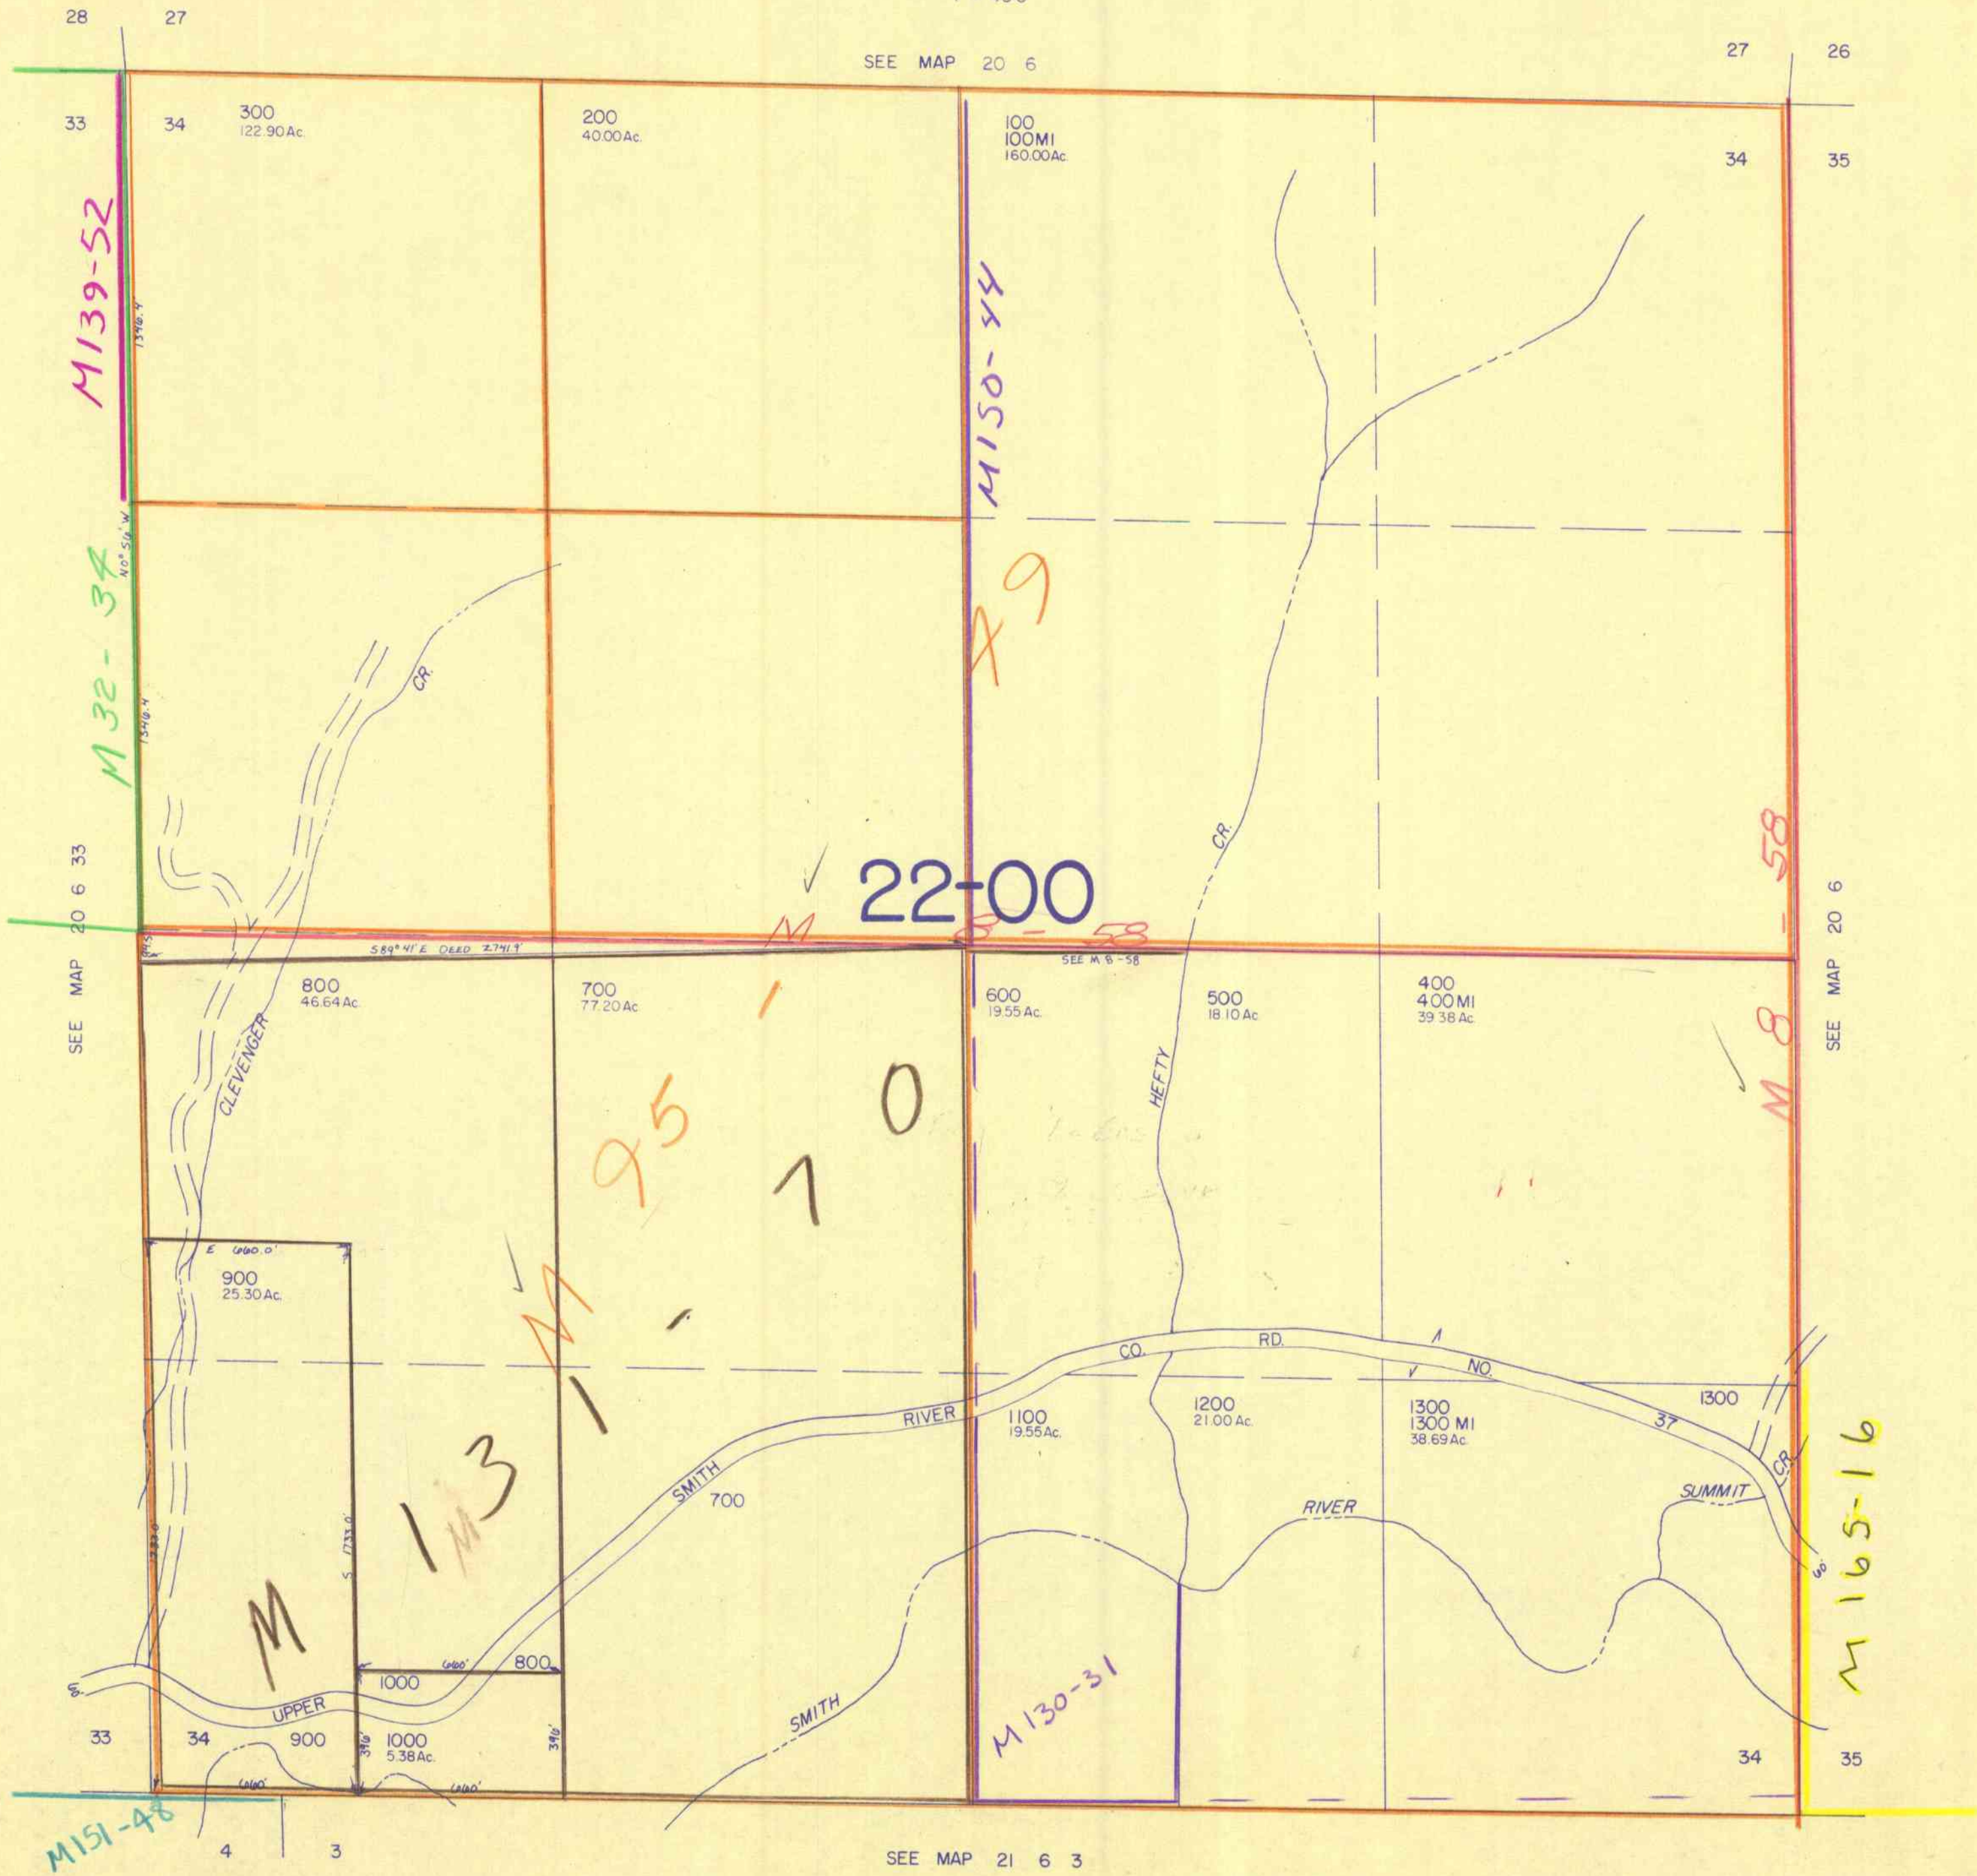

20 6 34

6/83
28