


SECTION 30 T.20S. R.10W. W.M.
DOUGLAS COUNTY

20 10 30

THIS MAP WAS PREPARED FOR
ASSESSMENT PURPOSE ONLY.

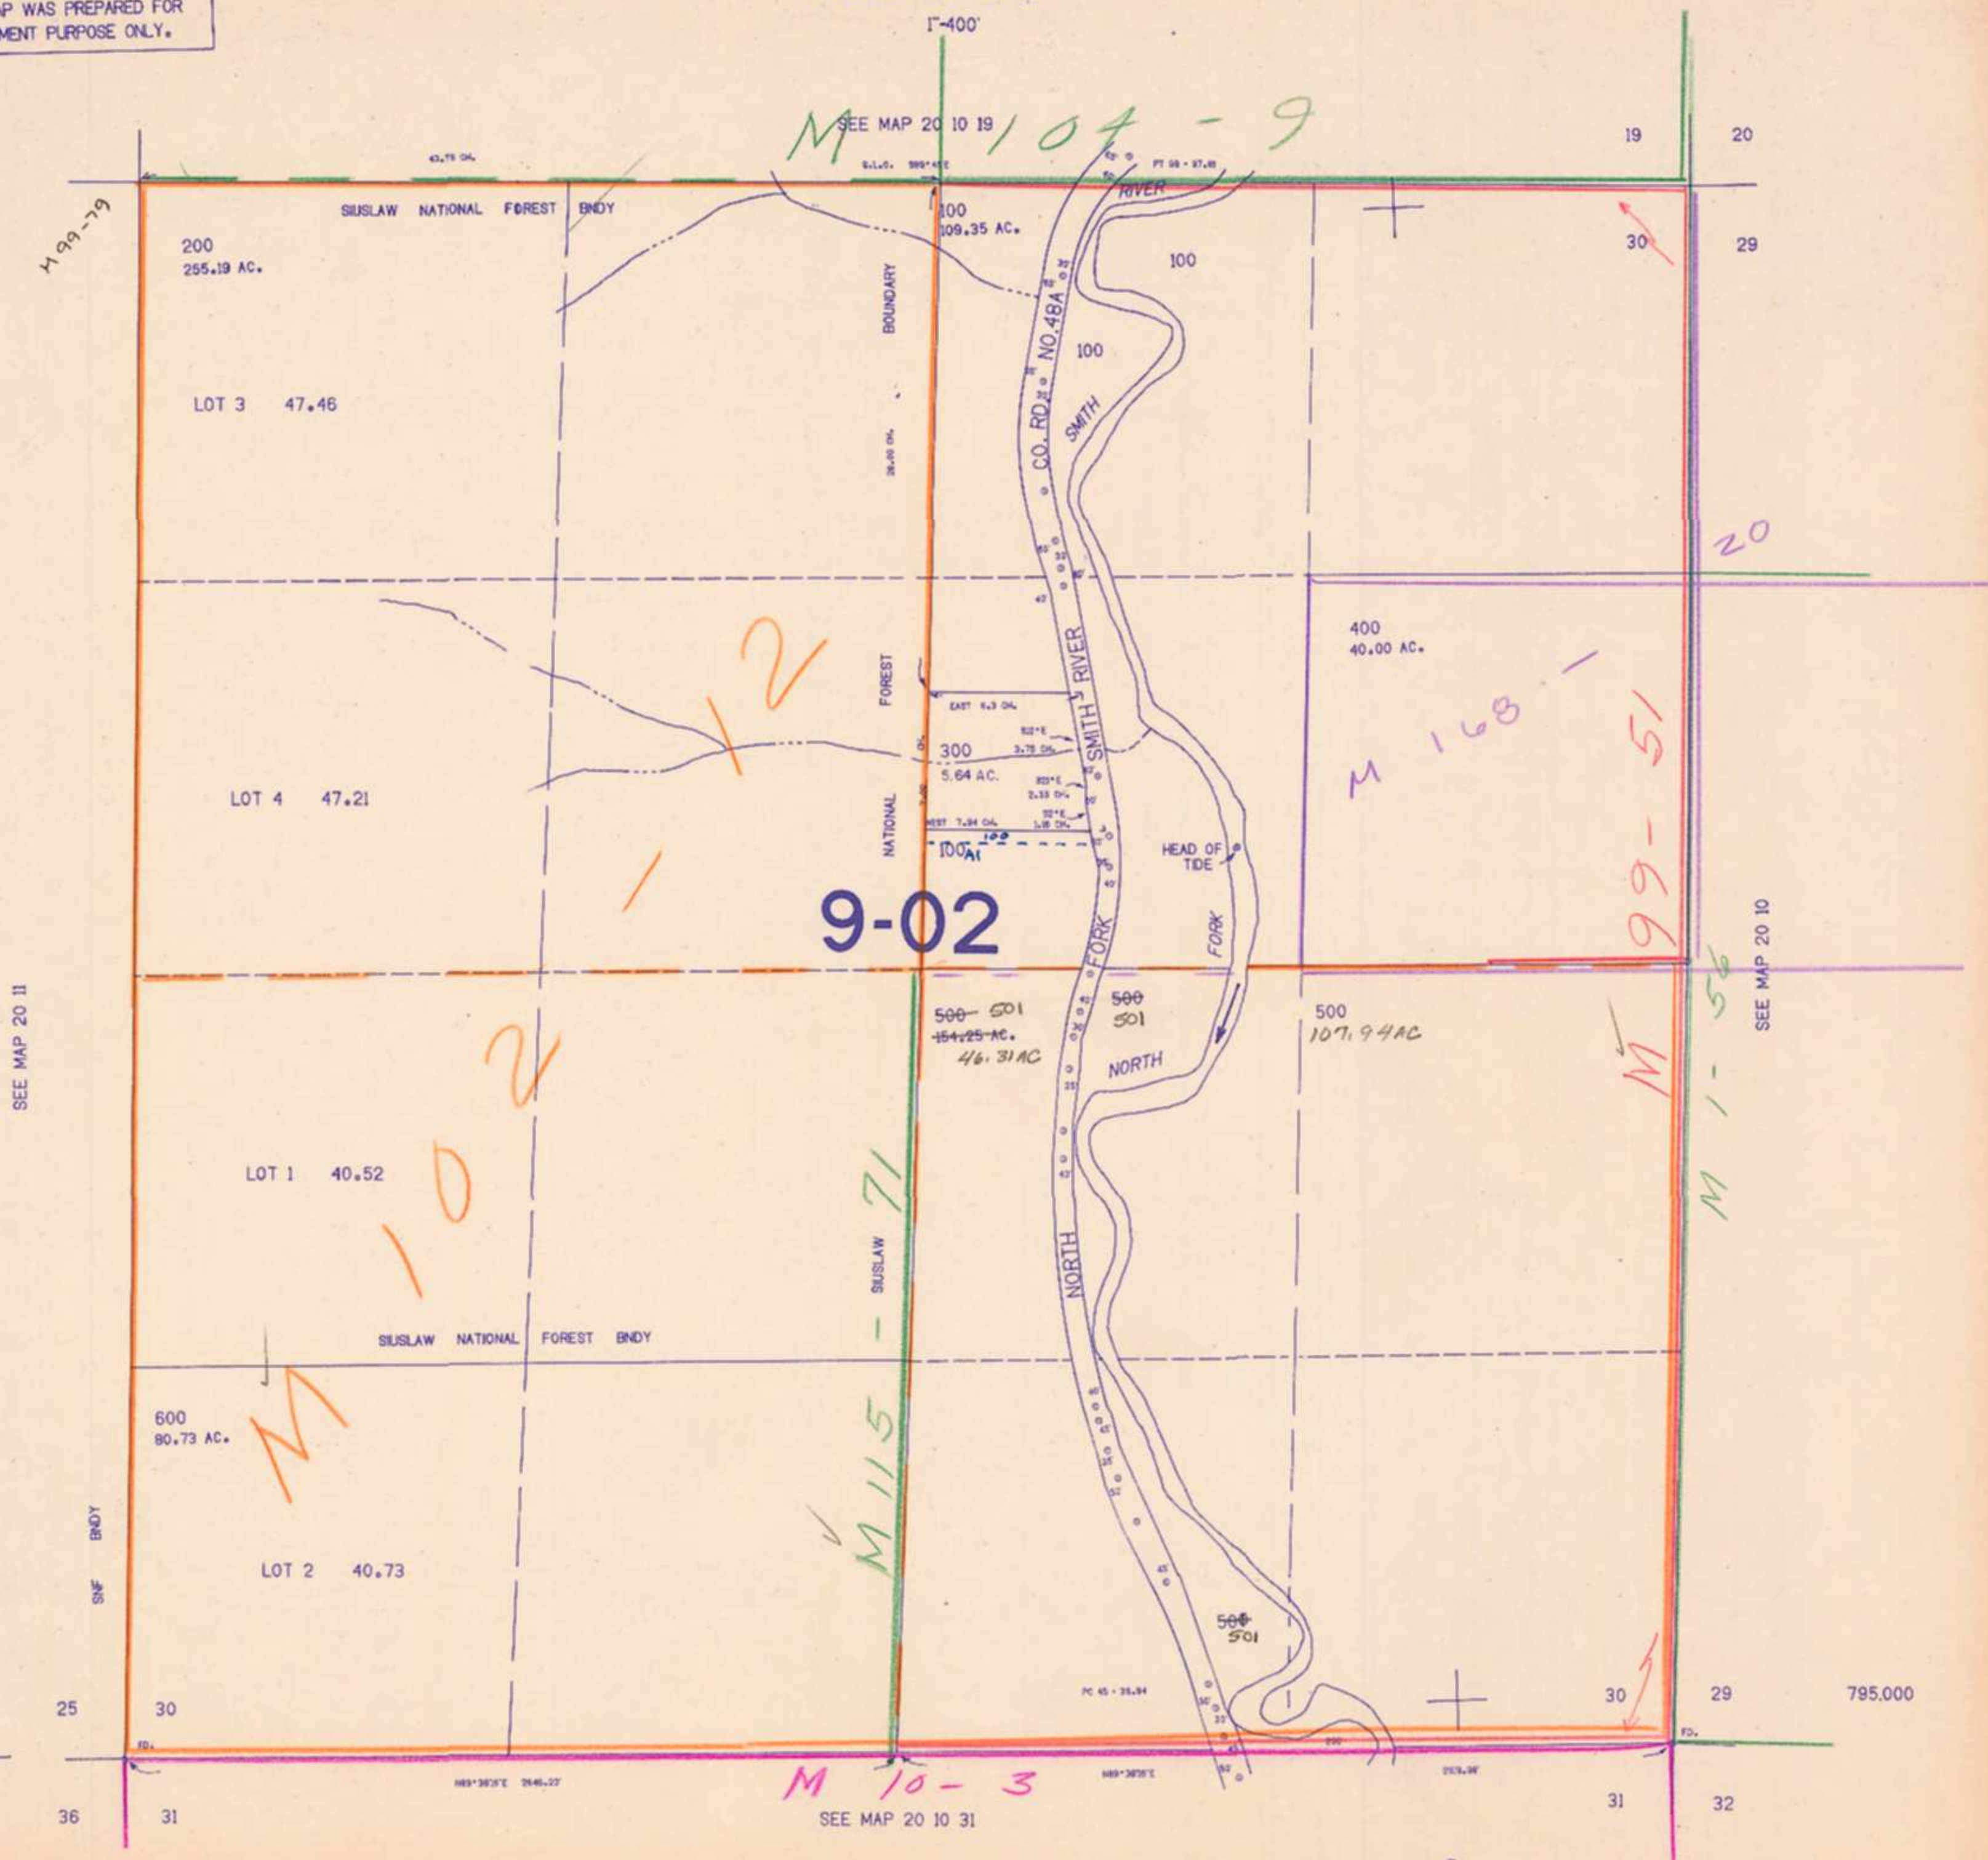

SEE MAP 20 11

SEE MAP 20 10 19

SEE MAP 20 10 31

SEE MAP 20 10

795.000

1:1095,000

20 10 30

3/87