THIS MAP WAS PREPARED FOR ASSESSMENT PURPOSE ONLY.

SECTION 26 T.20S. R.11 W. W.M.
DOUGLAS COUNTY
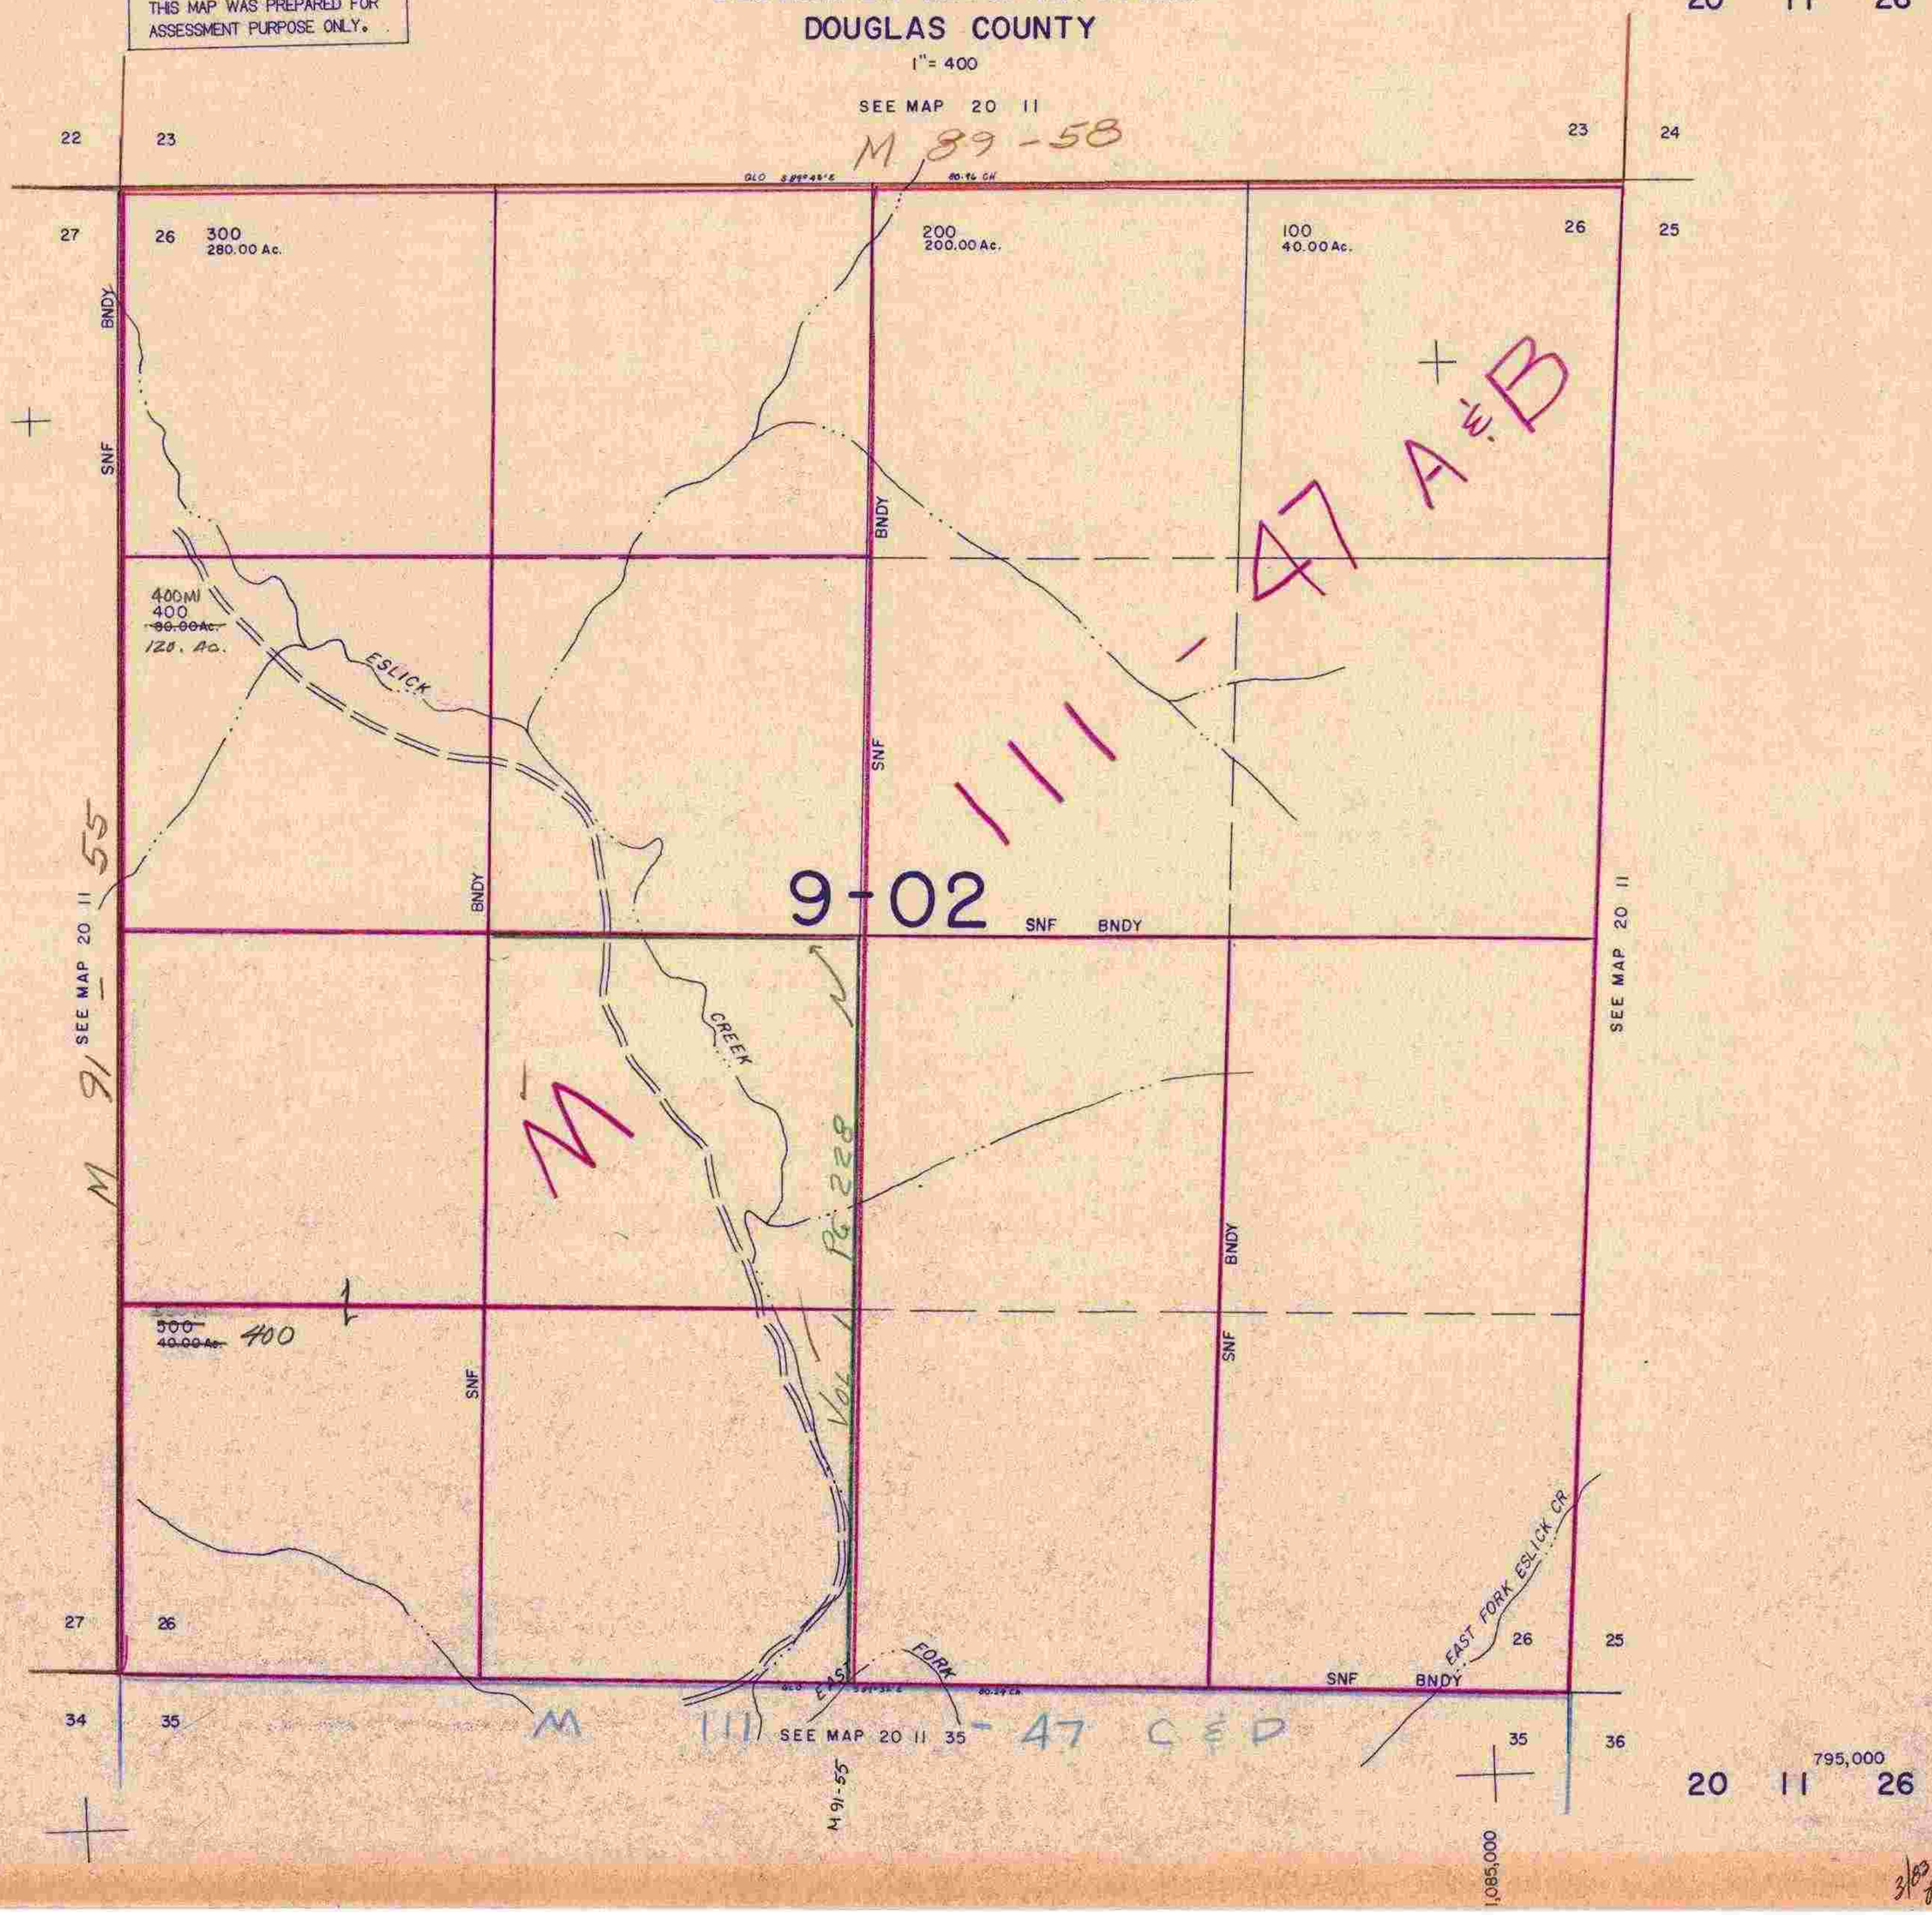
1" = 400