


THIS MAP WAS PREPARED FOR
ASSESSMENT PURPOSE ONLY.

SECTION 3 T.20S. R.12W. WM.
DOUGLAS COUNTY

1" = 400'

20 12 3

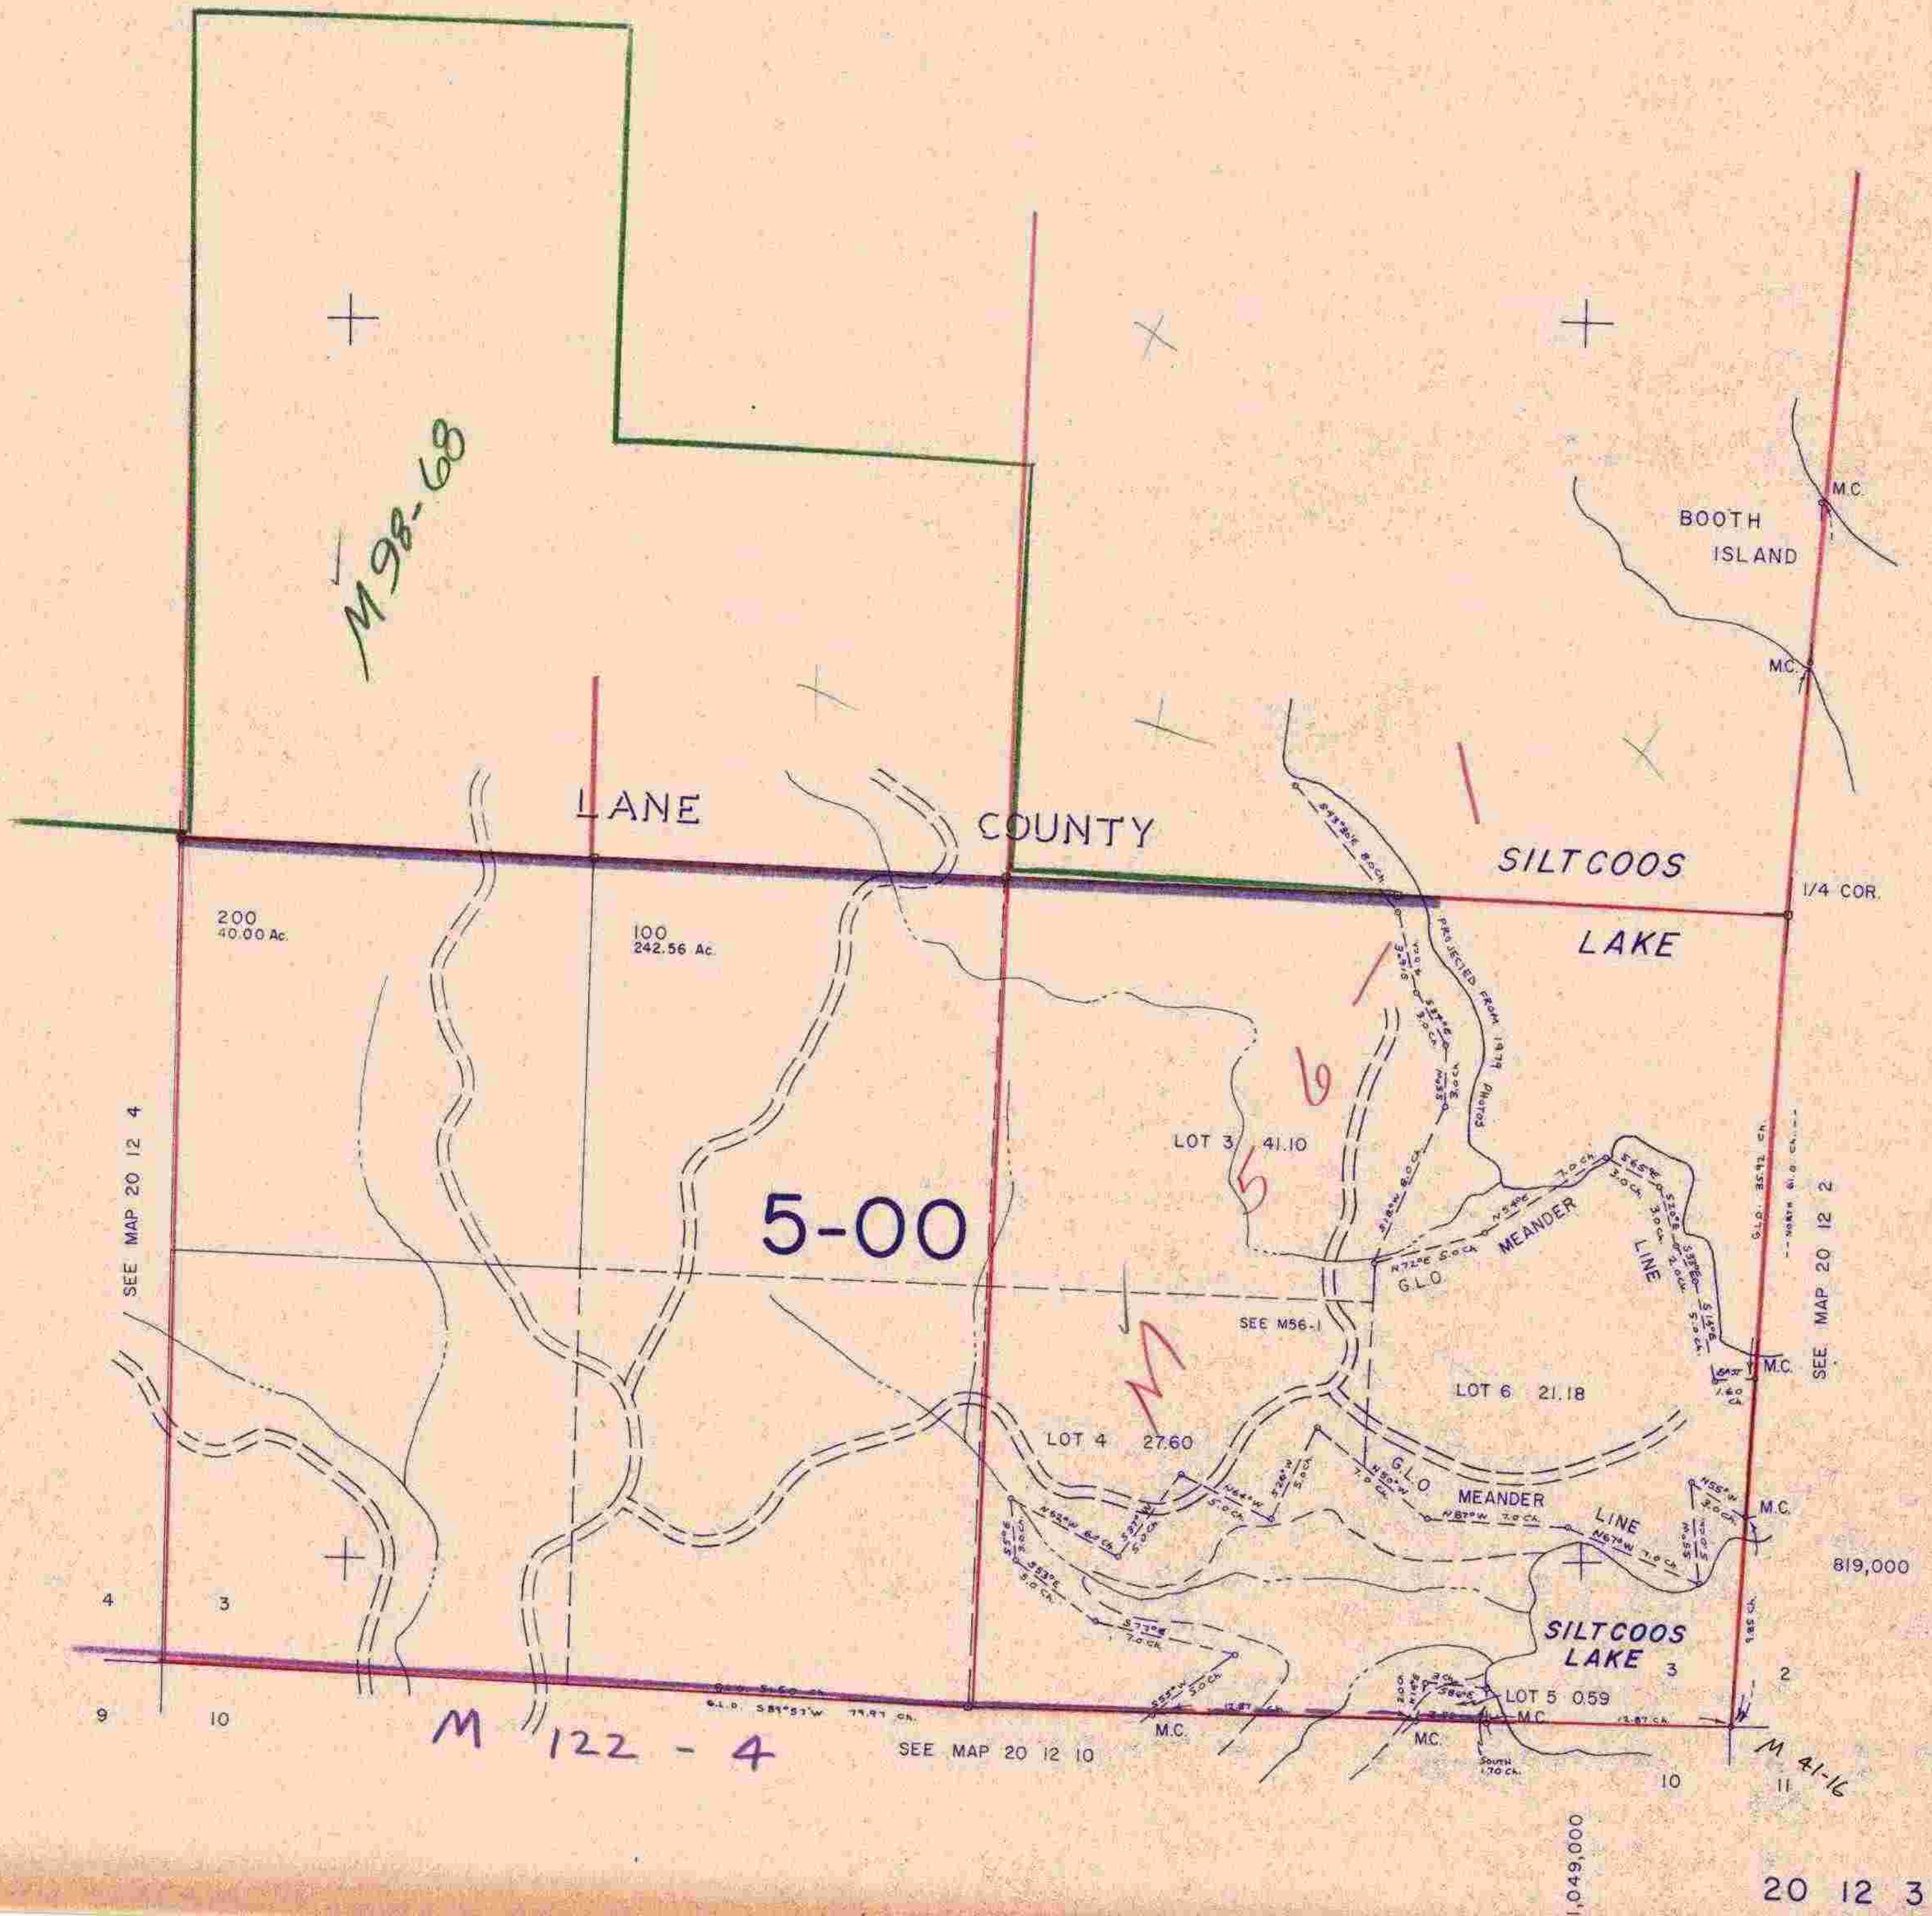

20 12 3

3/10/31