


SECTION 11 T.20S. R.12W. W.M.
DOUGLAS COUNTY

20 12 11
& INDEX

THIS MAP WAS PREPARED FOR
ASSESSMENT PURPOSE ONLY.

1" = 400'

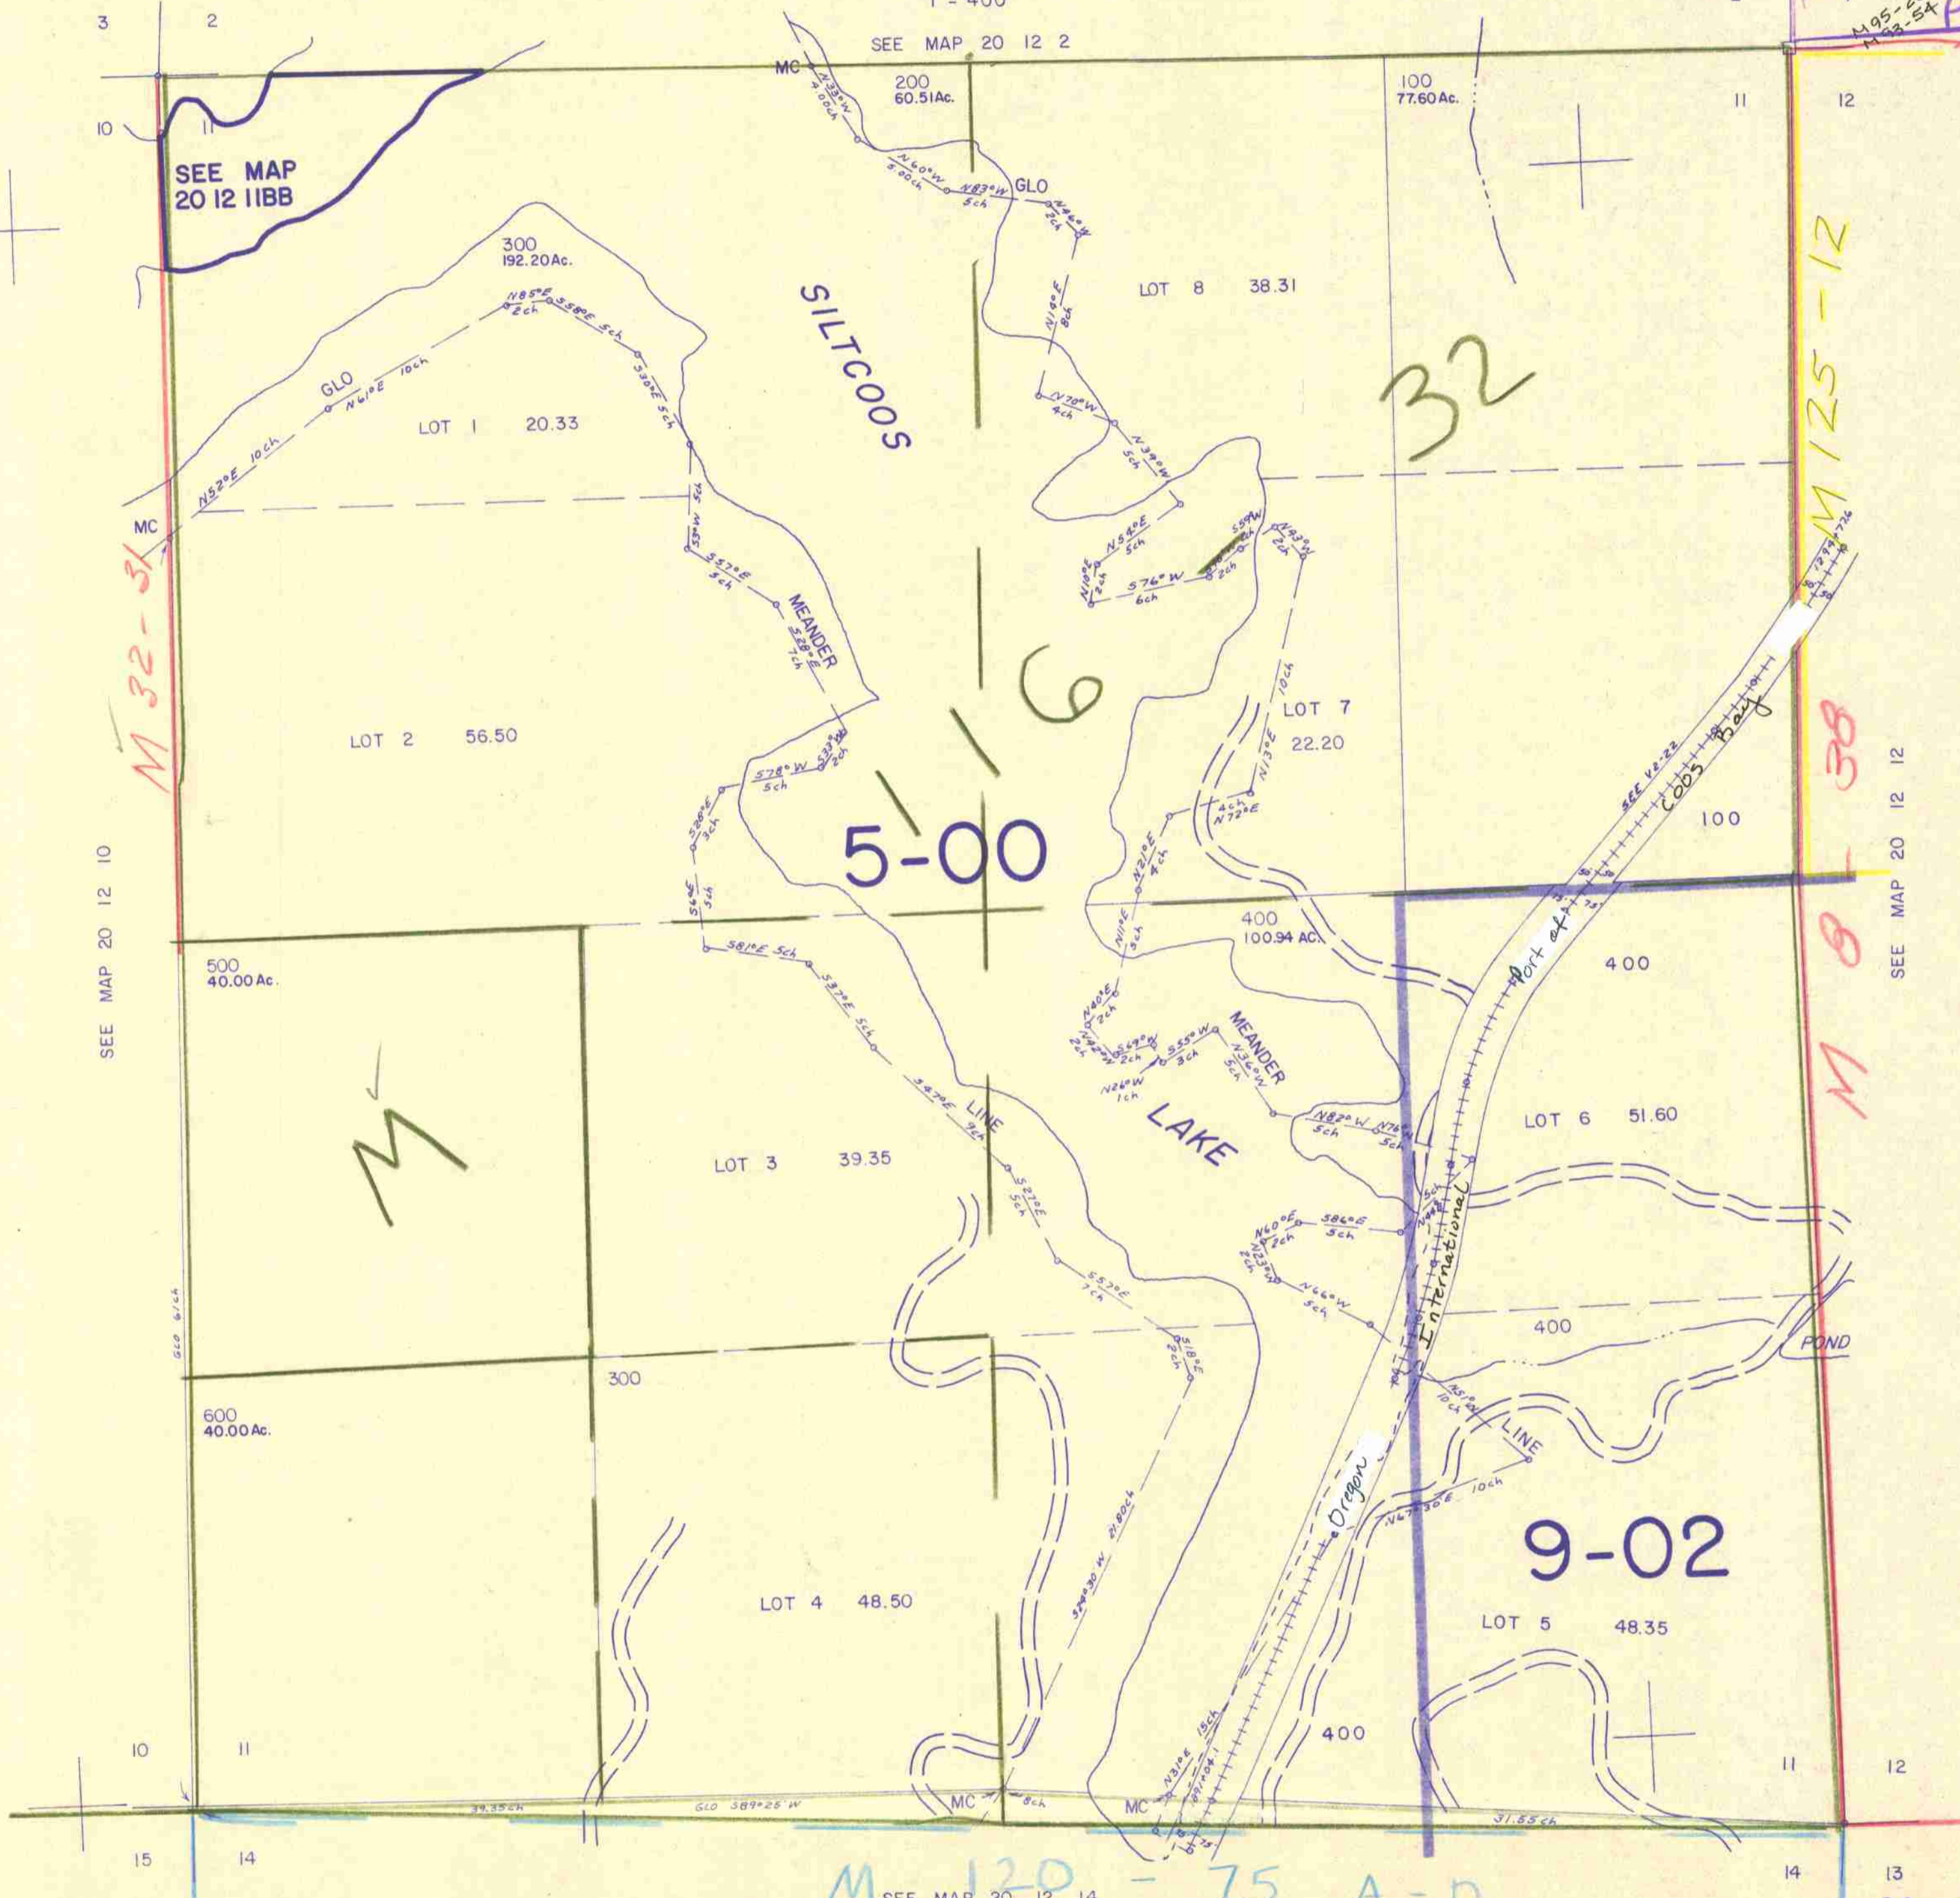

SEE MAP 20 12 10

SEE MAP 20 12 12

M 120 - 75 A - D
SEE MAP 20 12 14

20 12 11
& INDEX

049,000

3/83