THIS MAP WAS PREPARED FOR ASSESSMENT PURPOSE ONLY.

SEC.12 T20S. R.12W. W.M.
DOUGLAS COUNTY

1" = 400'

REVISED ON 7-14-10

20 12 12 & INDEX
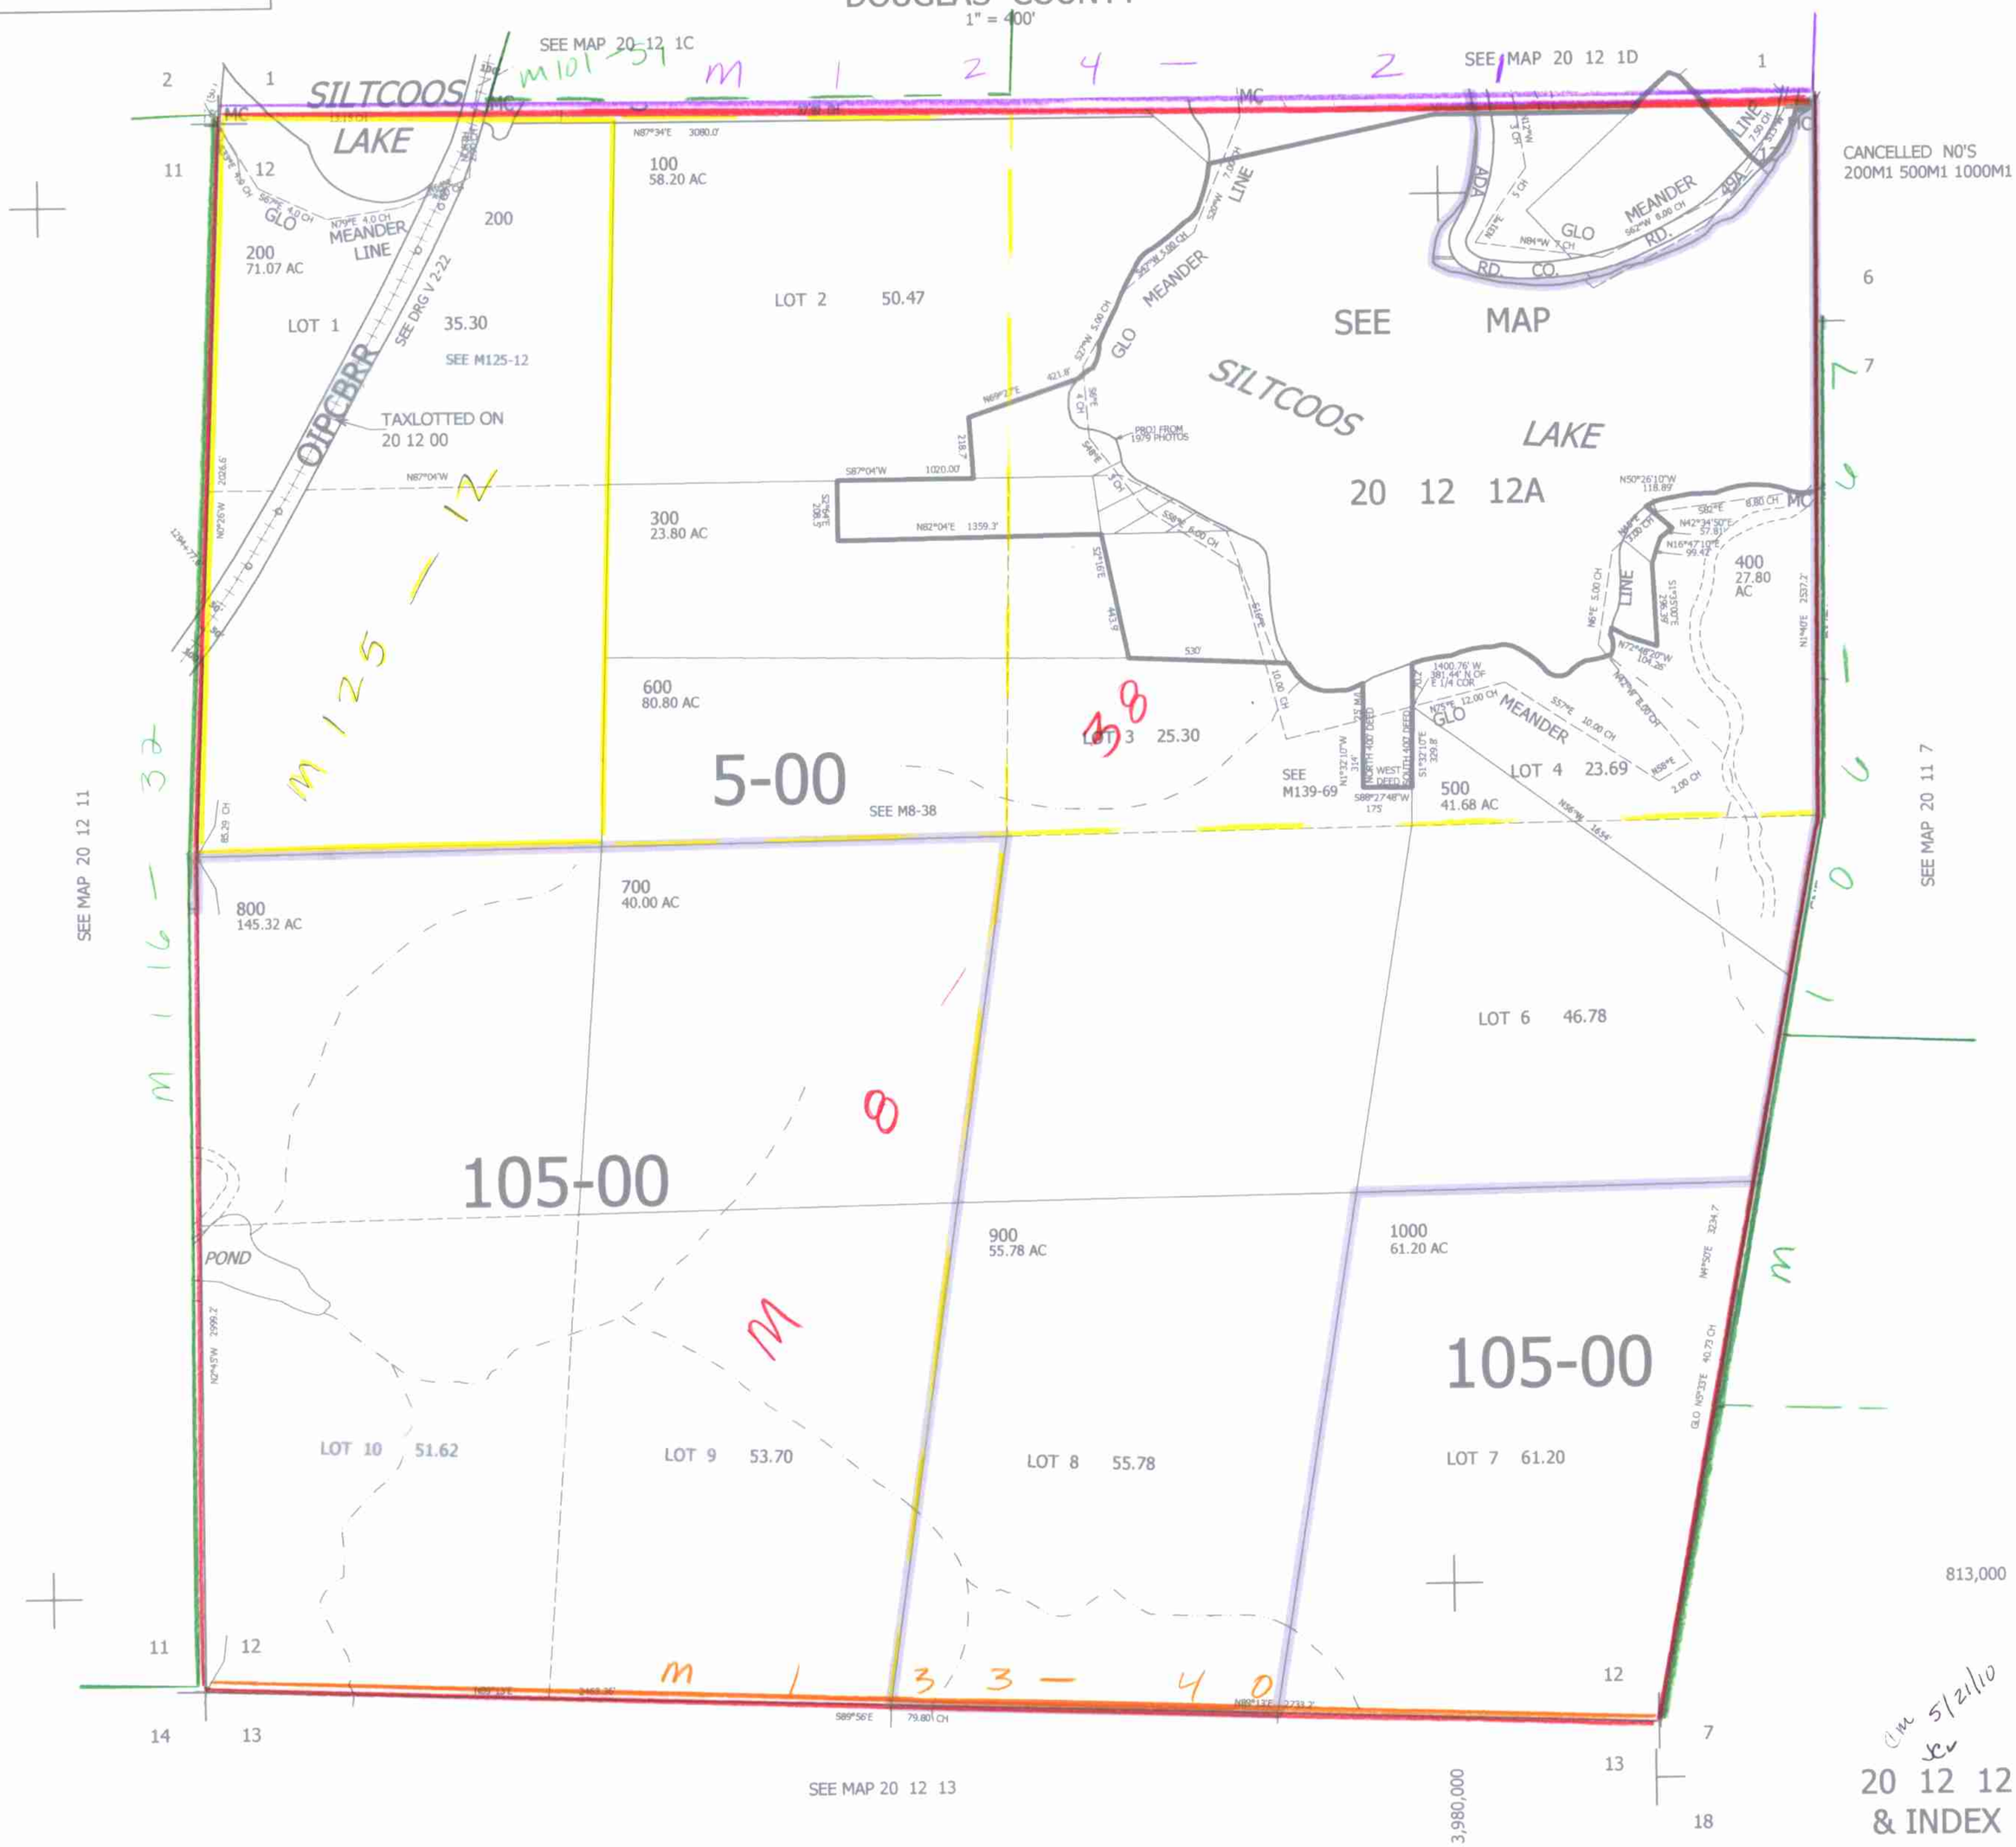
CANCELLED N0'S 200M1 500M1 1000M1