SECTION 16 T.20 S. R.12 W. W.M.
DOUGLAS COUNTY

1" = 400'

THIS MAP WAS PREPARED FOR ASSESSMENT PURPOSE ONLY.

SEE MAP 20 12 9

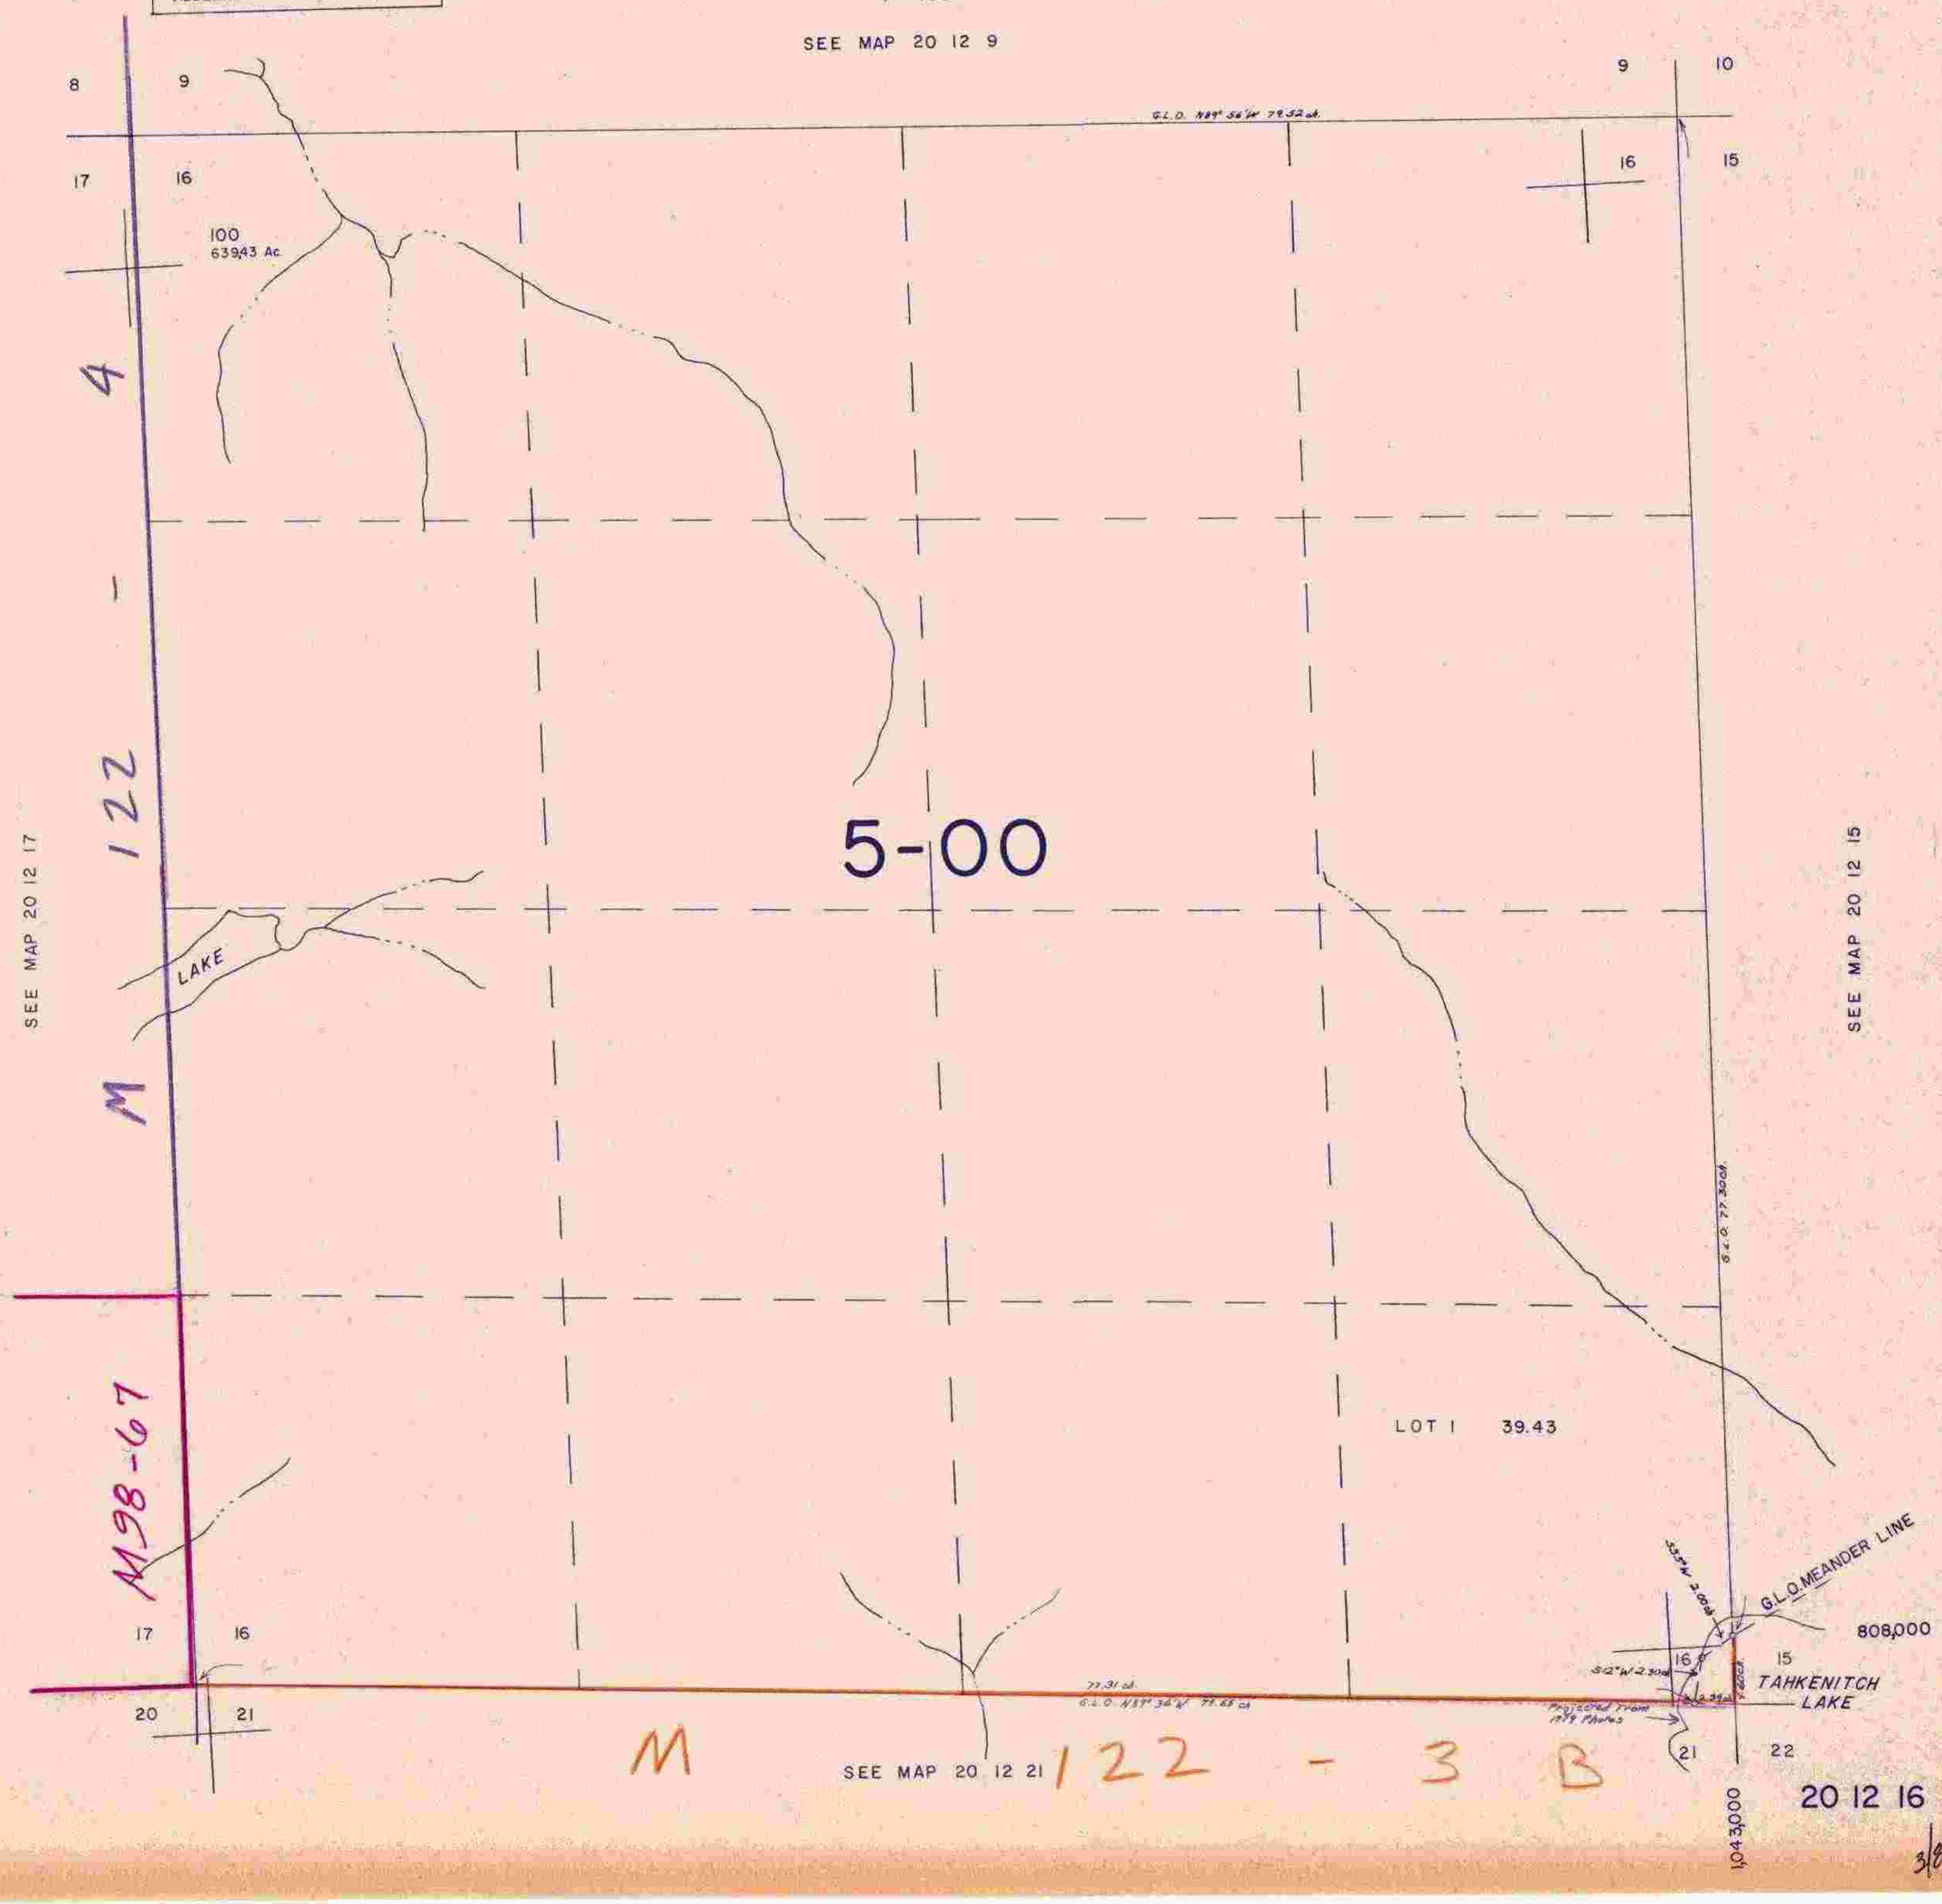

3/83 JH