


THIS MAP WAS PREPARED FOR ASSESSMENT PURPOSE ONLY.

SECTIONS 19 & 20 T.20S. R.12W. W.M. DOUGLAS COUNTY

1" = 400'

20 12 20

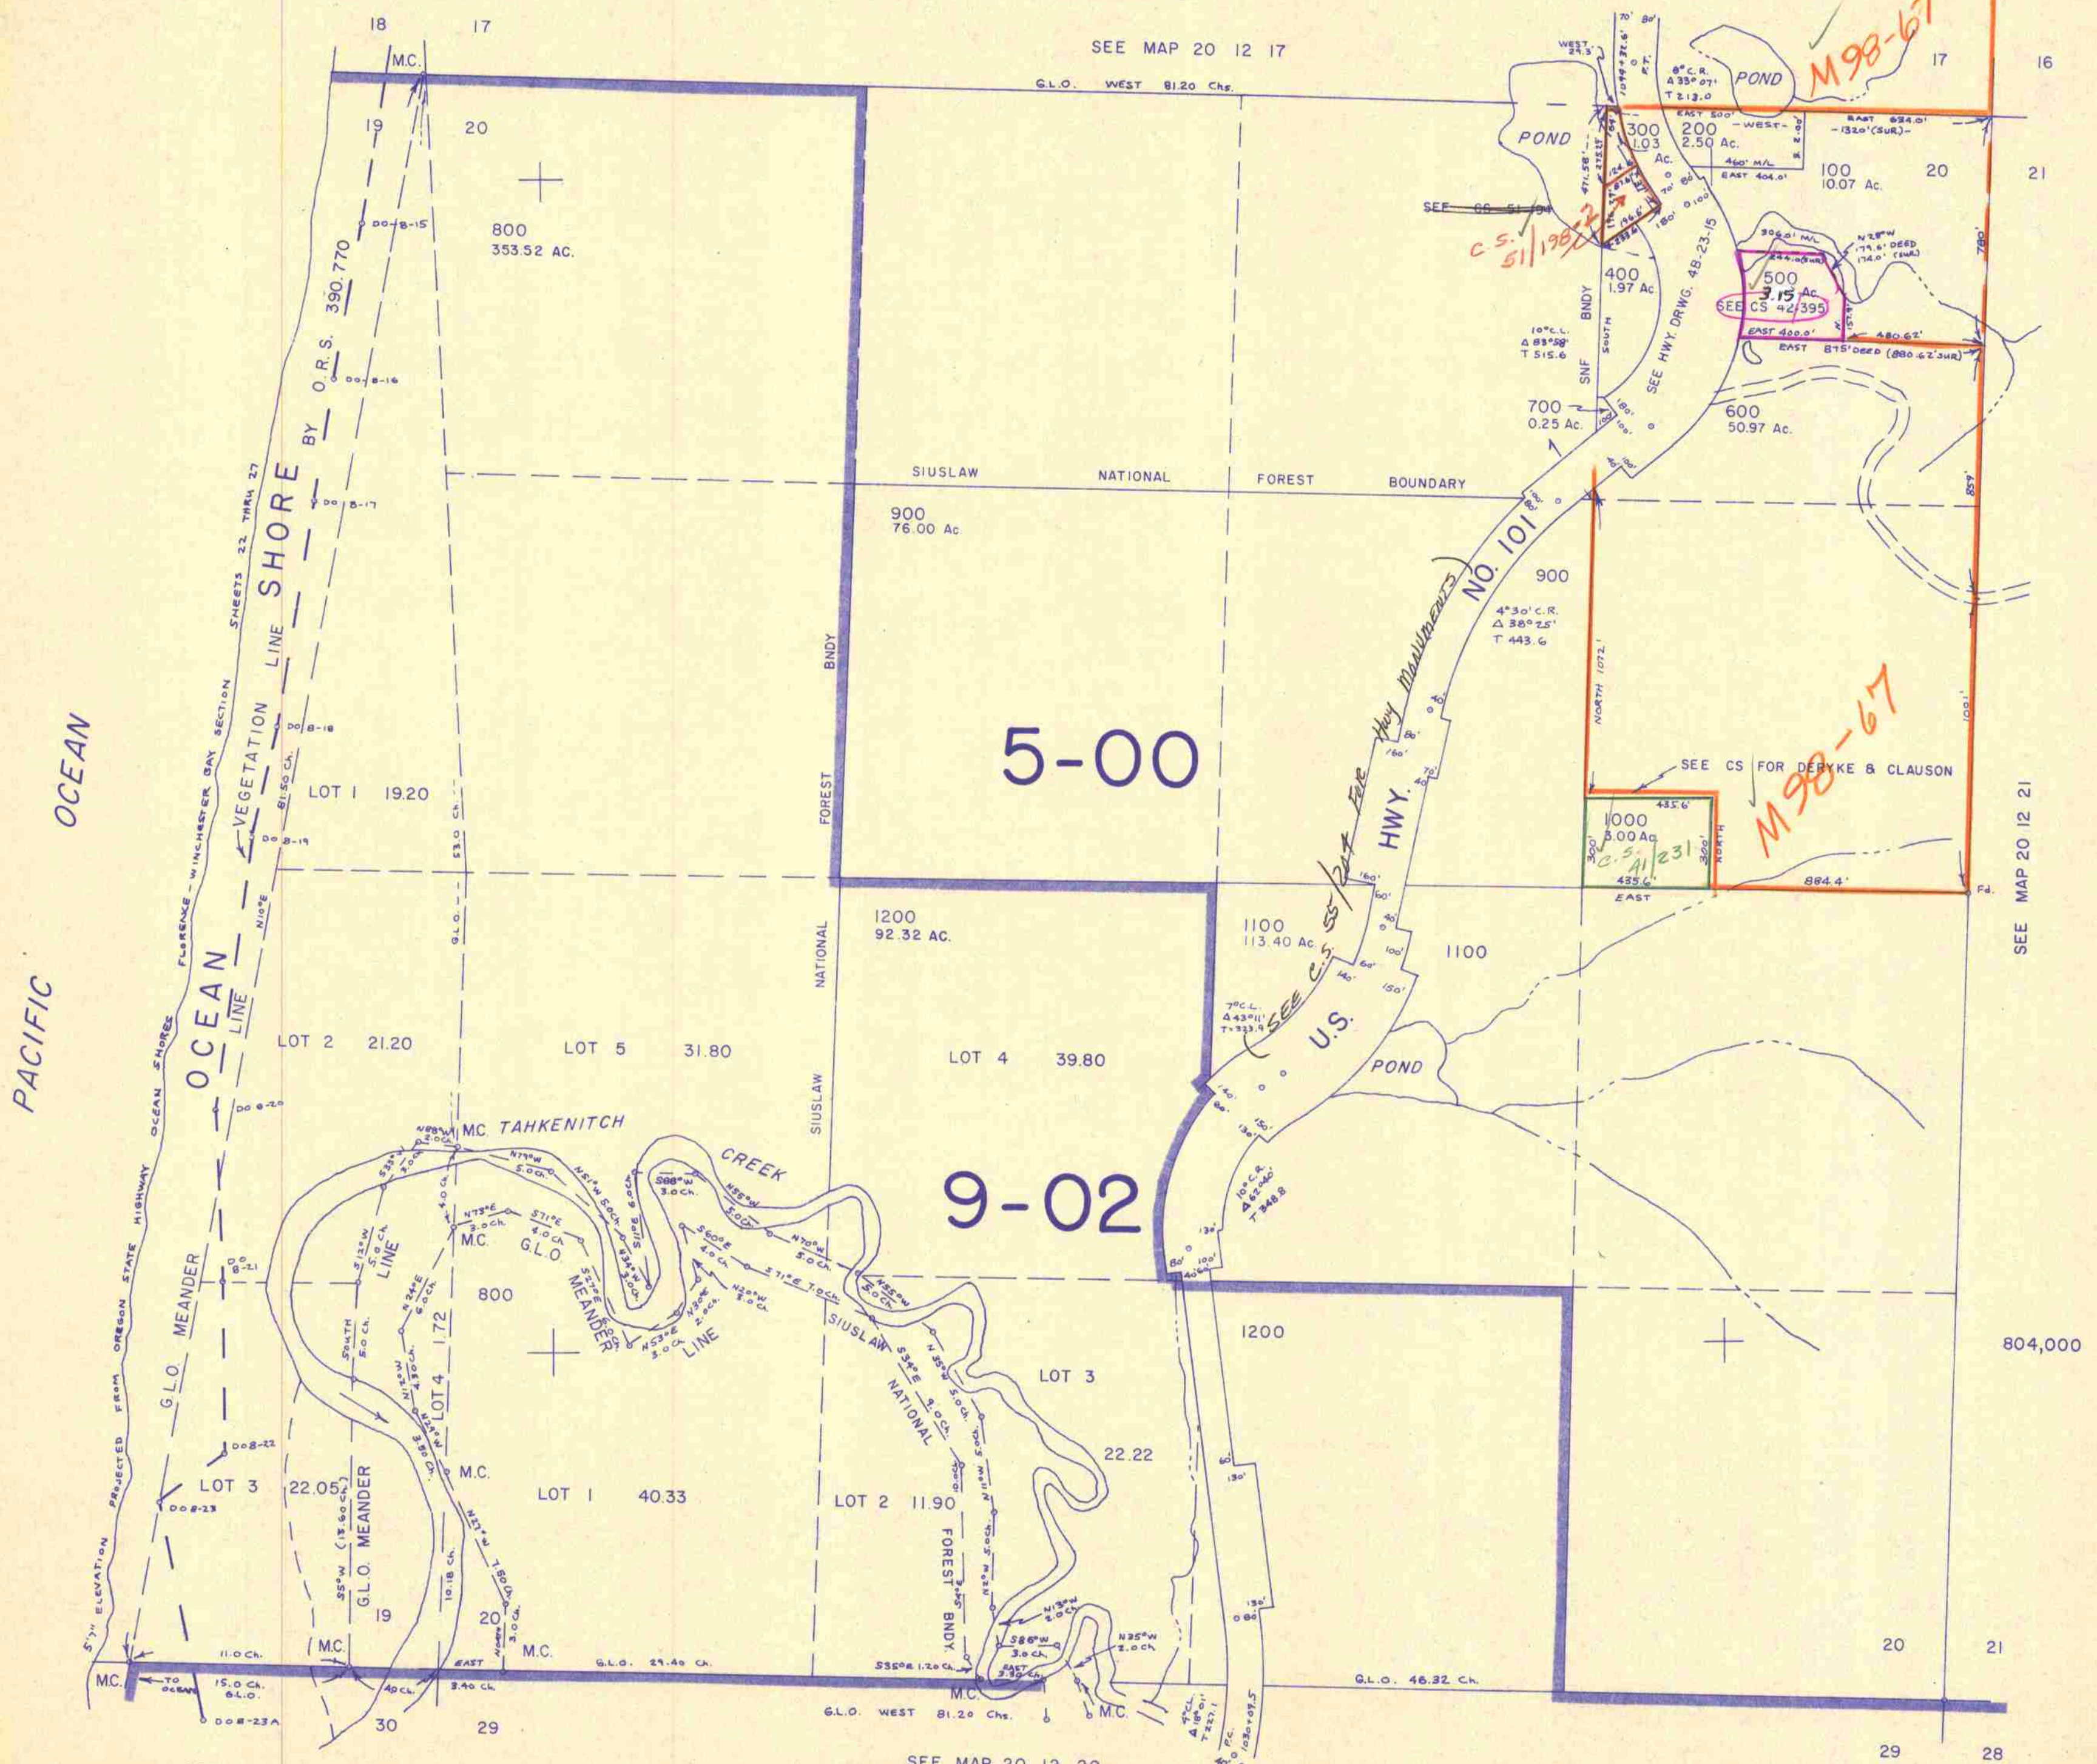

PACIFIC OCEAN

SEE MAP 20 12 30

SEE MAP 20 12 29

SEE MAP 20 12 21

20 12 20

1,038,000

19

3/8/38